

LEASED FROM
CAMBRIA COUNTY COAL CO
ROYALTY \$10 PER TON

LOGAN COAL COMPANY

MAP OF N° 2

WAGNER MINE

BEAVERDALE PA.


Scale: 1 inch = 400 feet.

January 1912.

ANDREW B. CRICHTON, ENG.

JOHNSTOWN PA.

'B-SEAM'

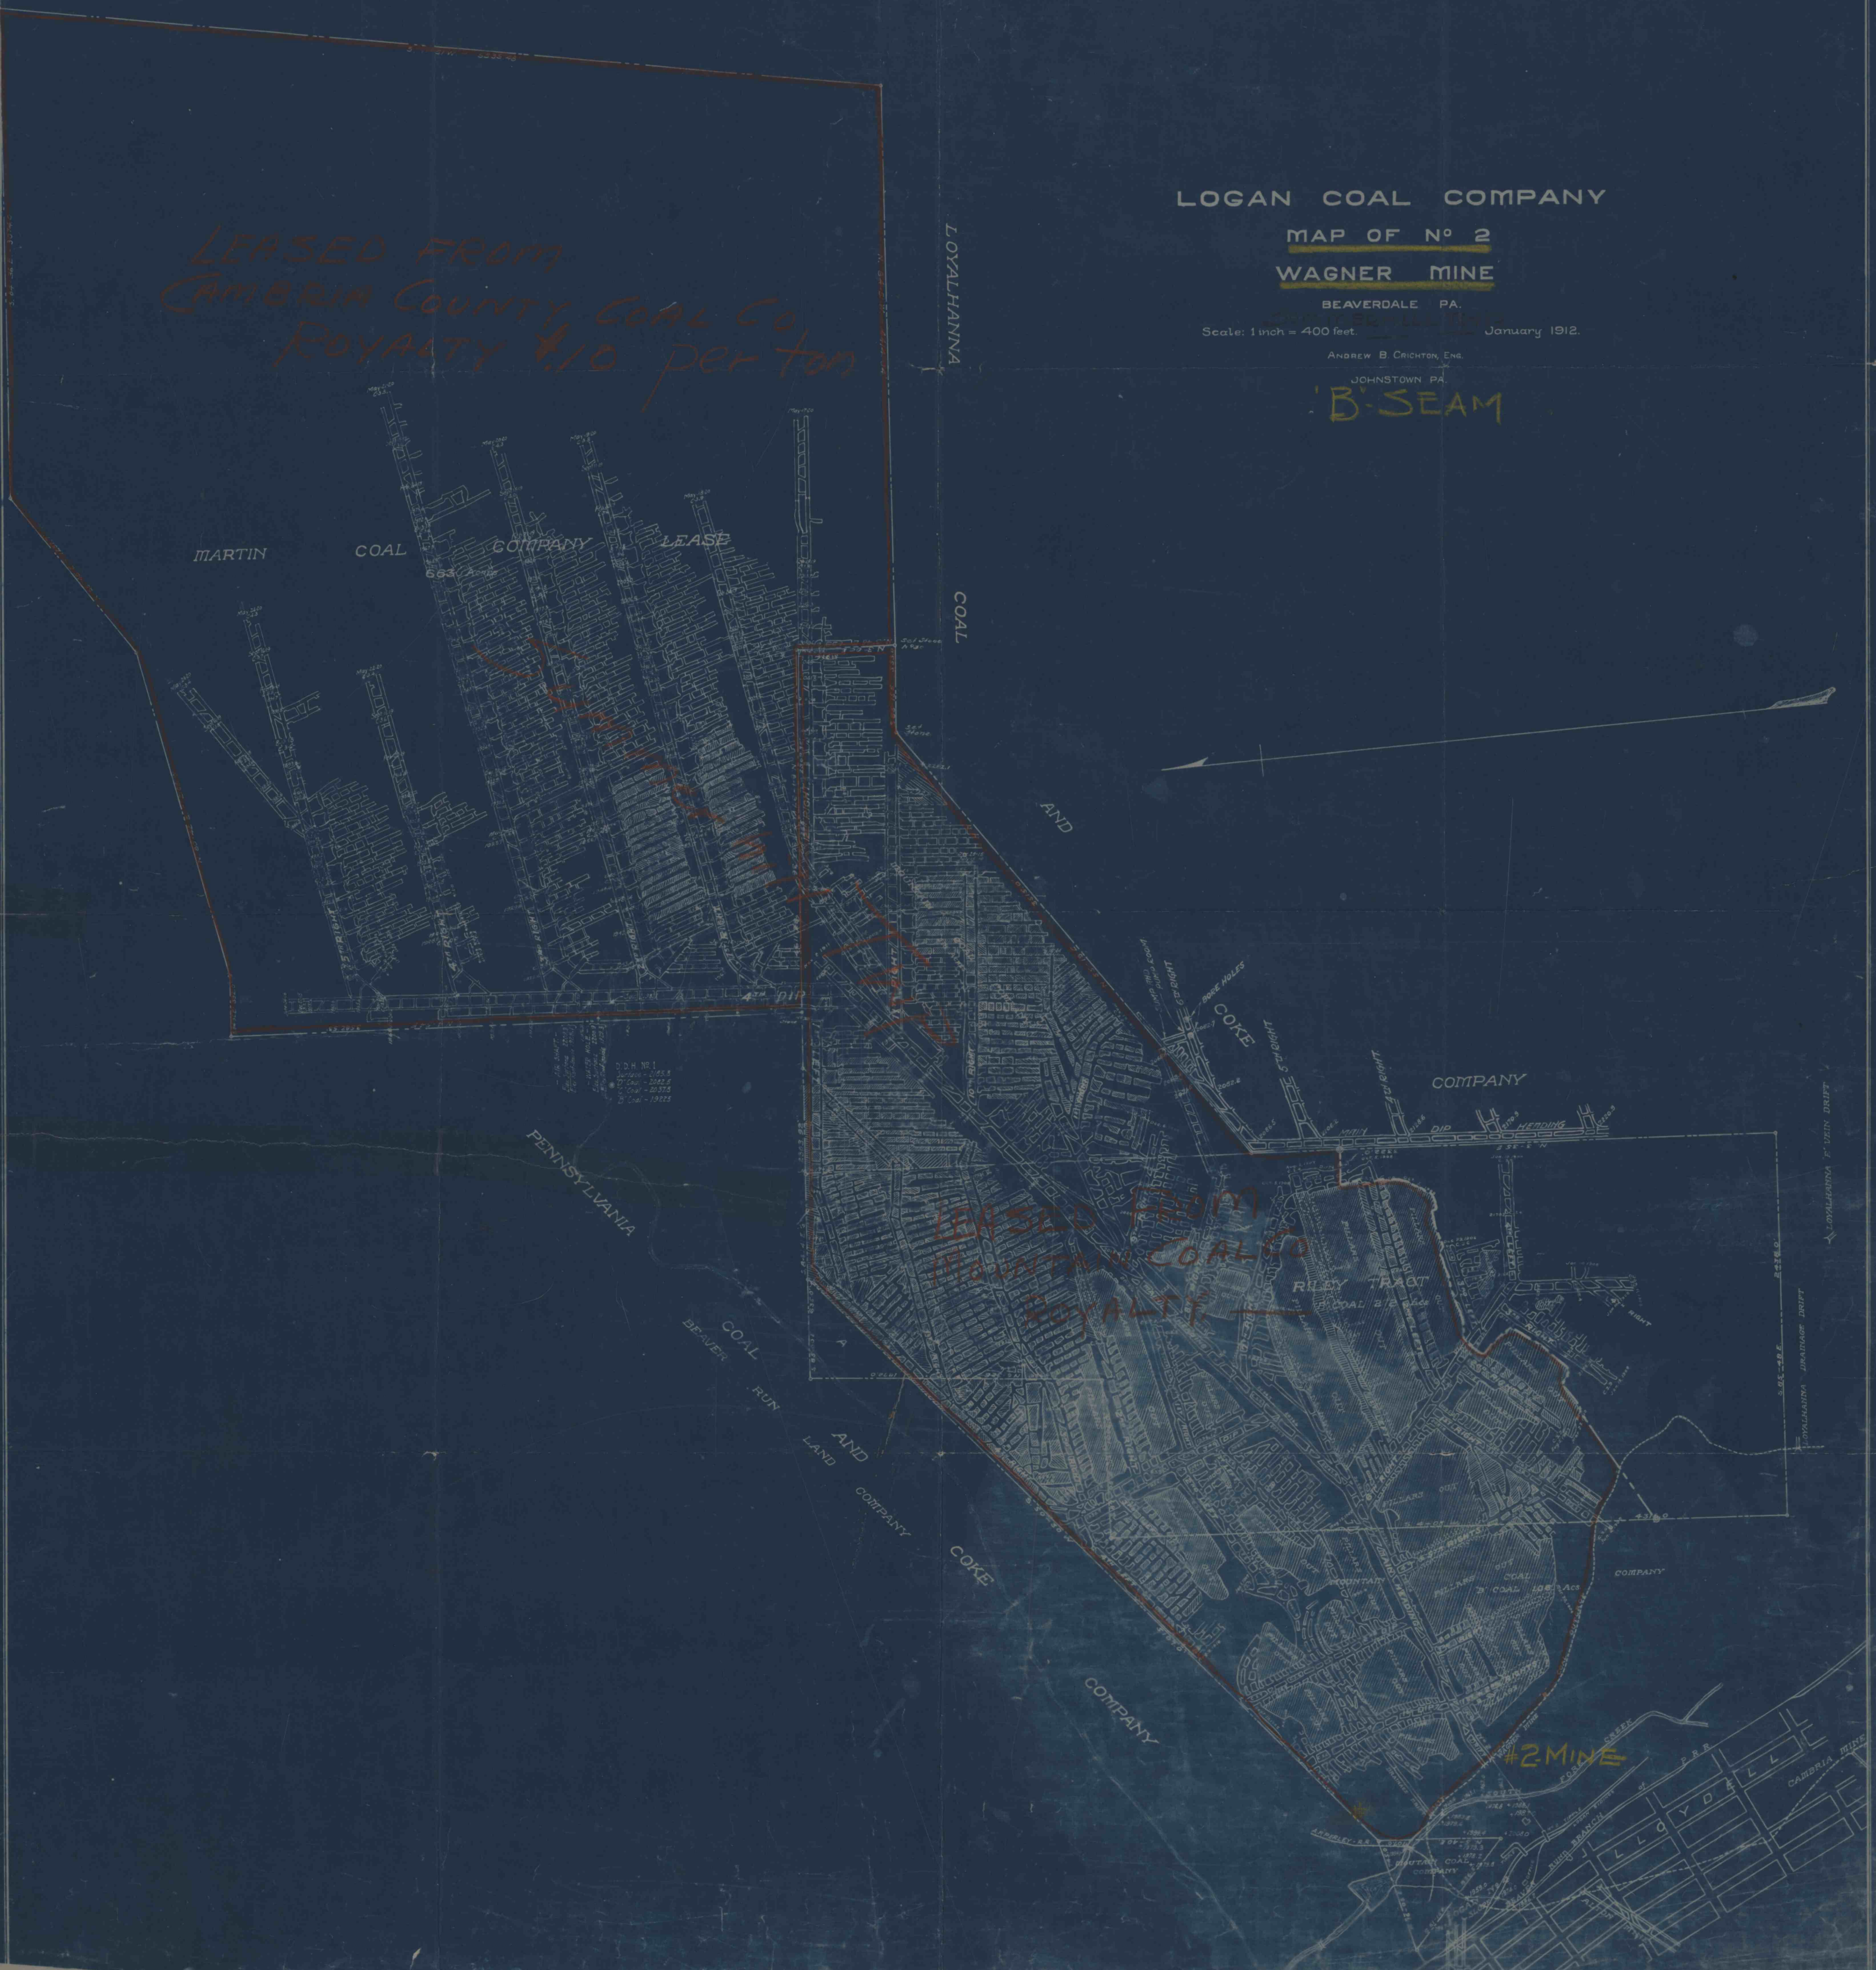

CHAS. H. WELLS
ENGINEER
JOHNSTOWN PA.
1912

SEE SEE
LOYALHANNA WAGNER DRIFT


