

LEGEND DATE OF SURVEYS


LETTER A IS FOR SURVEY OF FEB 1910

A	Feb 1910
B	Aug "
C	Feb 1911
D	July "
E	Feb 1912
F	Aug "
G	Aug "
H	Aug "
MAP SHOWING
PROPERTY & MINING OPERATIONS
OF
VALLEY SMOKELESS COAL CO. (ABANDONED)
JOHNSTOWN PA.

SITUATE IN
RICHLAND & STONY-CREEK TOWNSHIPS, CAMBRIA CO.

SCALE 1 INCH = 400 FEET.
1917-18 5-21-79 42079

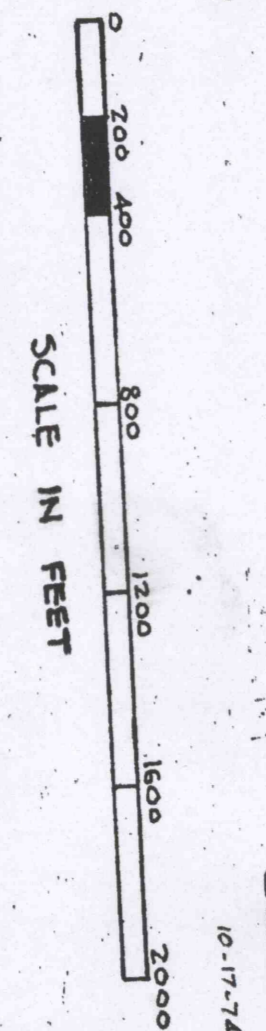

FEB - 7 - 1914

