


MAP

WILLIAM WILSON

Showing Property of
VICTOR COLLIERIES CO. INC.
Situating in
CHEST TWP. CLEARFIELD CO. PA.
Scale 1"=400' H.F. DORN
Eng'r. Nov. 25-1925

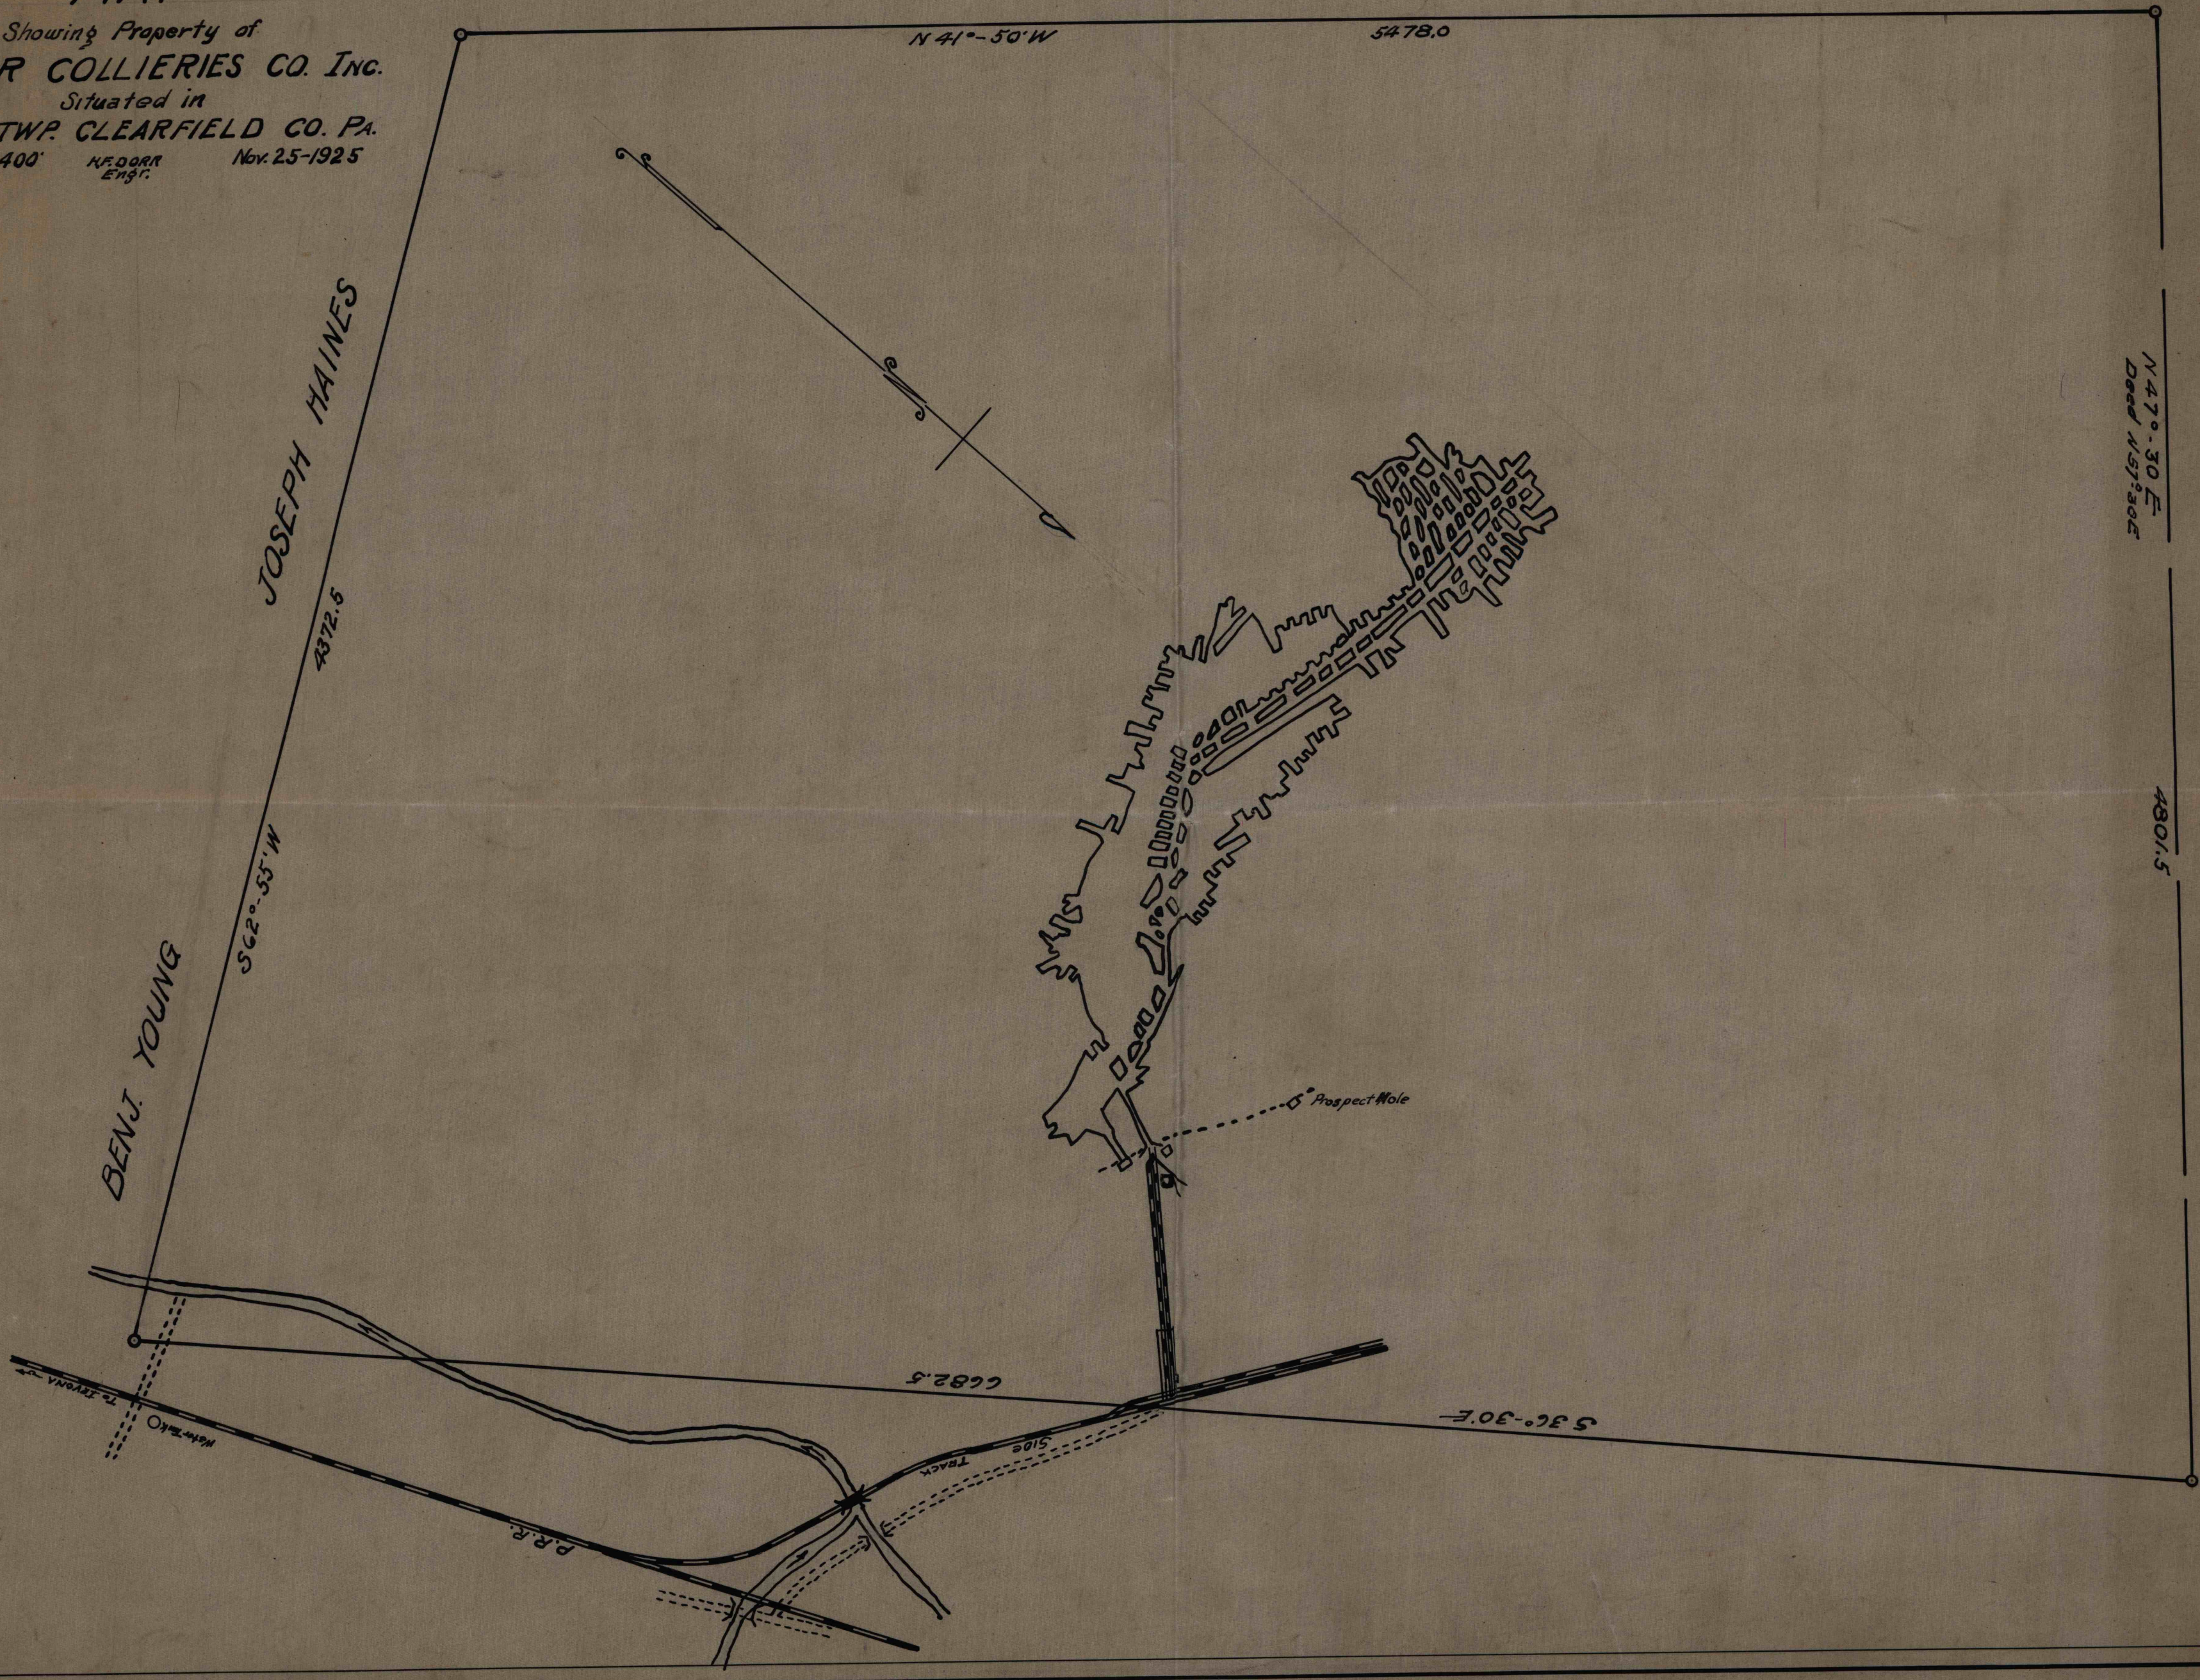

DANIEL LEVY

3891