

Join Sheet No. 3

Join Sheet No. 3

SAMUEL SHEFFLER JOHN P. ST CLAIR

PETER

M. VRESILOVIC
5.9 Acs.


N.W. BRACKEN
55 Acs. - 94.26 Ps.

W. B. GEORGE
196.10 Acs.


STEPH

CRICHTON COAL & COKE CO.
MAP SHOWING
MINE WORKINGS
IN
LOWER KITTANNING OR "B" SEAM
CENTER AND BRUSH VALLEY TWPS.
INDIANA CO. PA.
SCALE 1"=400' OCT. 1966

LEGEND
AREAS OF COMPLETED MINING
SUPPORT AREAS
AREA UNDER LEASE
PROPOSED 6 MONTH MINING

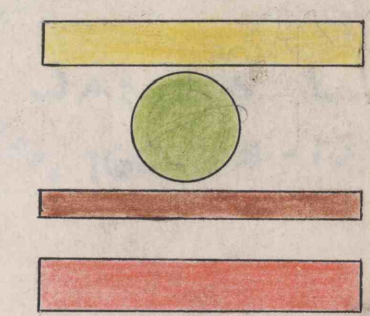

ZACK
Ps.

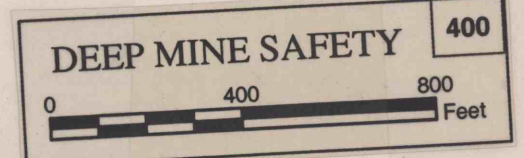

SHEET NO. 2

R.W. WEHRLE
115 Acs.

LAUREL RUN

BIN BELT
BIN
VIBRATOR BELT

JNO. HERRON
55 Acs.

AMANDA KING COMPLETED
44 Acs.

A. REISINGER
42.9 Acs.

MC FEATHERS
109.27 Acs.

A. LORENSICK
21.84 Acs.

A. MC FEATHERS
139.71 Acs.

1343 Acs. 9.46 Acs. 23.32 Acs.

815 Ps.