


Contours
9-2-36
J.G.C.

LOGAN COAL COMPANY MAP OF N° 2 WAGNER MINE

BEAVERDALE PA.
Scale: 1 inch = 400 feet. January 1912.
ANDREW B. CRICHTON, ENG.
JOHNSTOWN PA.

MARTIN COAL COMPANY LEASE
663 Acres

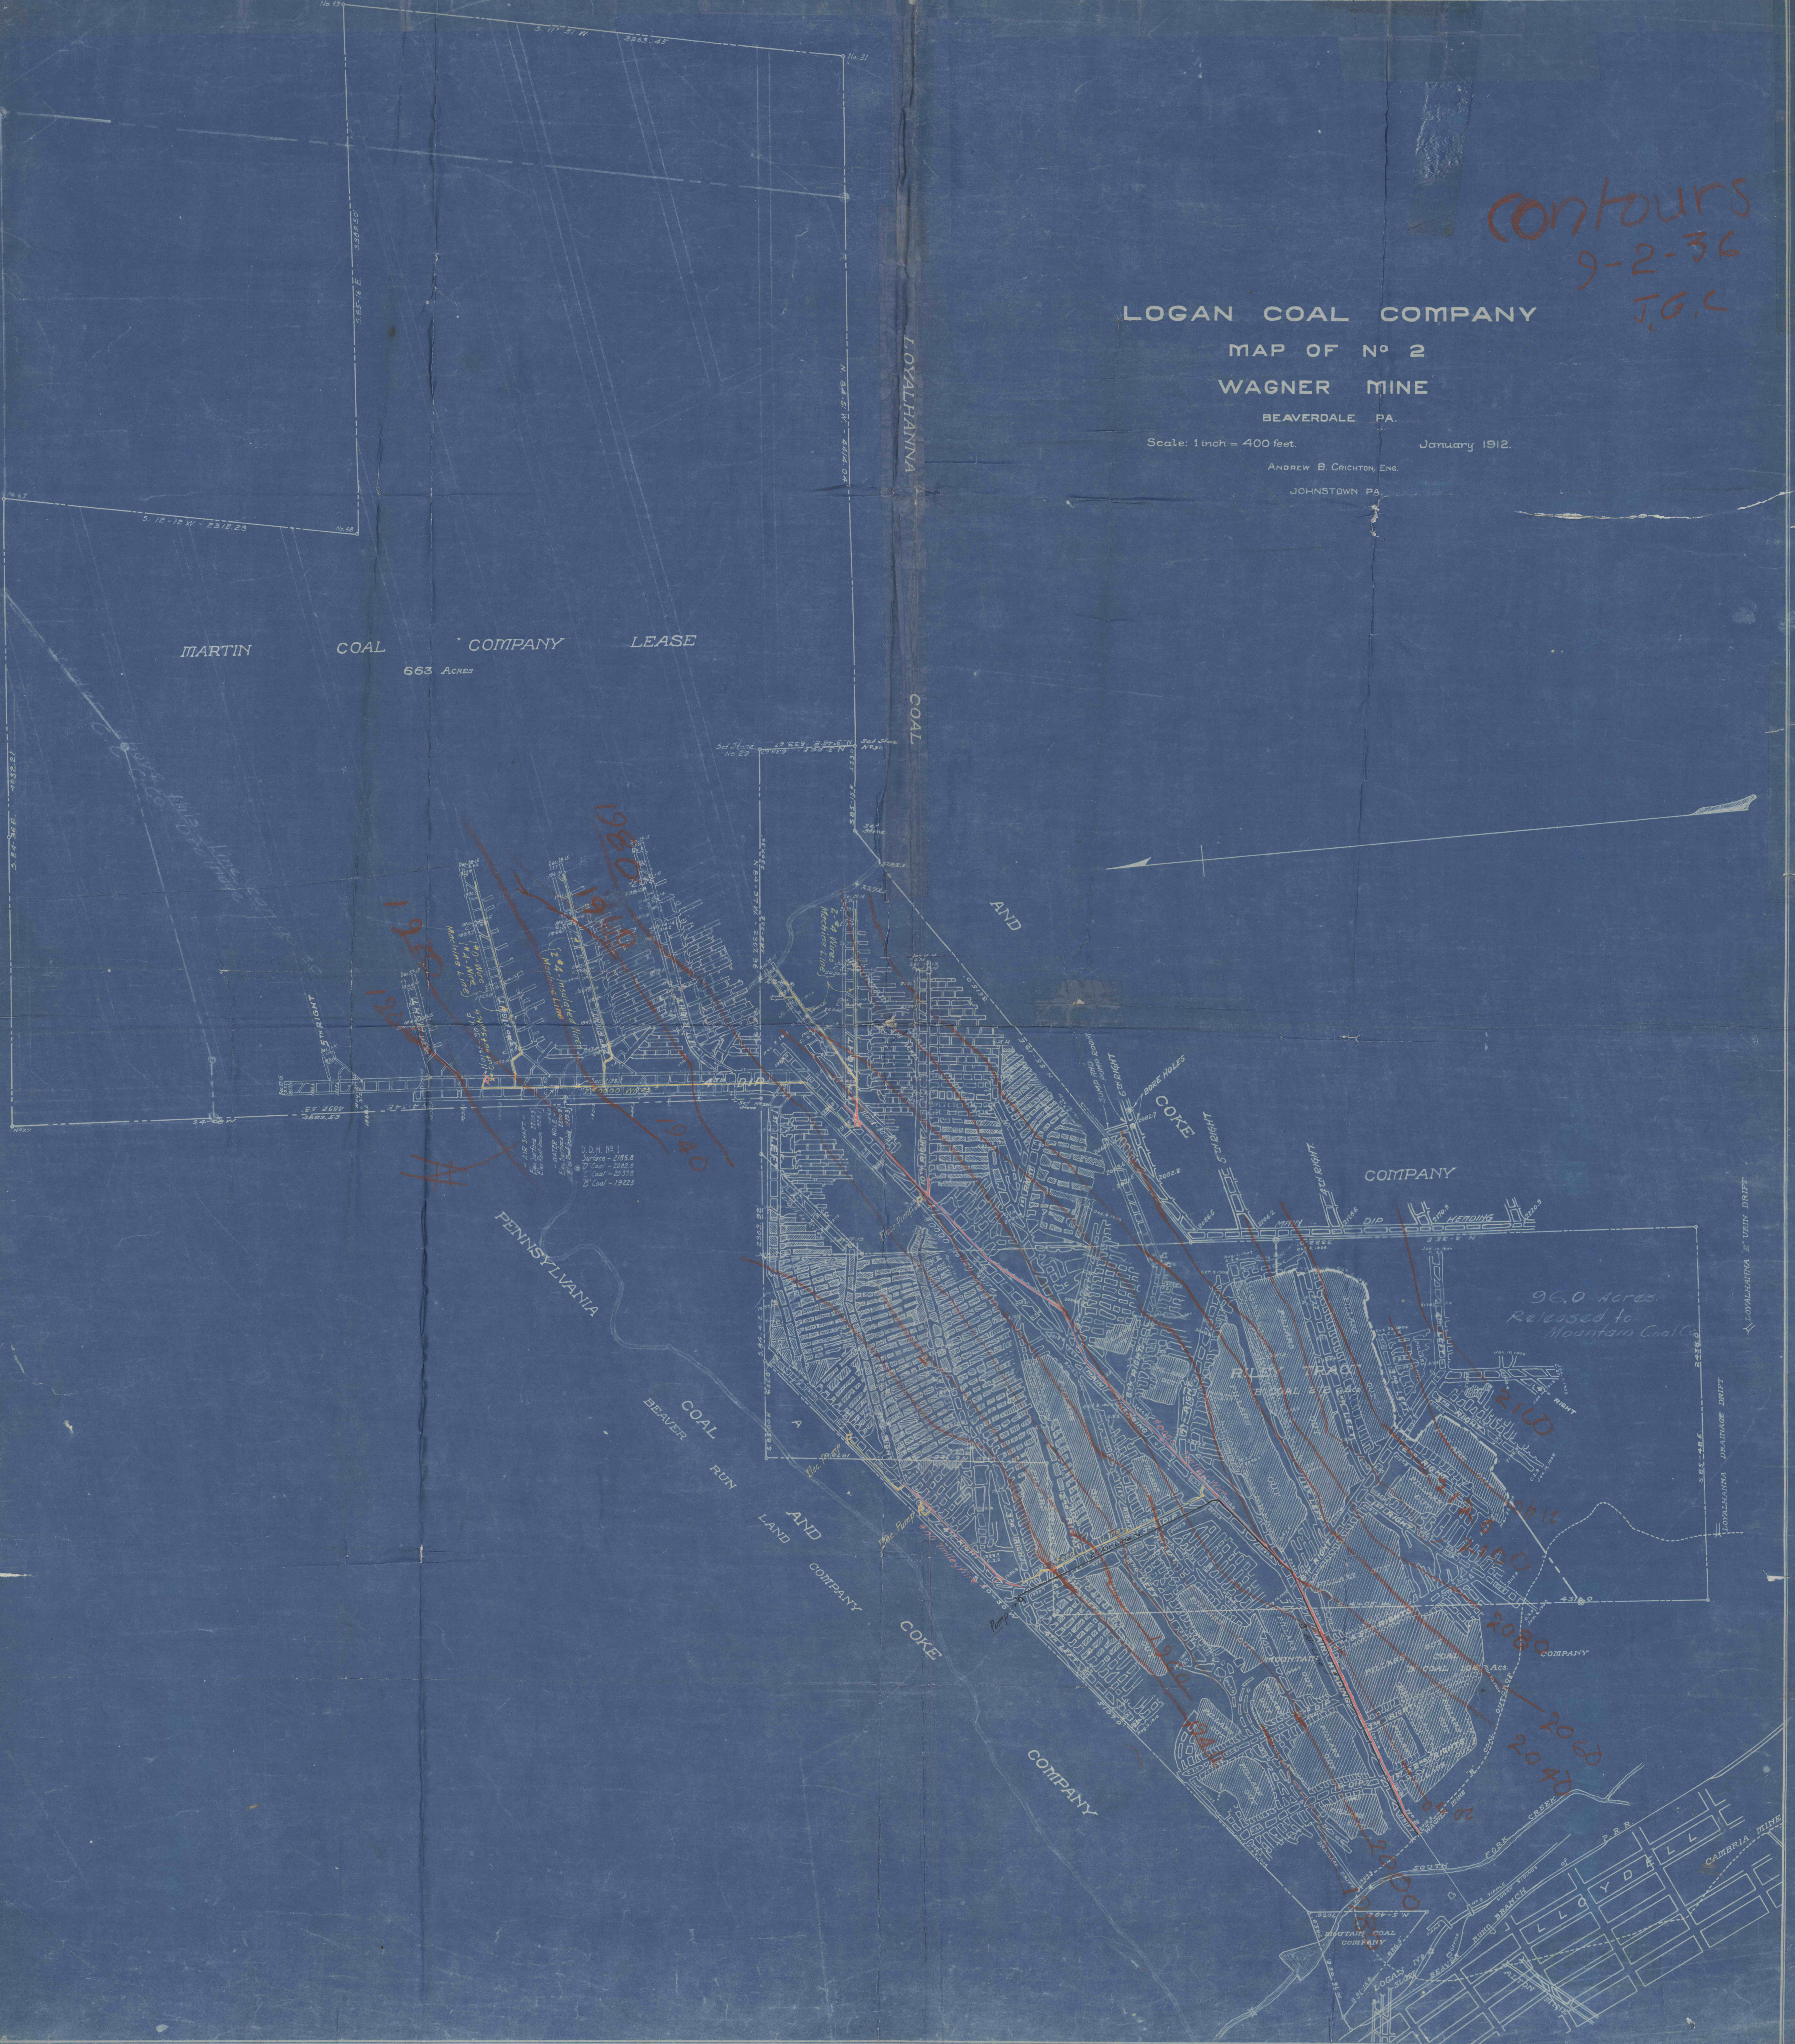

D.H. No. 1

96.0 Acres
Released to
Mountain Coal Co.

2100

2080

2060

2040

2000