


4-10-96
RFA


MARGARET NO. 11 MINE
NO. 2 PORTAL / NO. 3 PORTAL
FINAL MAP

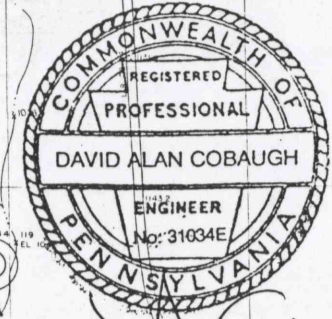

David Coblough

4" WATER MONITORING HOLE

MARGARET NO. 11 MINE
NATIVE UPPER FREEPORT SEAM

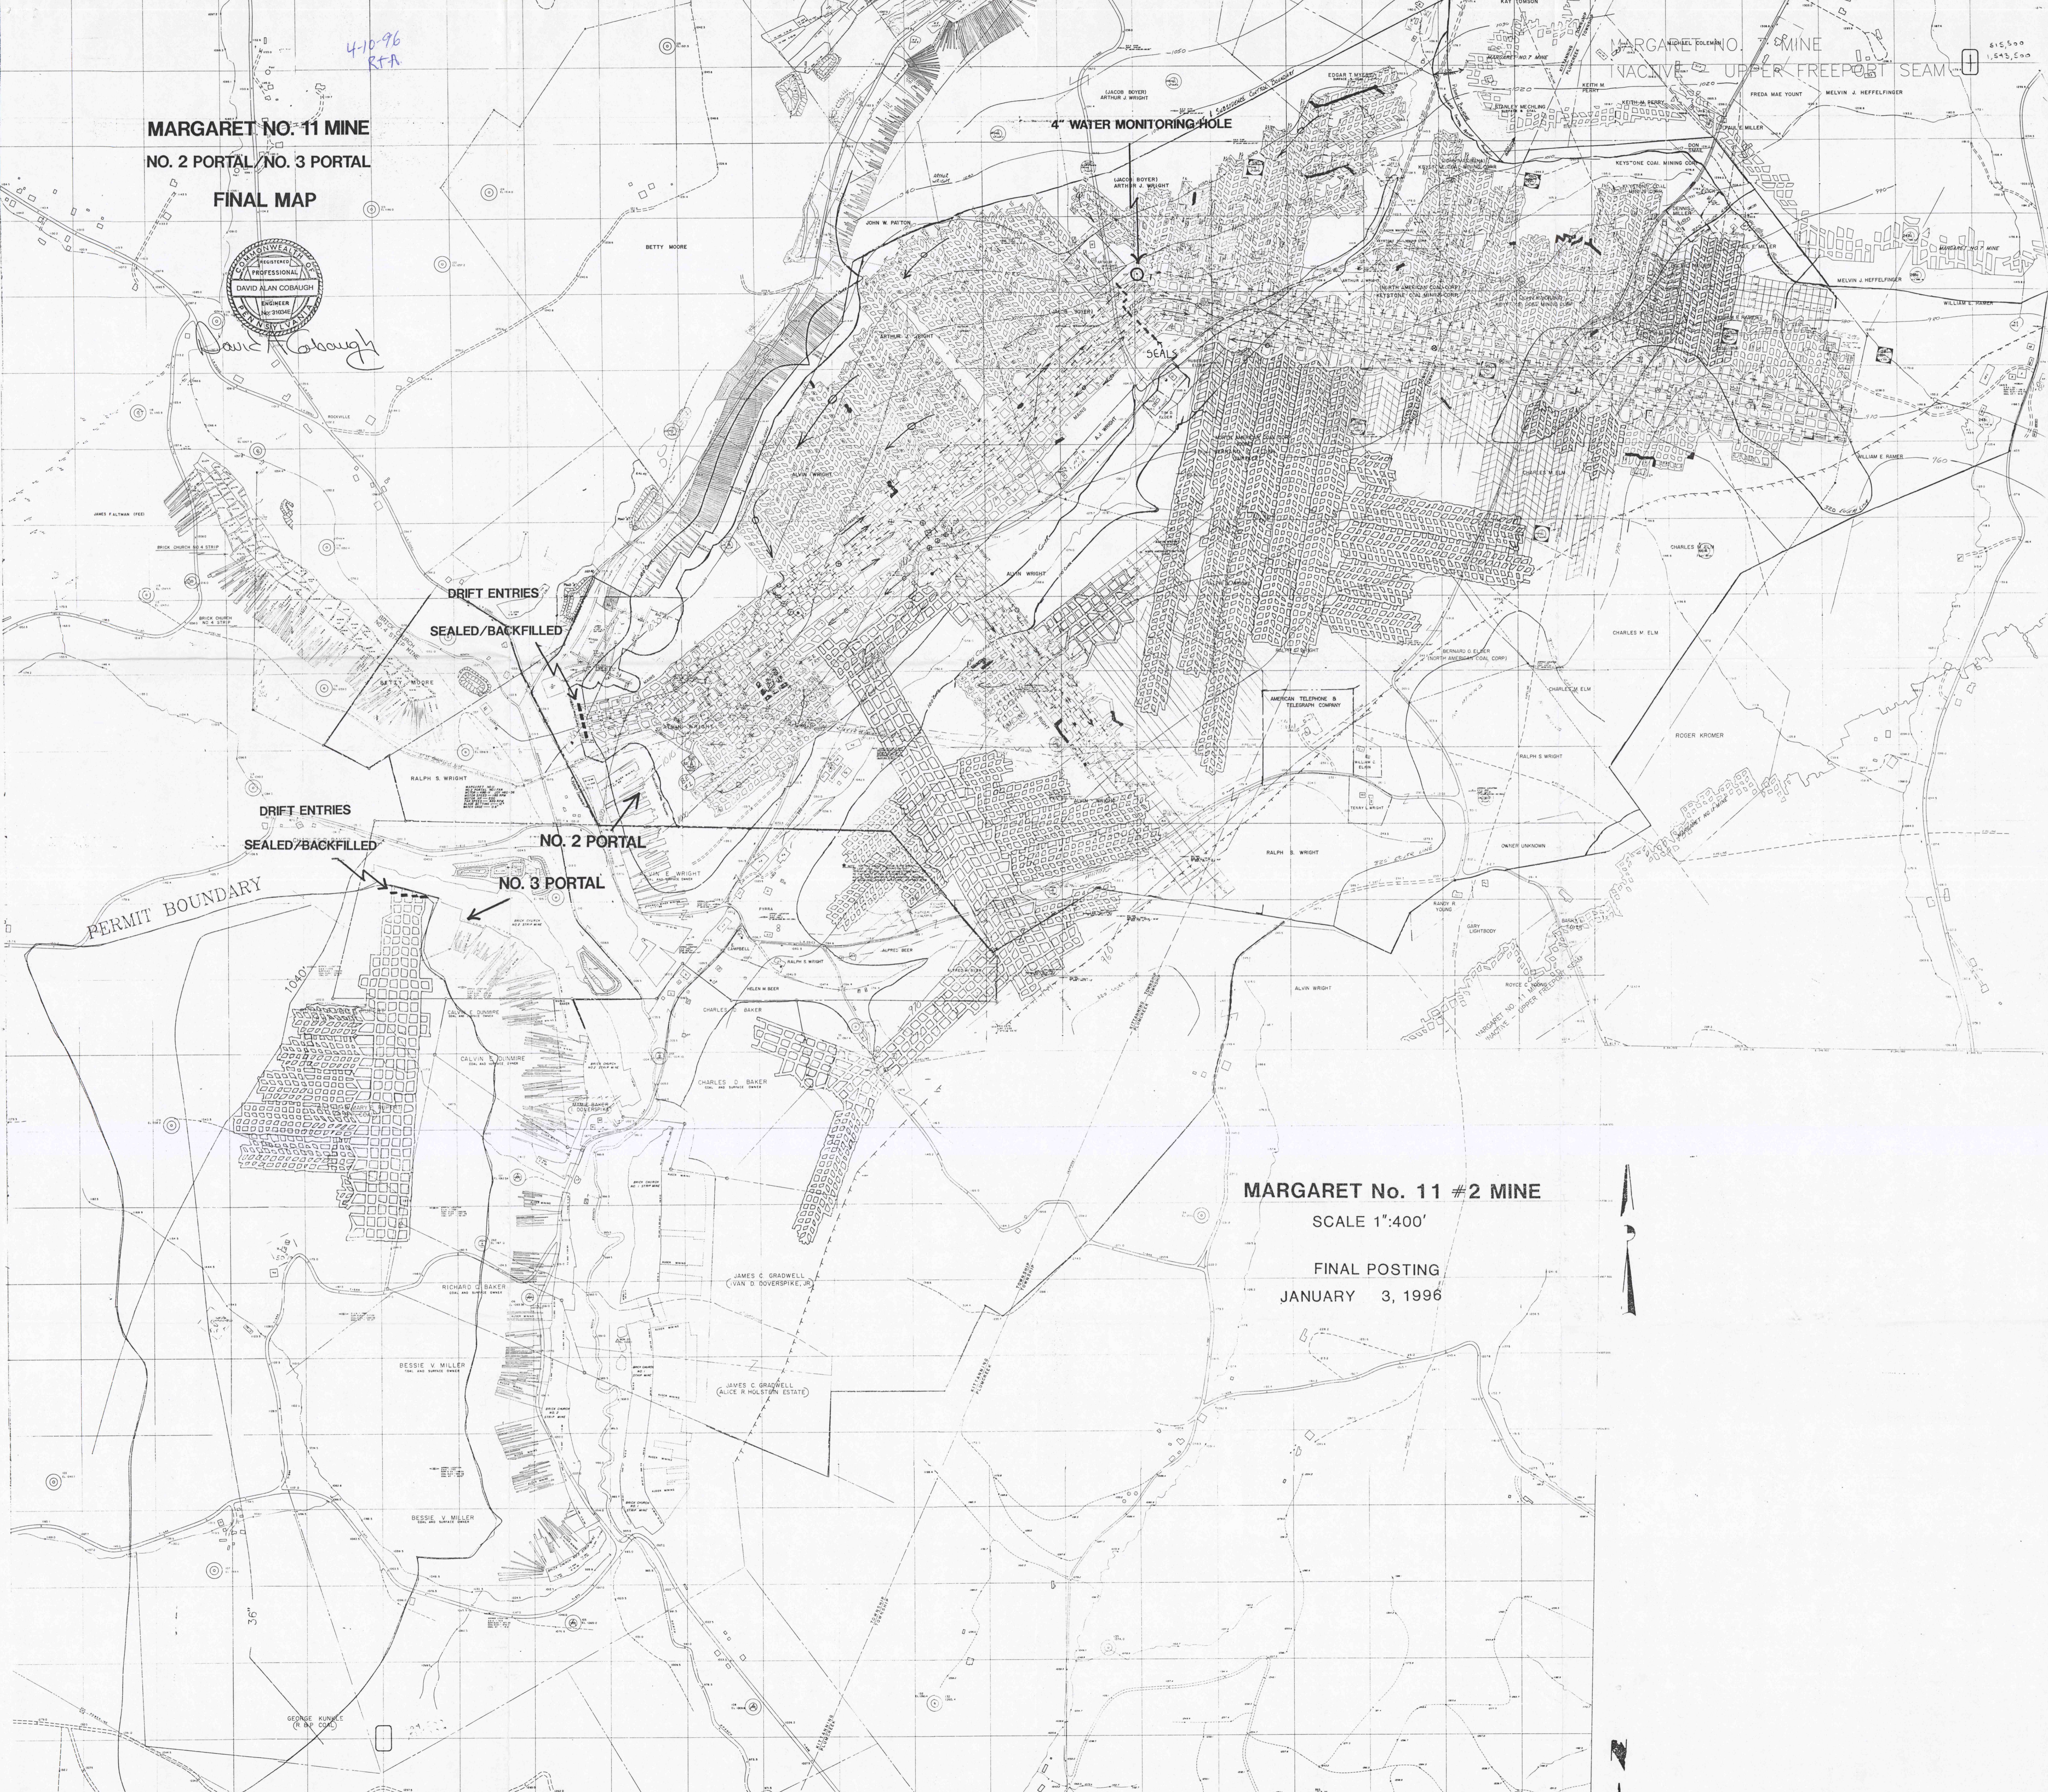

DRIFT ENTRIES
SEALED/BACKFILLED

DRIFT ENTRIES
SEALED/BACKFILLED

NO. 2 PORTAL

NO. 3 PORTAL

PERMIT BOUNDARY

MARGARET No. 11 #2 MINE

SCALE 1":400'

FINAL POSTING
JANUARY 3, 1996

