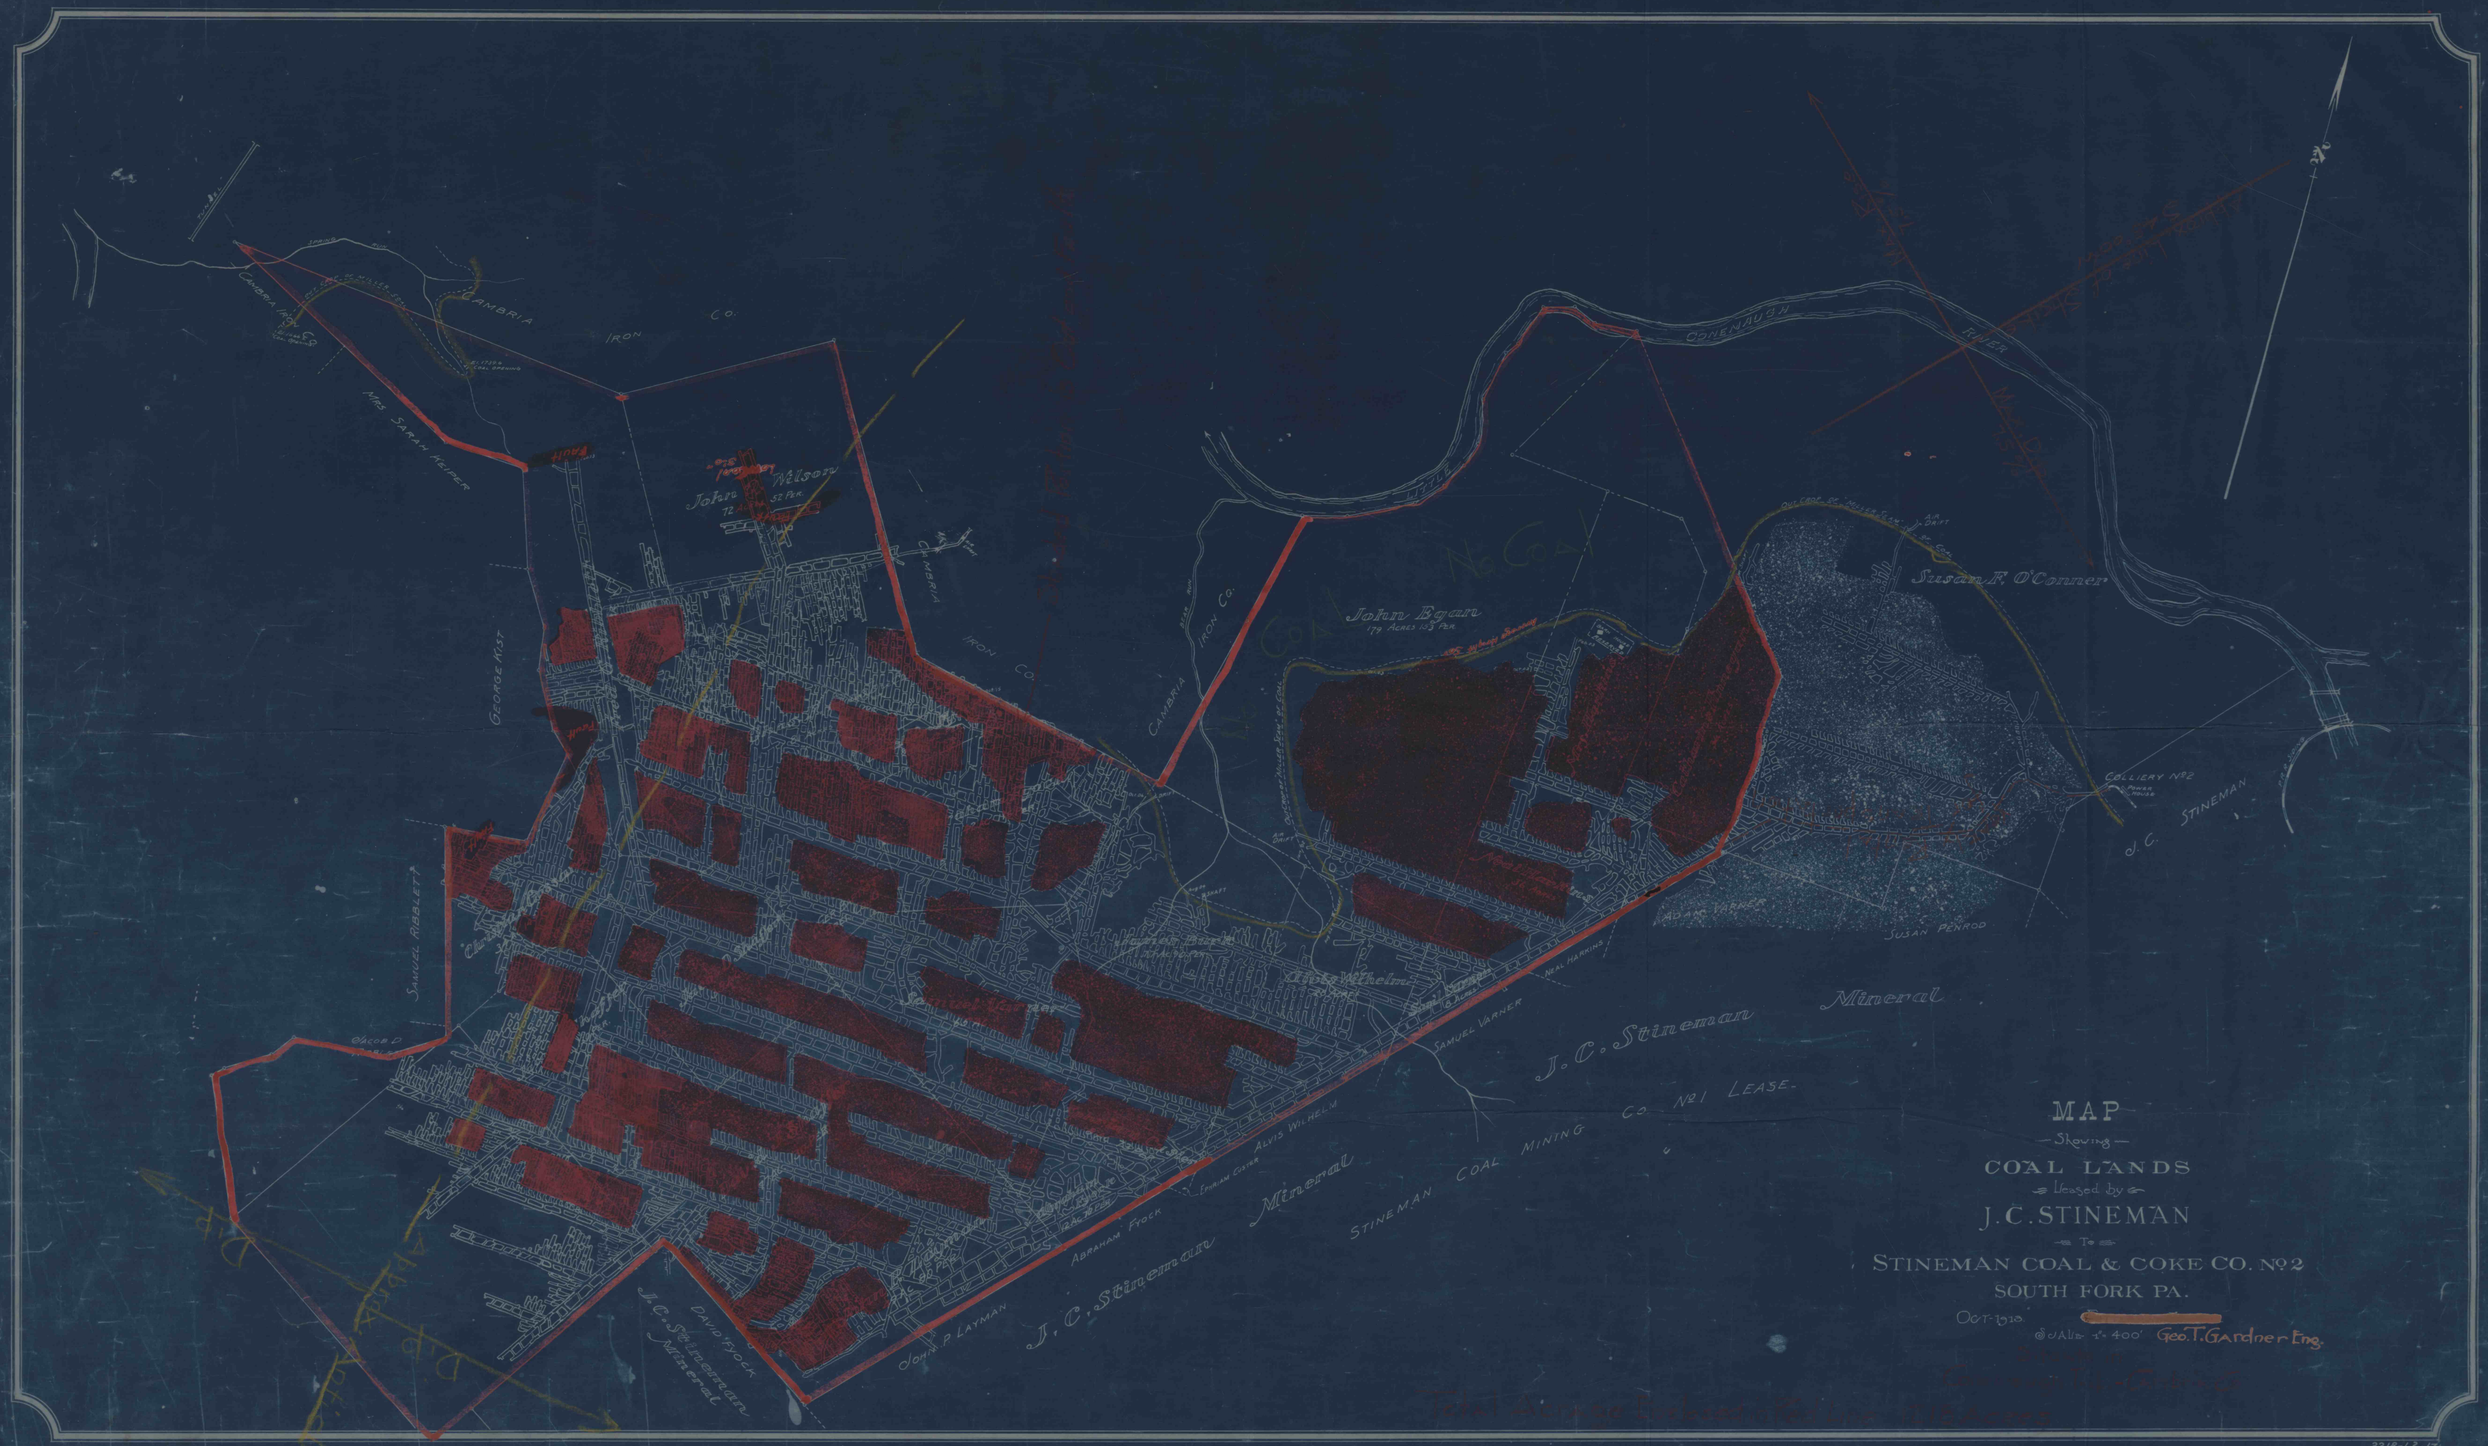
MAP
Showing
COAL LANDS
Leased by
J.C. STINEMAN
To
STINEMAN COAL & COKE CO. No 2
SOUTH FORK PA.
Oct-1910
Scale 1" = 400'
Geo. T. Gardner Eng.
CAMBRIA IRON CO.
MRS. SARAH KEIPER
GEORGE KIST
SAMUEL RIBBLETT
John Wilson
John Egan
179 ACRES 153 PER.
Susan F. O'Conner
COLLIERY No 2
J.C. STINEMAN
SUSAN PENROD
ADAM VARNER
NEAL HARKINS
SAMUEL VARNER
ALVIS WILHELM
EPHRIAM CUSTER
ABRAHAM FYOCK
JOHN P. LAYMAN
DAVID FYOCK
J.C. Stineman Mineral
STINEMAN COAL MINING CO. No 1 LEASE.
CONEMAUGH RIVER
Coal Line No Coal
Dip
Dip
2218-L2-17