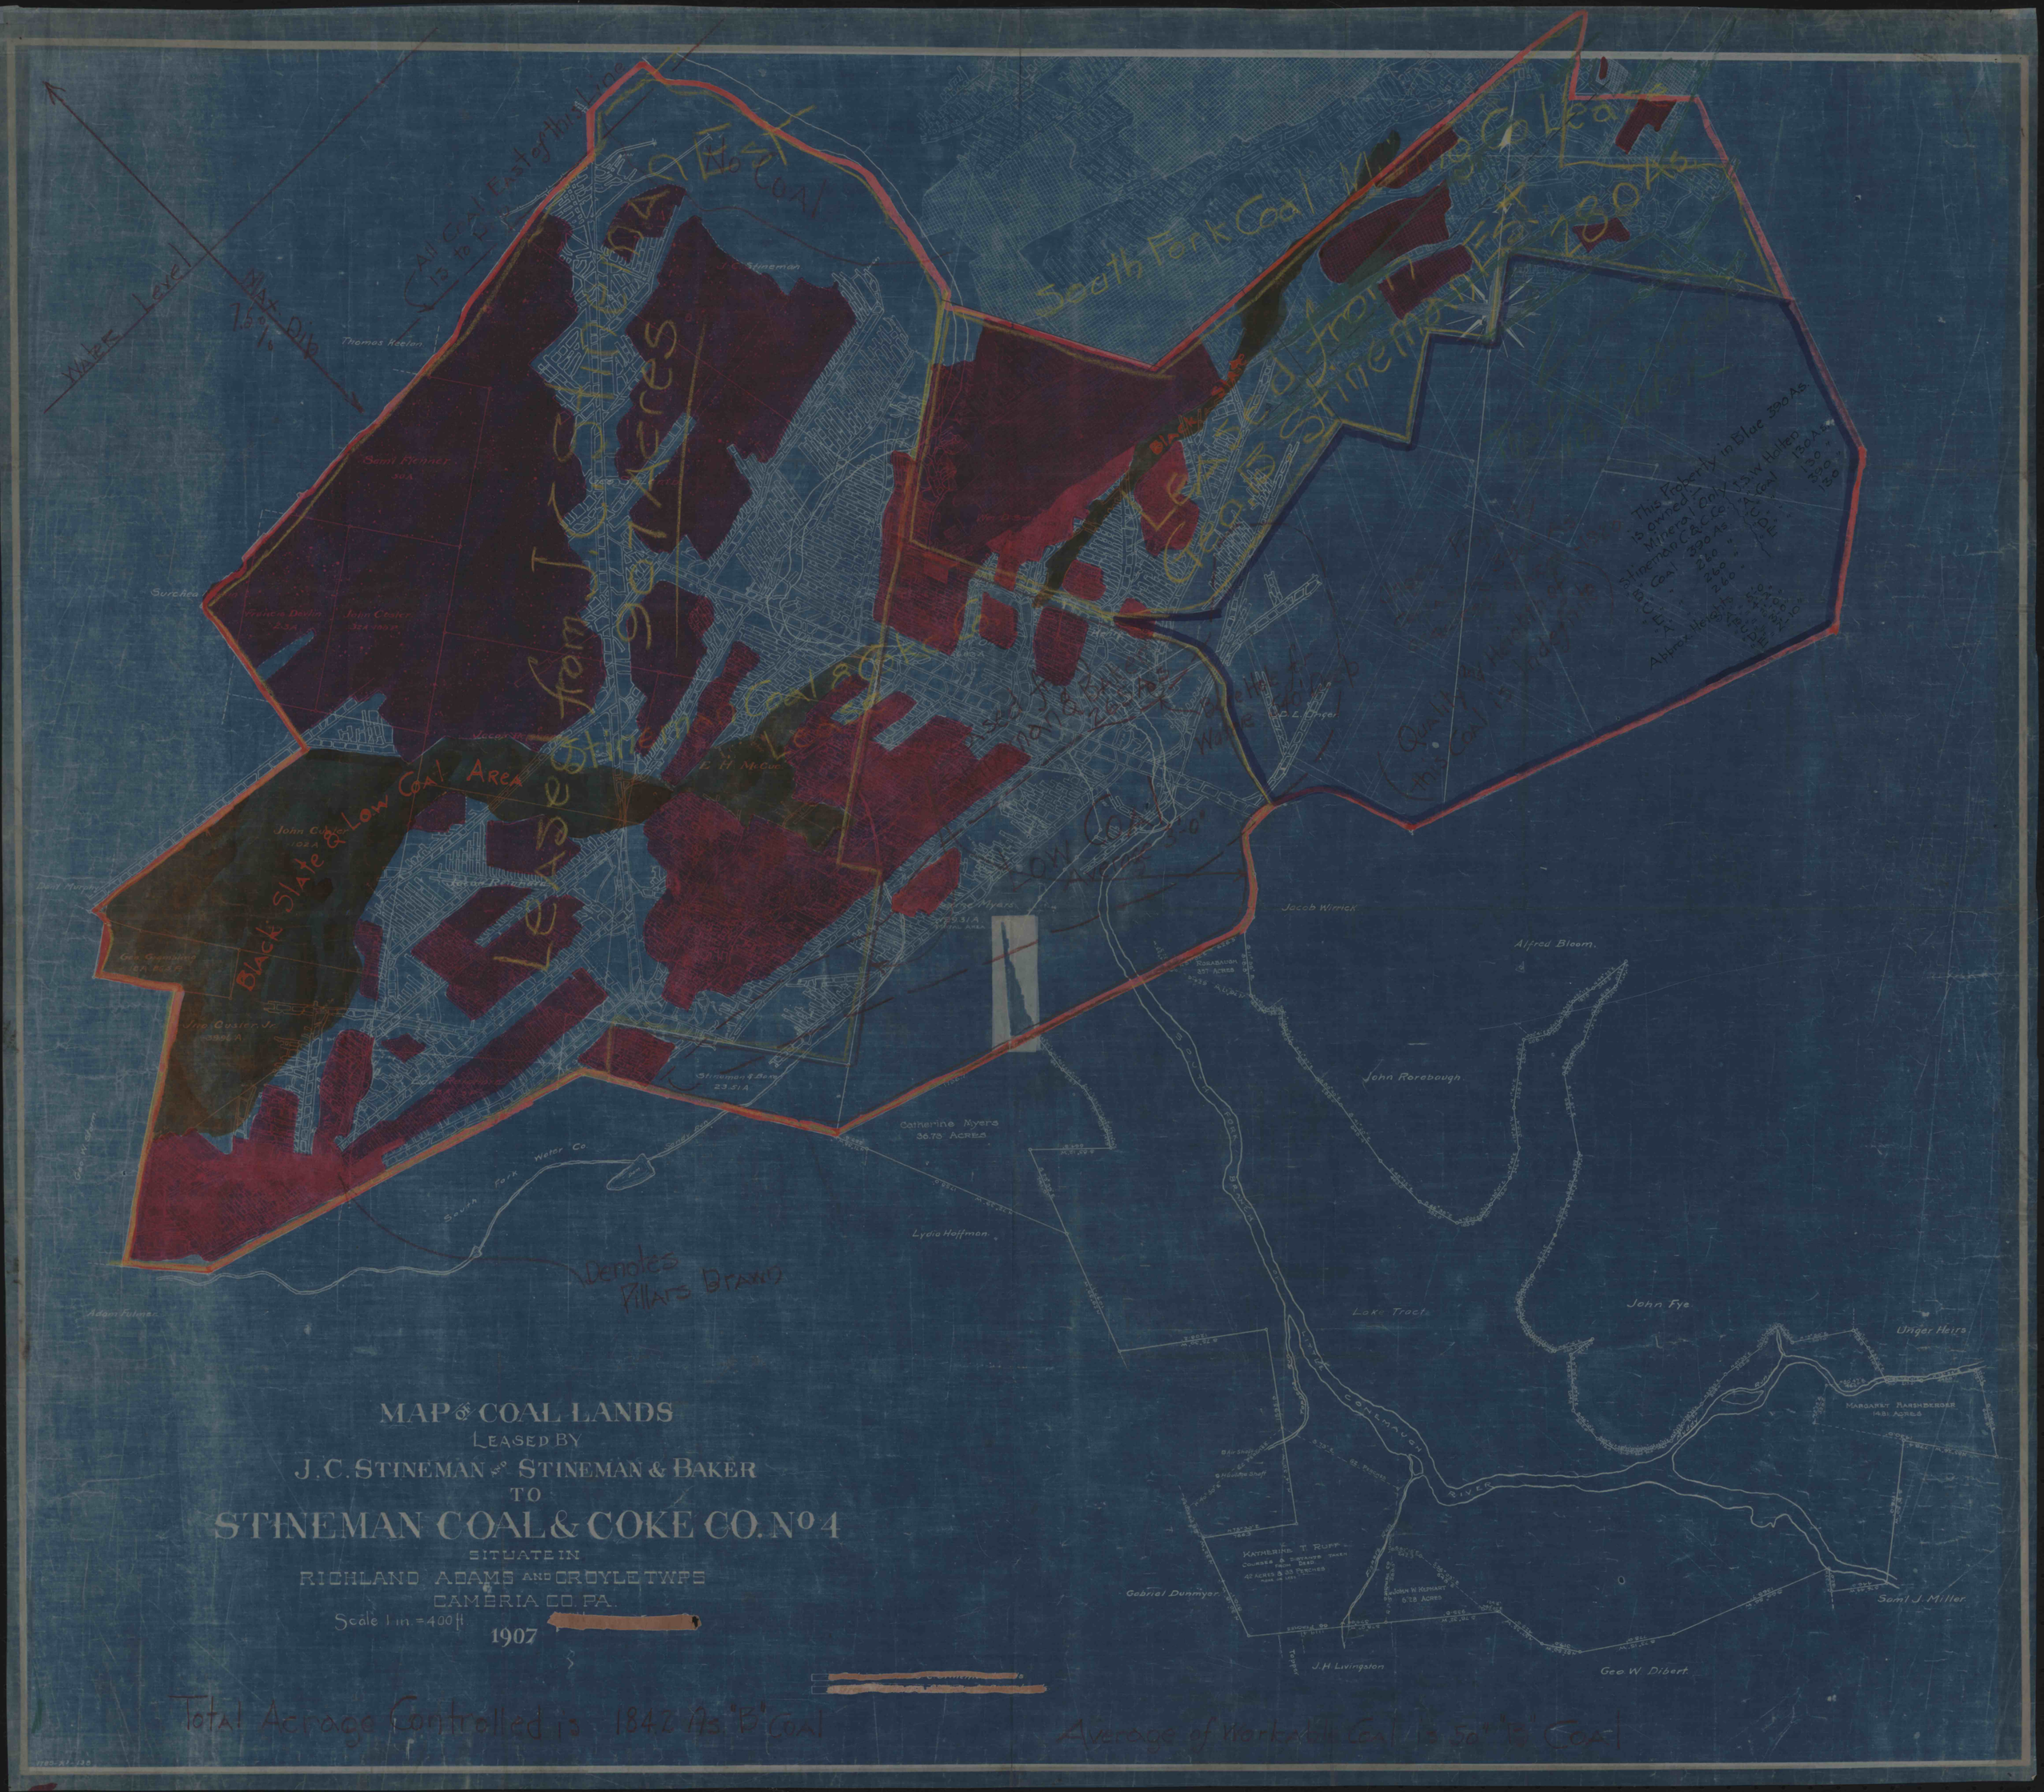
MAP OF COAL LANDS
LEASED BY
J.C. STINEMAN AND STINEMAN & BAKER
TO
STINEMAN COAL & COKE CO. No 4
SITUATE IN
RICHLAND ADAMS AND CROYLE TWPS
CAMBRIA CO. PA.
Scale 1 in = 400 ft
1907
Total Acrage Controlled is 1842 As "B" Coal
Average of Workable Coal is 50" "B" Coal
Denotes Pillars Drawn
South Fork Coal
Black Slate & Low Coal Area
Water Level
Mat Dip
Thomas Keelan
Saml Flenner
Surchea
John Custer
Catherine Myers
36.75 Acres
Lydia Hoffman
Adam Fulmer
South Fork Water Co.
Jacob Wirrick
Alfred Bloom
John Rorabaugh
Lake Tract
John Fye
Unger Heirs
Margaret Harshberger
Gabriel Dunmyer
J.H. Livingston
Geo W. Dibert
Saml J. Miller
Katherine T. Ruff
Conemaugh River
Stineman & Baker
23.51 A
E. H. McCue
D. L. Unger
Black Slate
Leased from J.C. Stineman Coal Co. Leased from Stineman Coal Co. Leased from Stineman Coal Co. 130 As
This Property in Blue 390 As is owned Mineral Only
J.S.W. Holten
Stineman C.&C. Co.
"A" Coal 130 As
"B" Coal 390 As
"C" " 260 "
"D" " 260 "
"E" " 260 "
Approx Heights
"A" 5'-0"
"B" 4'-2"
"C" 4'-0"
"D" 3'-0"
"E" 2'-10"
Quality and Height of this Coal is Indefinite