


GOBBLER KNOB
GLEN IRVAN CORP. MINE
B SEAM

FINAL MAP
LADY JANE COLLIERIES, INC.
STOTT No. 1 MINE - B SEAM
 HUSTON TWP. CLEARFIELD CO.
 PENFIELD, PA
 SCALE: 1"=400' DATE: 9-4-85
MINING COMPLETED 12-14-84

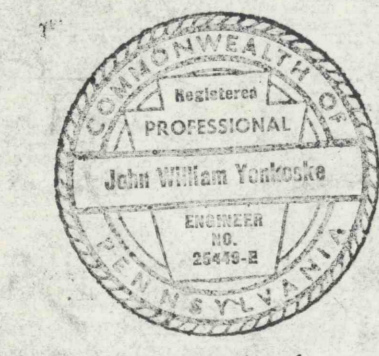

John W. Yehle
11-6-85

- Gas well
- Power hole
- Base line Sta. See Vol. 3 Pg. 44
- Property Line
- SPLIT PILLAR Pillar Removed

*THE LOCATION AND AREA OF THE 100' TO THE 1200' HATS IS SHOWN BY LINES AND CORRESPONDING NUMBER.

NO. 2 AND DATA
 200' HAT 575' A. B. C.
 MODEL PLACED IN
 WATER GAINING 10
 BLADE SETTING 1 OF 5
 AIR 53000 CF.