


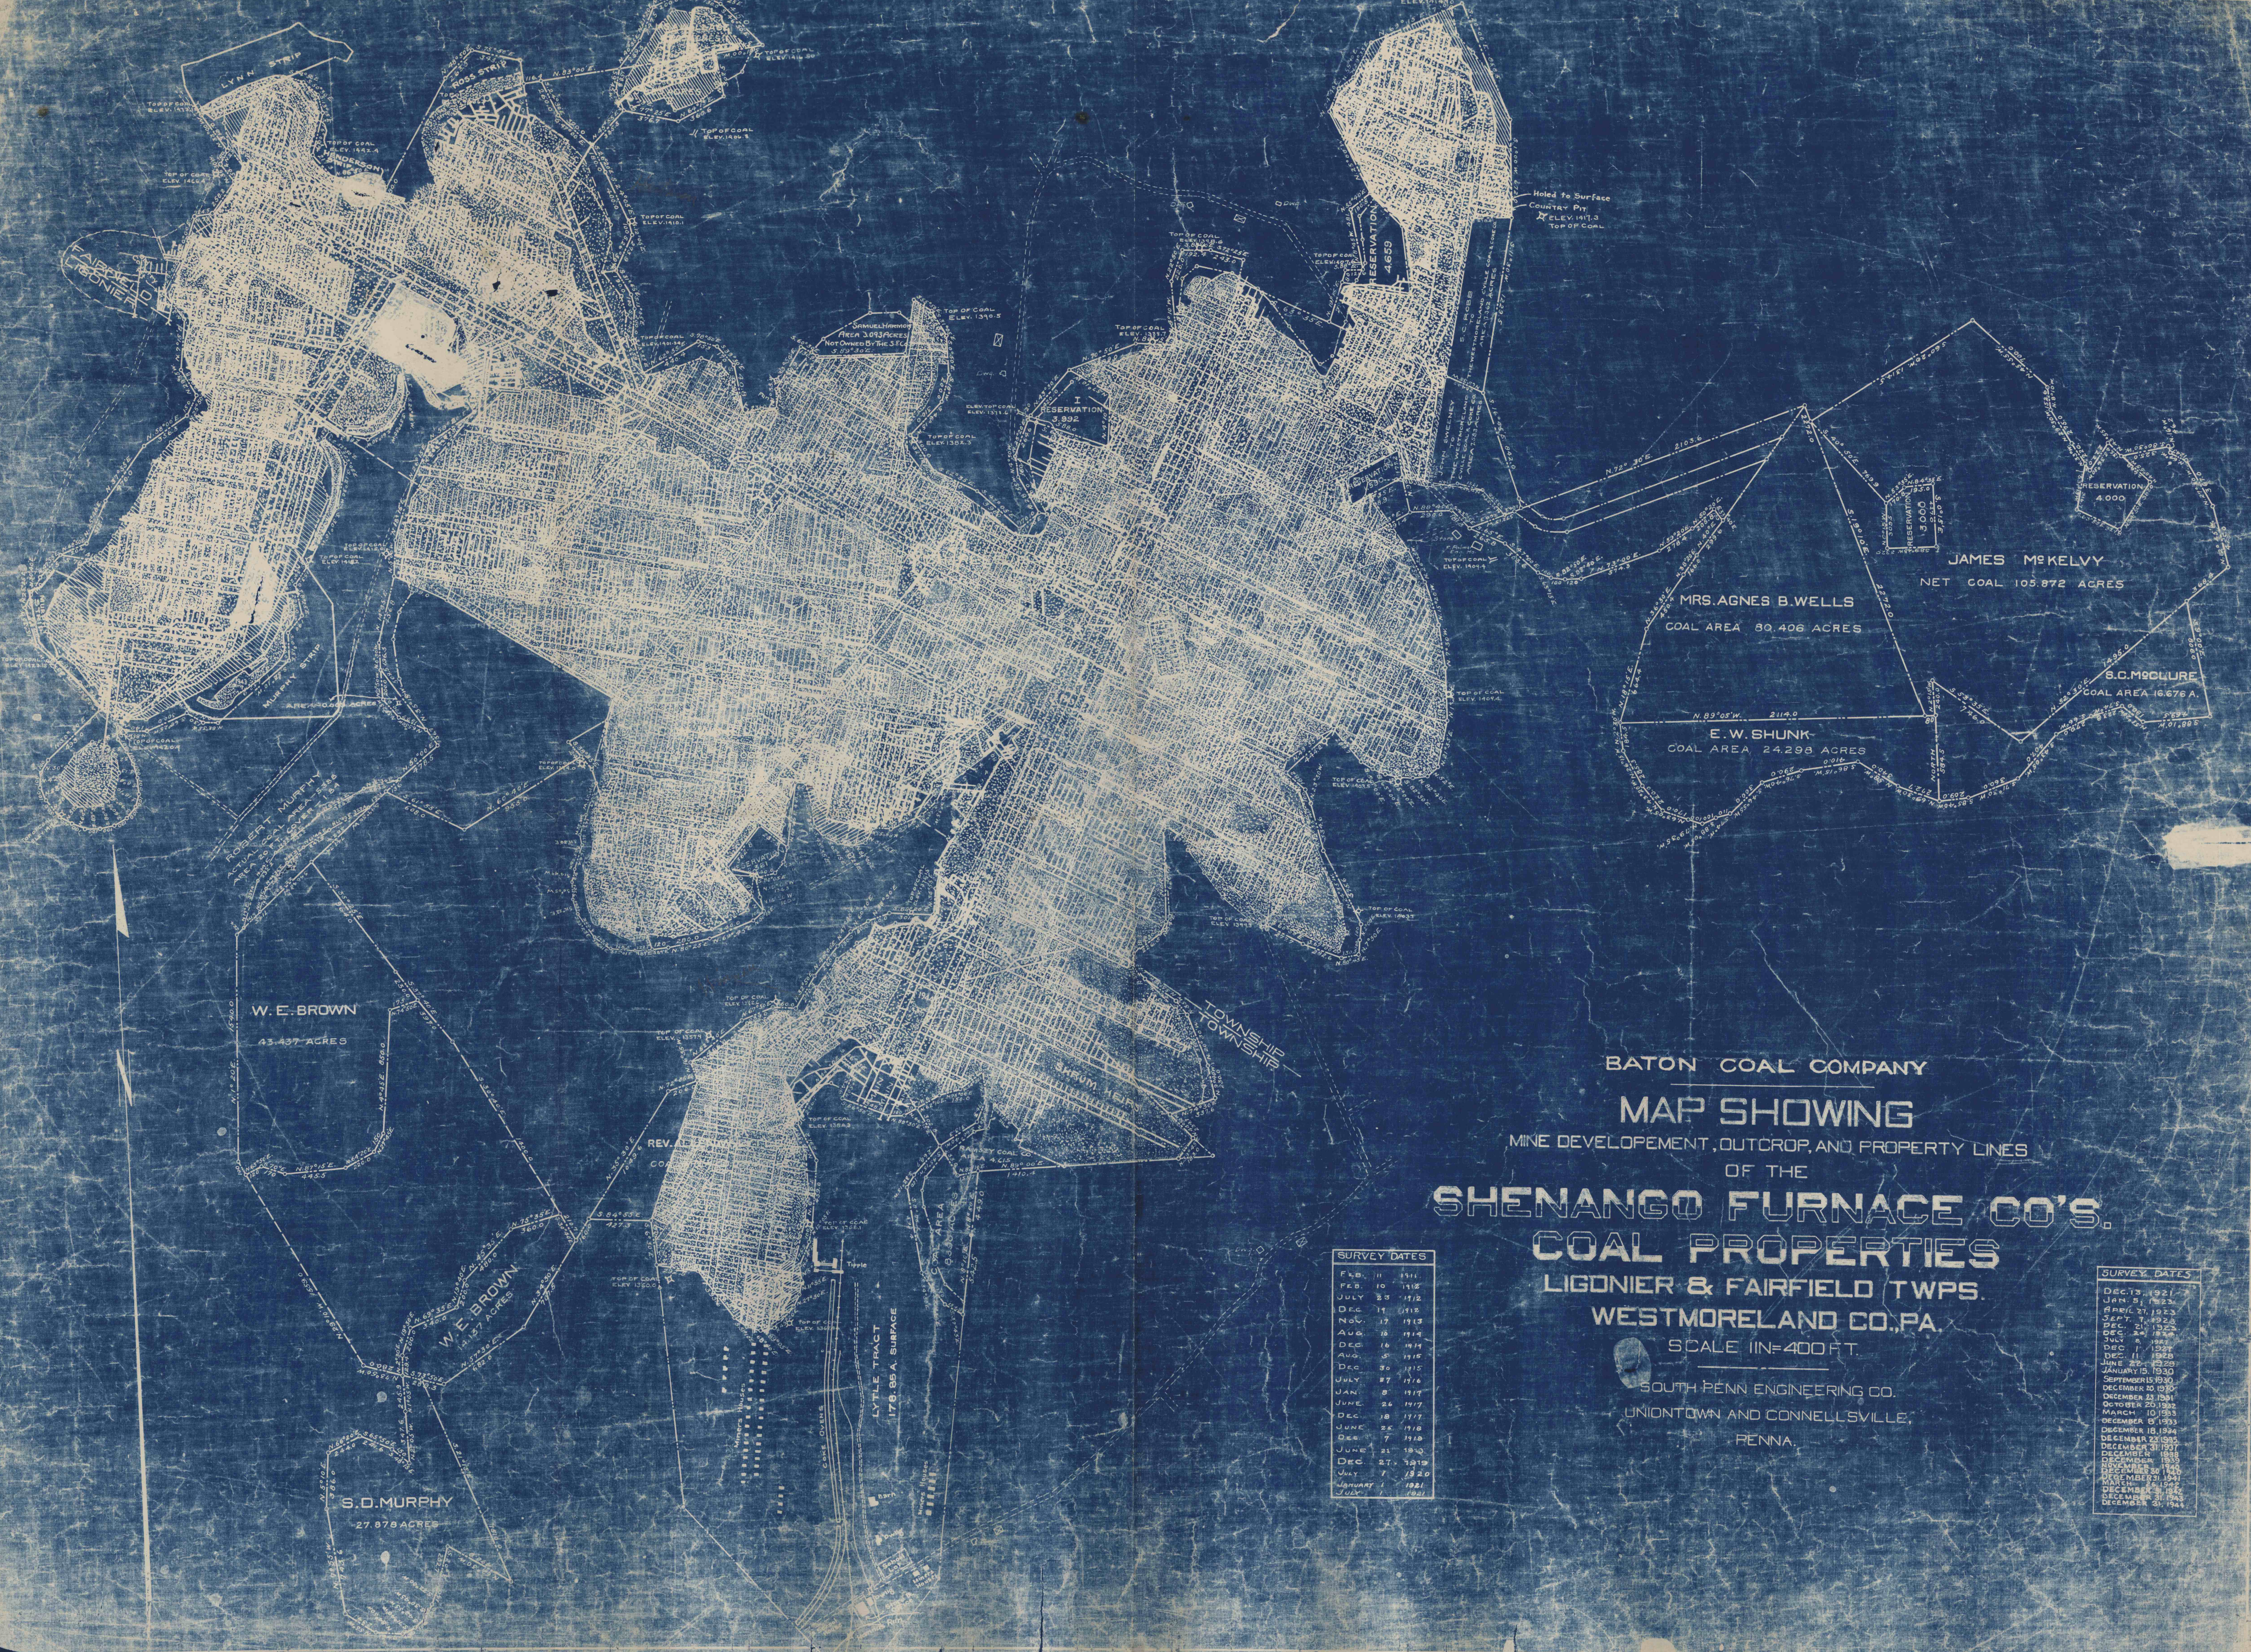

BATON COAL COMPANY
MAP SHOWING
MINE DEVELOPEMENT, OUTCROP, AND PROPERTY LINES
OF THE
SHENANGO FURNACE CO.'S.
COAL PROPERTIES
LIGONIER & FAIRFIELD TWPS.
WESTMORELAND CO., PA.

SCALE 1IN=400 FT.

SOUTH PENN ENGINEERING CO.
UNIONTOWN AND CONNELLVILLE,
PENNA.

SURVEY DATES	
FEB. 11	1911
FEB. 10	1918
JULY 33	1912
DEC. 11	1913
NOV. 17	1913
AUG. 16	1914
DEC. 16	1914
AUG. 3	1915
DEC. 8	1915
JULY 27	1916
JAN. 8	1917
JUNE 26	1917
DEC. 18	1917
JUNE 25	1918
DEC. 7	1918
JUNE 21	1919
DEC. 27	1919
JULY 7	1920
JANUARY 1	1921
JULY 1	1921

SURVEY DATES	
DEC. 13	1921
JAN. 31	1923
APRIL 27	1923
JULY 1	1923
DEC. 11	1923
DEC. 24	1924
JAN. 1	1925
DEC. 1	1925
DEC. 11	1925
JUNE 25	1926
JANUARY 15	1930
SEPTEMBER 15	1930
DECEMBER 20	1930
DECEMBER 23	1931
OCTOBER 20	1932
MARCH 10	1933
DECEMBER 8	1933
DECEMBER 10	1934
DECEMBER 22	1935
DECEMBER 31	1937
DECEMBER 15	1938
DECEMBER 20	1938
DECEMBER 21	1938
MARCH 10	1942
DECEMBER 31	1943
DECEMBER 14	1944