

Sus. River
N.Y. CENTRAL R.R.

PH. 1000
PH. 1000
PH. 1000


WOOLRIDGE CANNEL COAL Co.

BRADFORD TWP. CLEARFIELD Co., PA.

SCALE 1" = 400 feet
E.W. HESS


N

"B" coal

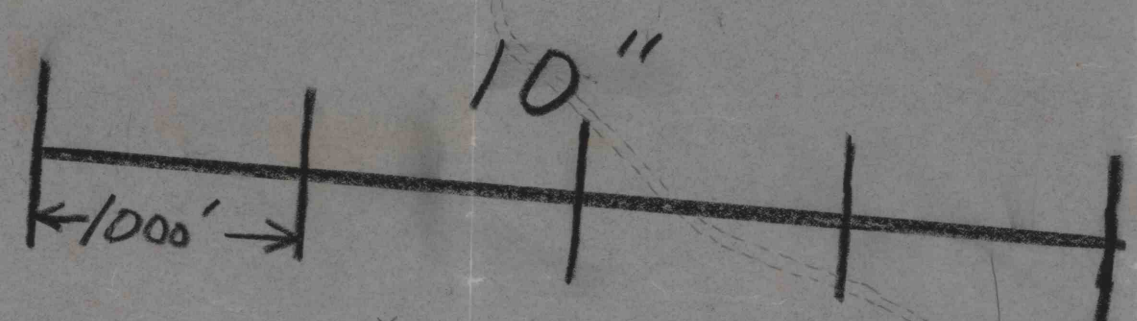

W.H. SHIREY

"C" coal

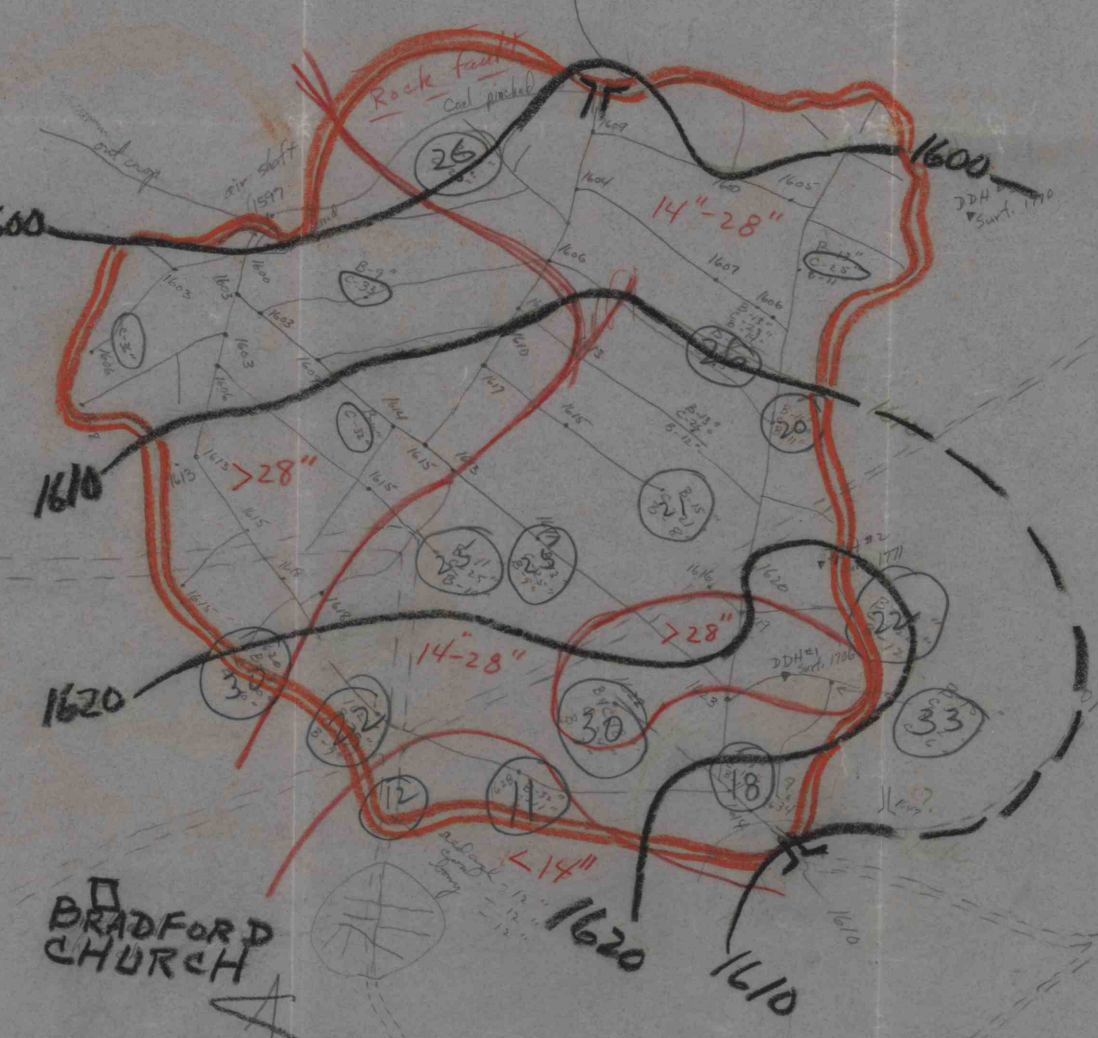

N

probably not
old Blair #2 Canal
Mines
A.D.

Woolridge #2
mine

BRADFORD CHURCH

(for more detail see
maps of scale 1" = 100')