



E-40000 H G E-30000 E-30000 F




SEWICKLEY SEAM
GREENE COUNTY
PENNSYLVANIA
DATE - 1965
SCALE 1"=400'
U.S.B.M. ID. NO. 36 02374 O PORTAL NO. 3
O PORTAL NO. 4

WARWICK MINE-PORTAL NO. 3 & 4
DUQUESNE LIGHT CO.

| MINE WORKINGS EXTENDED: | |
|-------------------------|----------|
| 12-31-81 | 6-30-81 |
| 12-31-82 | 6-30-82 |
| 12-31-83 | 6-30-83 |
| 12-31-84 | 6-30-84 |
| 12-31-85 | 6-30-85 |
| 12-31-86 | 6-30-86 |
| 12-31-87 | 6-30-87 |
| 12-31-88 | 6-30-88 |
| 12-31-90 | 6-30-88 |
| 12-31-93 | 6-30-93 |
| 12-31-96 | 6-30-96 |
| 12-31-66 | 12-31-66 |
| 12-31-68 | 6-30-68 |
| 12-31-70 | 6-30-70 |
| 12-31-72 | 6-30-72 |
| 12-31-74 | 6-30-74 |
| 12-31-76 | 6-30-76 |
| 12-31-78 | 6-30-78 |
| 12-31-80 | 6-30-80 |
| 12-31-92 | 6-30-92 |
| 12-31-95 | 6-30-95 |
| 12-31-94 | 12-31-94 |
| 12-31-67 | 12-31-67 |
| 12-31-69 | 12-31-69 |
| 12-31-71 | 6-30-71 |
| 12-31-73 | 6-30-73 |
| 12-31-75 | 6-30-75 |
| 12-31-77 | 6-30-77 |
| 12-31-79 | 6-30-79 |
| 12-31-91 | 6-30-91 |
| 12-31-94 | 6-30-94 |

| COORDINATES | DEPTH | DISTANCE | CORNER | DESCRIPTION |
|-------------|--------------|----------|--------|-------------|
| 84559.13 | 5-07 | 335.90' | | |
| 83299.30 | | | | |
| 84868.30 | 8-06 | 510.16' | | |
| 83917.80 | | | | |
| 846178.82 | 883°-30'-47E | 335.90' | | |
| 80921.87 | | | | |
| 848250.50 | 874°-31'-56E | 510.16' | | |
| 129817.80 | | | | |

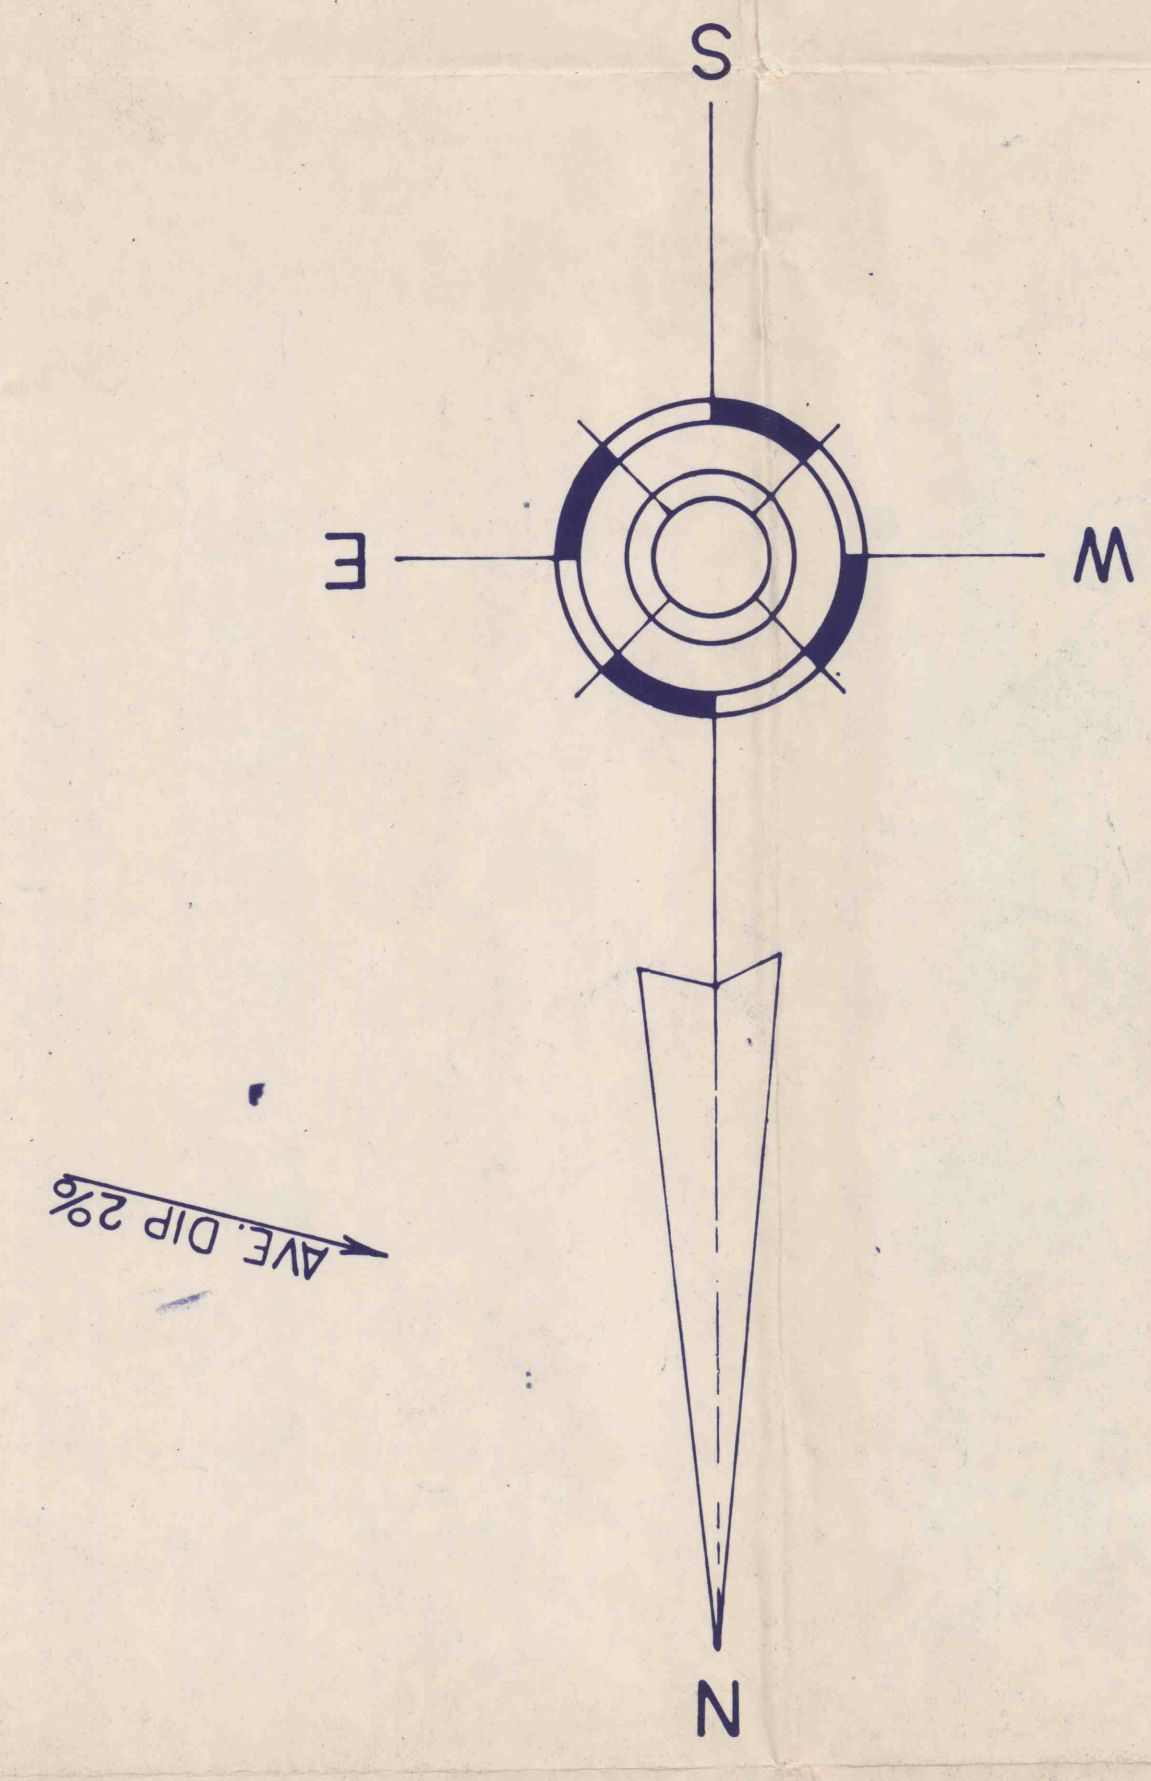

E-40000 H G E-30000 E-30000 T