




No. 2 Shaft
2 Compartment
Intake-Return
Sealed

Water Monitoring Borehole-Den
B Water Ring Borehole
Surface 1084.5
Coal - 678.0
Depth - 416.5

Slope
2 Compartment
Sealed

No. 1 Shaft
2 Compartment
Intake-Return
Sealed

LUCERNE 9 MINE DATE 12-30-94
FINAL MINE MAP 1" = 400'

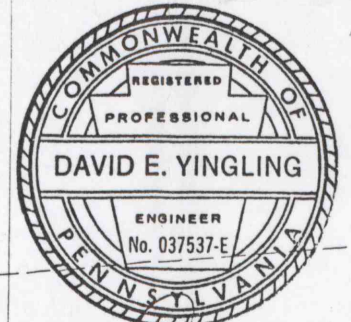

David E. Yingling