

MAP OF PROPERTY

OF THE TAYLOR & M_cCOY COAL & COKE CO.

GALLITZIN TOWNSHIP, CAMBRIA CO., PA.


SCALE: 1" = 400'

W.A. SILLIMAN
MINING ENGINEER.

ALTOONA, PA.

"E" SEAM MINE WORKINGS SHOWN TO DATE OF FEB. 10, 1936.

ALL MINERAL AND SURFACE OWNED IN FEE	RED
ALL MINERAL OWNED IN FEE - SURFACE NOT OWNED	PURPLE
ALL MINERAL EXCEPT "B" SEAM OWNED IN FEE - SURFACE OWNED	WHITE
ALL MINERAL EXCEPT "B" SEAM OWNED IN FEE - SURFACE NOT OWNED	GREEN
"B" SEAM OWNED IN FEE, "E" SEAM LEASED	YELLOW
"E" SEAM ONLY LEASED	BROWN

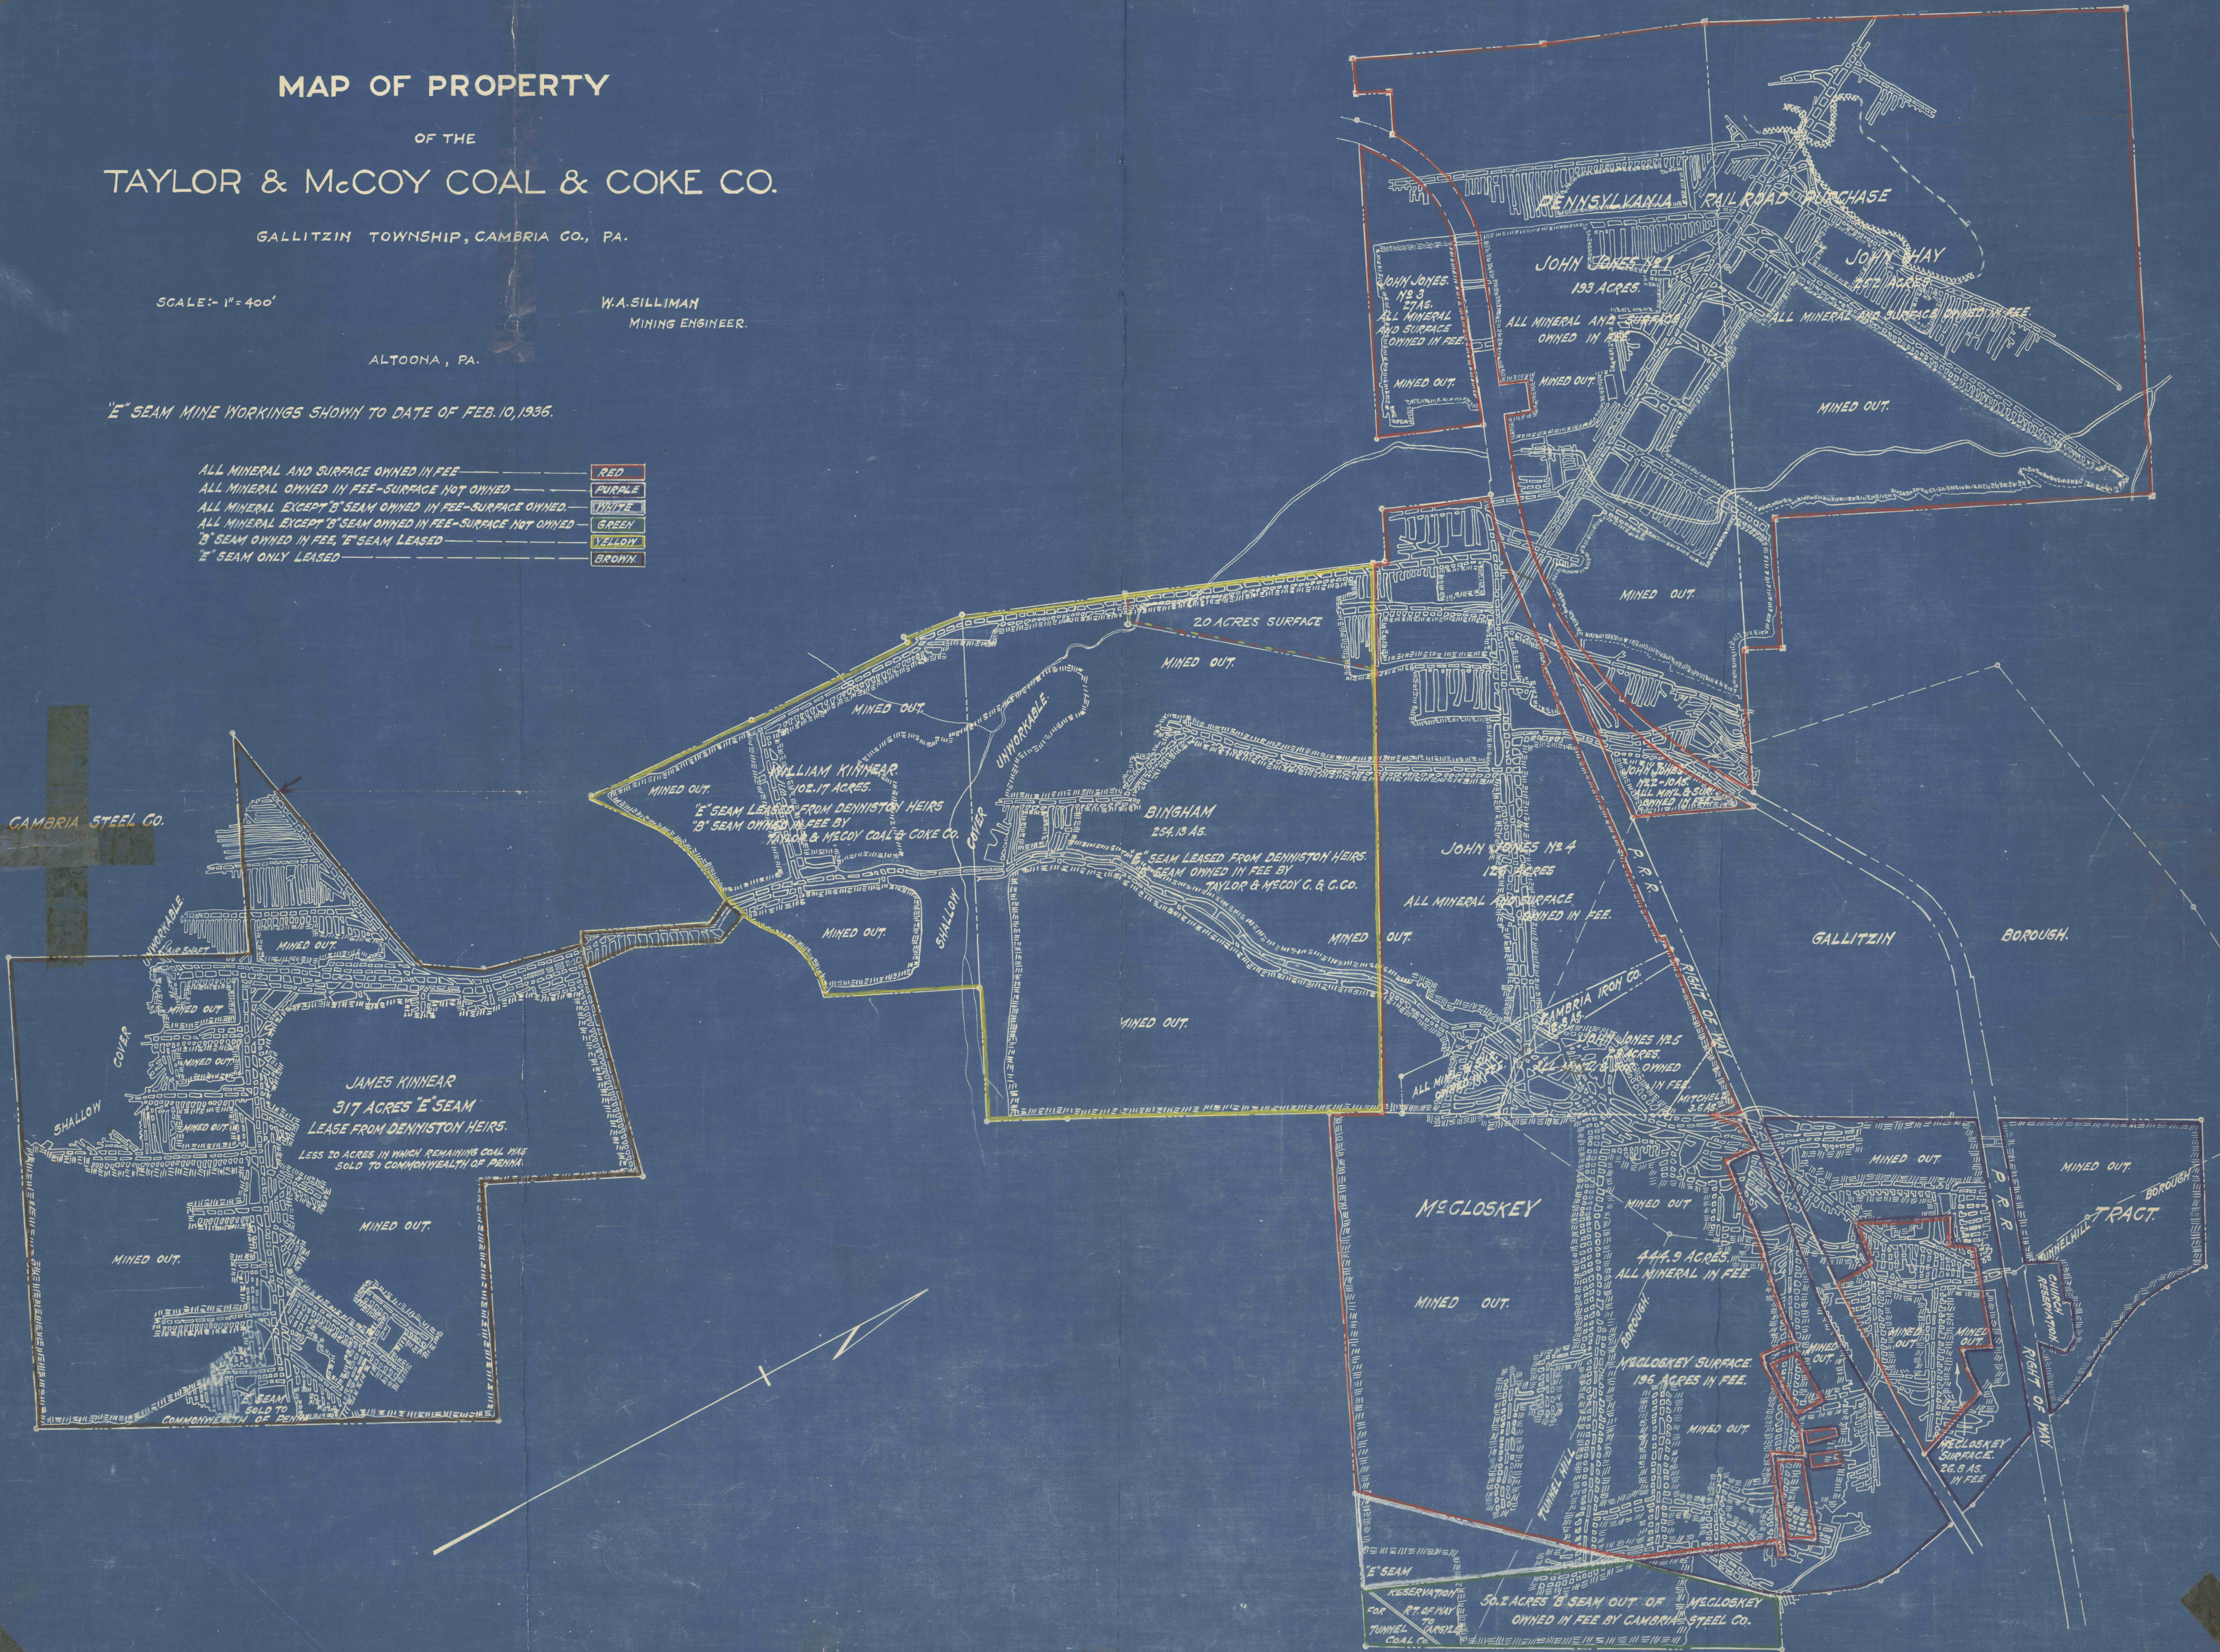

CAMBRIA STEEL CO.

JAMES KINNEAR
317 ACRES "E" SEAM
LEASE FROM DENNISTON HEIRS.
LESS 20 ACRES IN WHICH REMAINING COAL HAS
SOLD TO COMMONWEALTH OF PENNA.

McGLOSKEY

MINED OUT.

MINED OUT.

MINED OUT.

MINED OUT.

MINED OUT.

MINED OUT.

RESERVATION FOR TUNNEL COAL CO.

36.2 ACRES "B" SEAM OUT OF MCGLOSKEY OWNED IN FEE BY CAMBRIA STEEL CO.

MINED OUT.

MINED OUT.

