


ROCHESTER & PITTSBURG COAL & IRON CO.



WEST HOMER LAND CO.

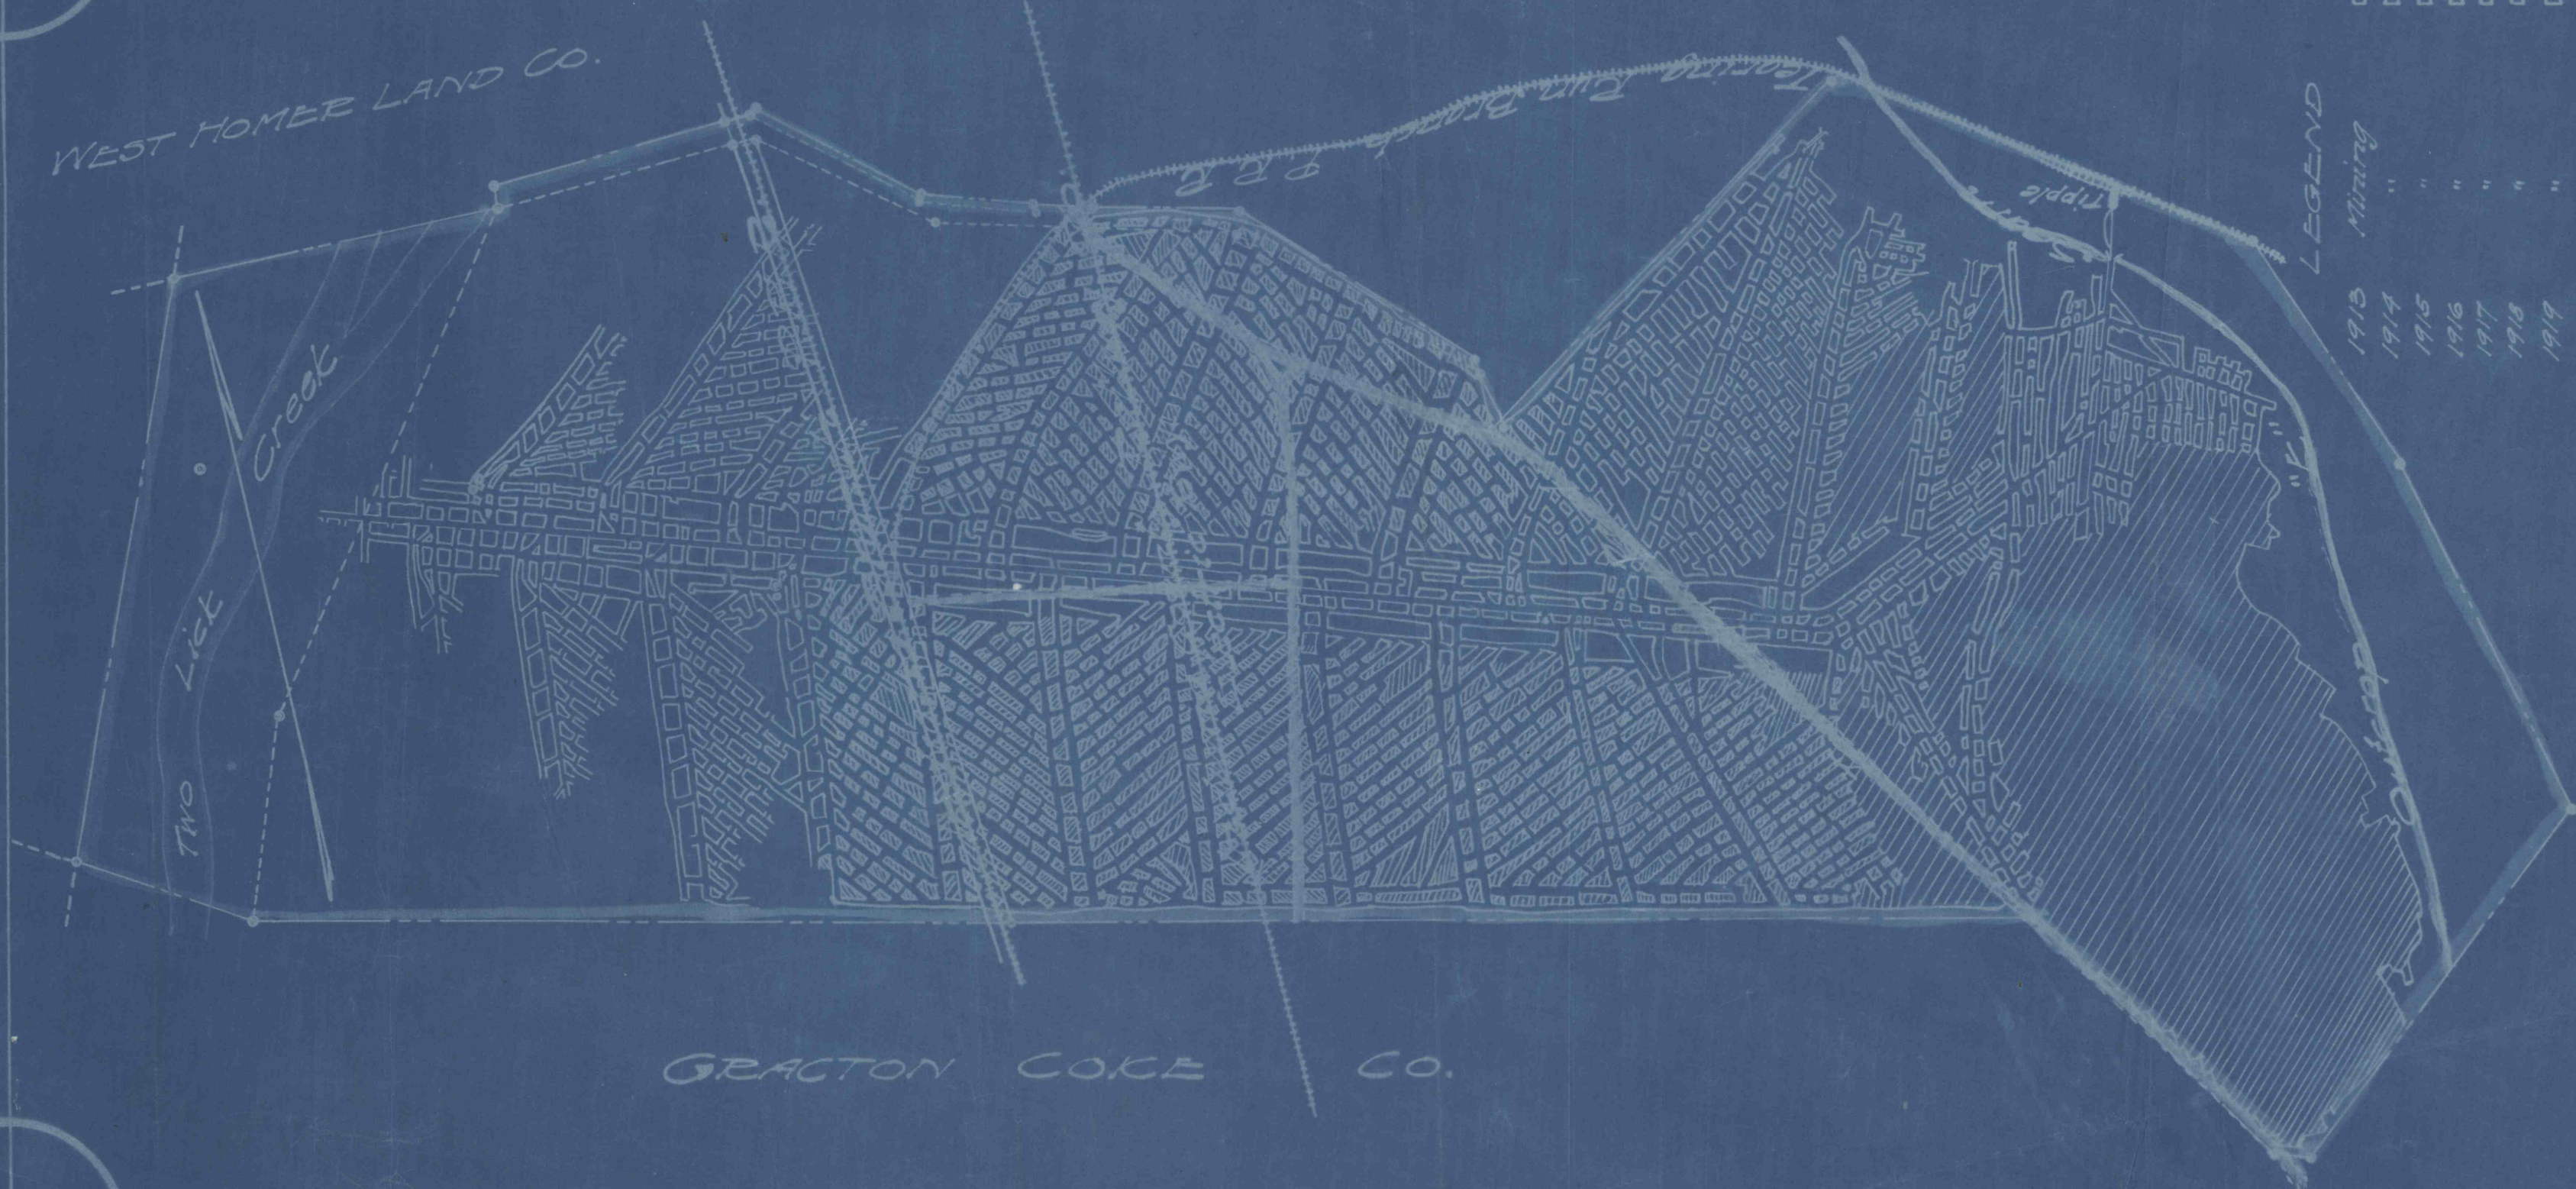

LEGEND

| | |
|------|--------|
| 1913 | Mining |
| 1914 | " |
| 1915 | " |
| 1916 | " |
| 1917 | " |
| 1918 | " |
| 1919 | " |

GRAXTON COKE CO.

MAP SHOWING
 ANNUAL DEVELOPMENT
 OF
 TEARING RUN MINE
 "E" SEAM
 OPERATED BY
 HOMER CITY COAL CO.
 HOMER CITY, INDIANA CO.

PENNA.



Scale in Feet

Aug. 31, 1920.