


REVISED 2-16-85 482.40 - 16.27 = 466.13 ACRES

- NOTES:
1. THE ENTIRE PERMIT AREA OF 482.40 ACRES IS WITHIN DUNKARD TOWNSHIP, GREENE CO.,
 2. THERE ARE NO AREAS OVER THE PERMIT AREA THAT HAVE BEEN DECLARED AS UNSUITABLE FOR MINING
 3. THERE ARE NO MAJOR AQUIFERS THAT SERVE AS SIGNIFICANT SOURCES OF WATER SUPPLY TO PUBLIC WATER SYSTEMS.
 4. THERE ARE NO IMPOUNDMENTS EXCEEDING 20 AC-FT OVER THE MINE.
 5. THERE ARE NO PUBLIC PARKS, INDIAN BURIAL GROUNDS OR HISTORICAL STRUCTURES ABOVE BREN-MAR MINE.
 6. THERE ARE NO WATER TREATMENT FACILITIES AT BREN-MAR MINE.
 7. SEE APPENDIX 7 OR DRILL LOGS FOR STRATIGRAPHY.
 8. UNLESS OTHERWISE MARKED, ALL MINING COMPANIES REFERRED TO ON THIS MAP OPERATE IN THE SEWICKLEY SEAM AND ARE ACTIVE.
 9. ALL SURFACE STRUCTURES ABOVE OR IMMEDIATELY ADJACENT TO THIS DEEP MINE WERE IN PLACE BEFORE 1966.
 10. ALL OIL AND GAS WELLS EXCEPT PP-10 HAVE PERMIT NUMBERS
 11. WATER SAMPLING POINTS (5)

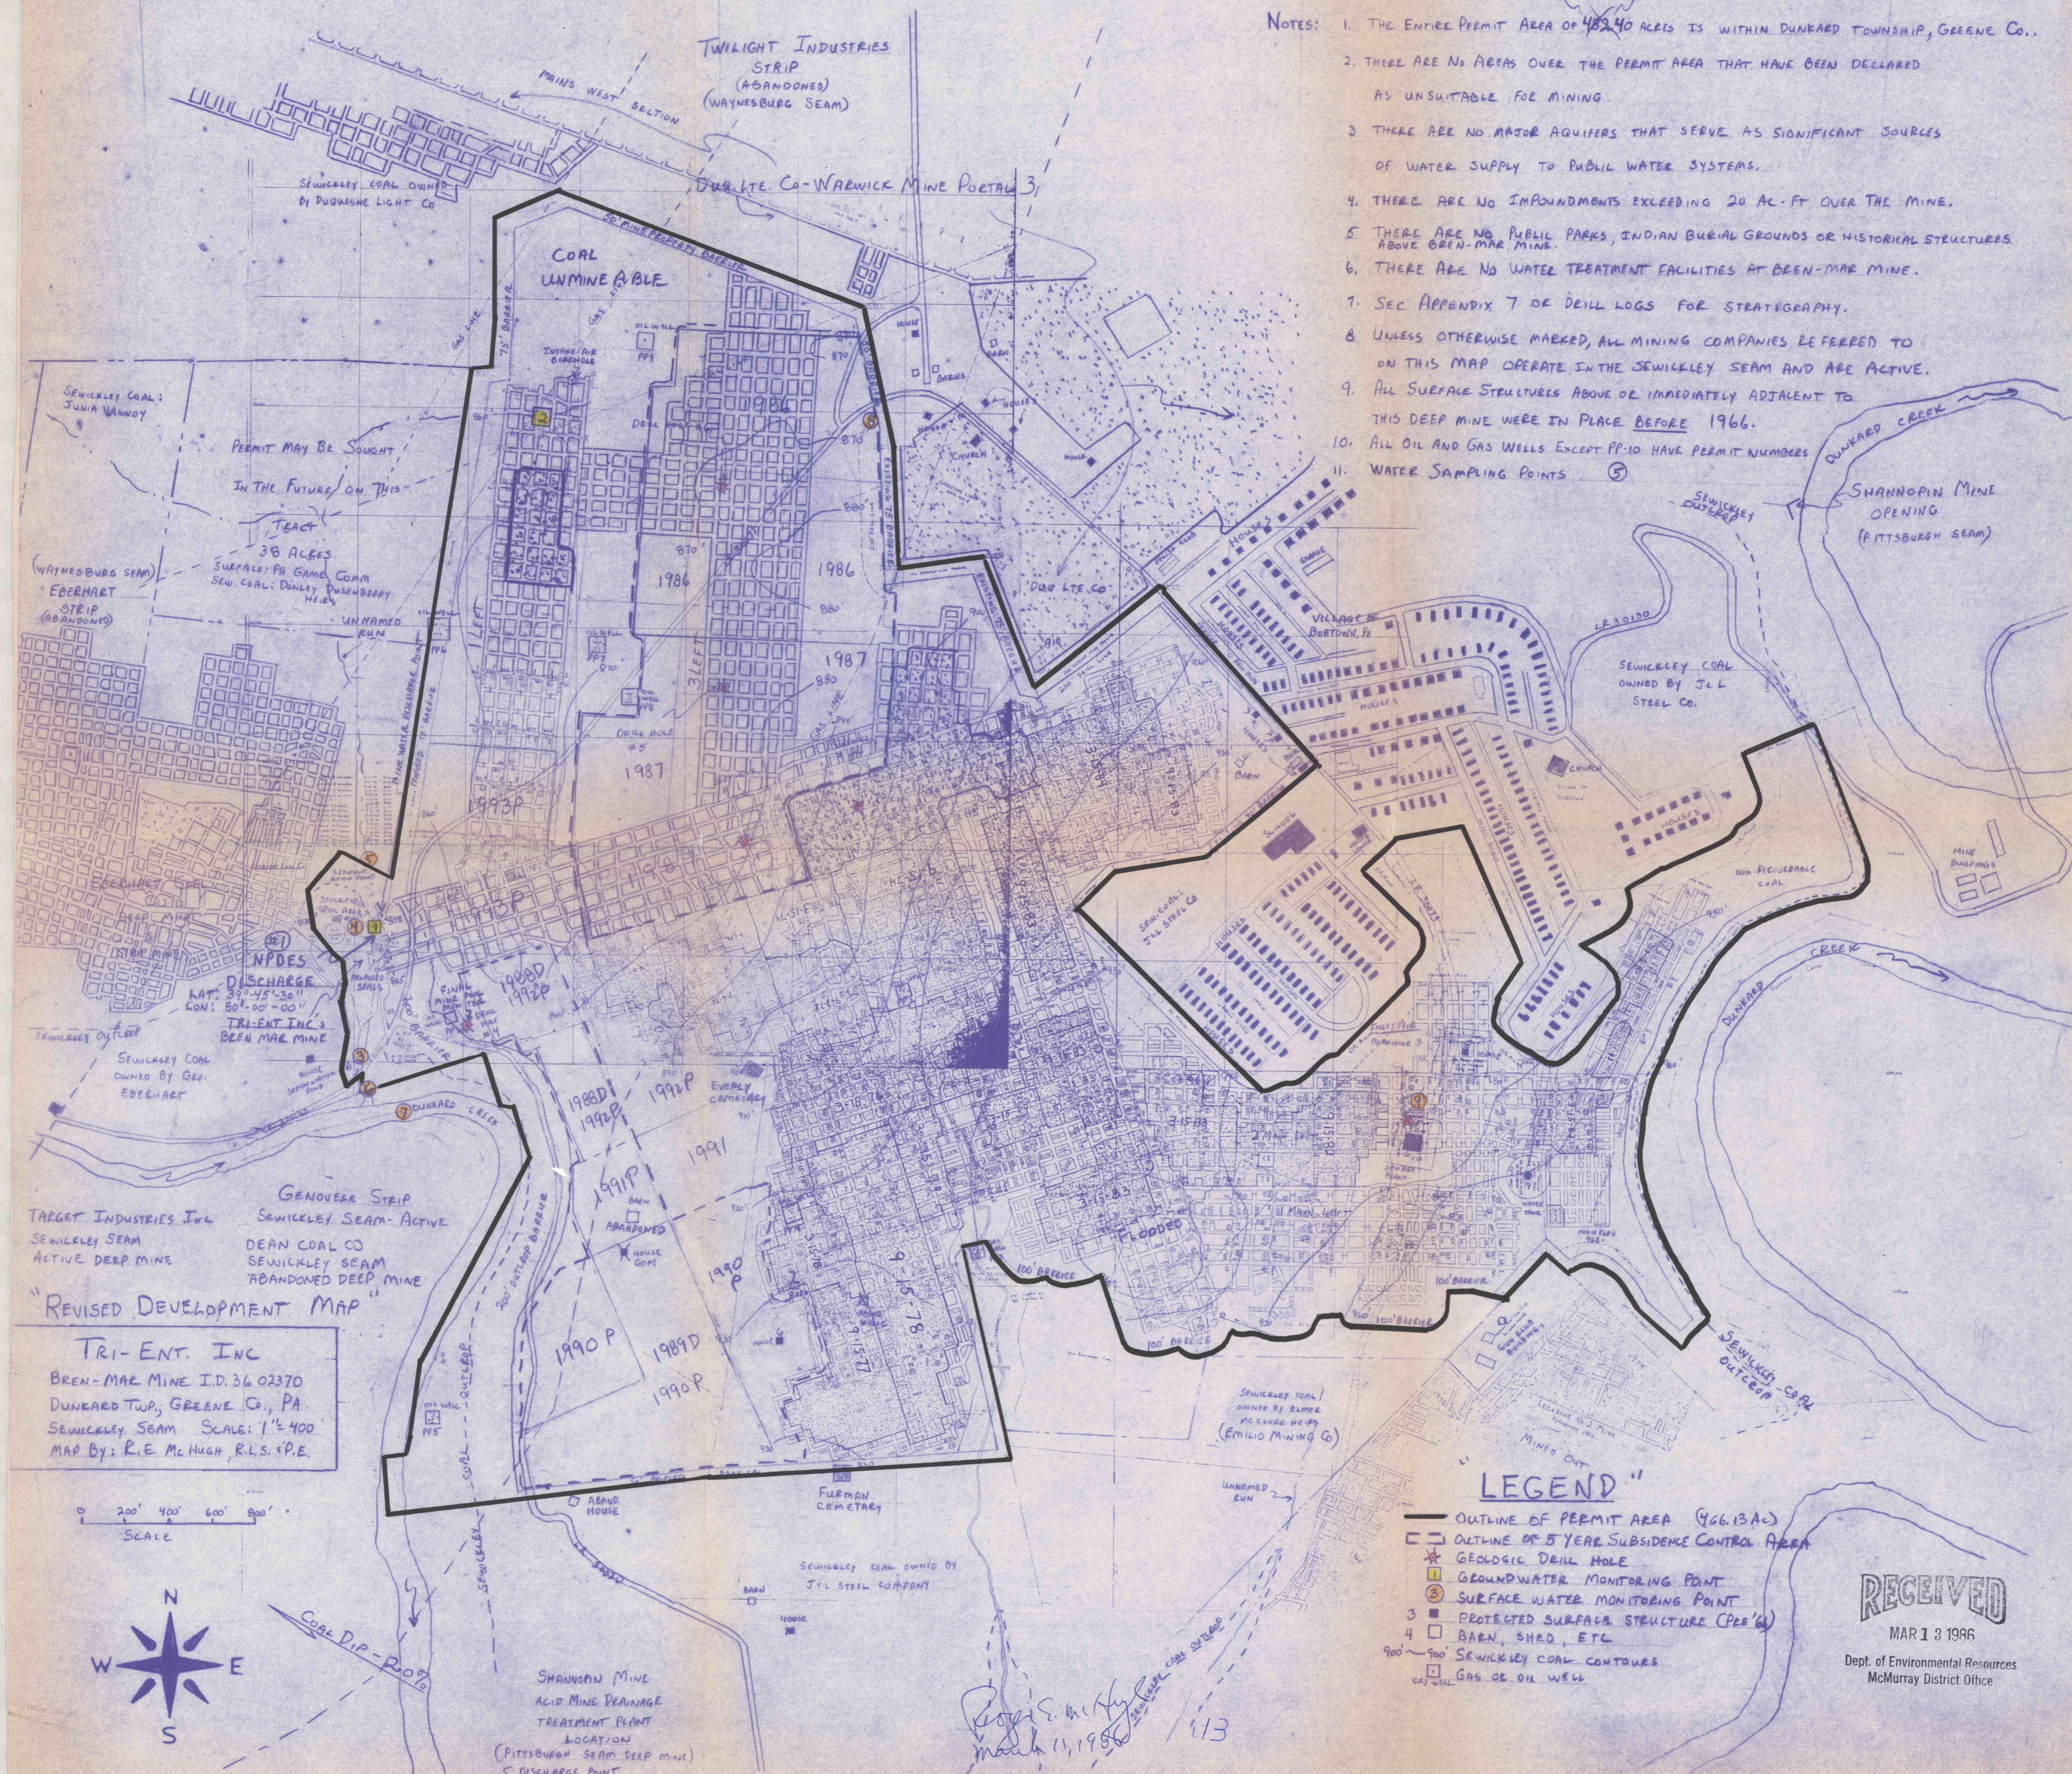


PERMIT MAY BE SOUGHT
IN THE FUTURE ON THIS
TRACT
38 ACRES
SURFACE: PA GAME COMM
SEW COAL: DONLEY PUSENBERRY
HEARL

NPDES
DISCHARGE
WAT: 39°-45'-30"
CON: 80°-00'-00"
TRI-ENT INC'S
BREN MAR MINE

GENOVESE STRIP
SEWICKLEY SEAM - ACTIVE
DEAN COAL CO
SEWICKLEY SEAM
ABANDONED DEEP MINE

"REVISED DEVELOPMENT MAP"
TRI-ENT. INC
BREN-MAR MINE I.D. 36 02370
DUNKARD TWP., GREENE CO., PA.
SEWICKLEY SEAM SCALE: 1"=400'
MAP BY: R.E. McHUGH, R.L.S. P.E.

0 200' 400' 600' 800'
SCALE

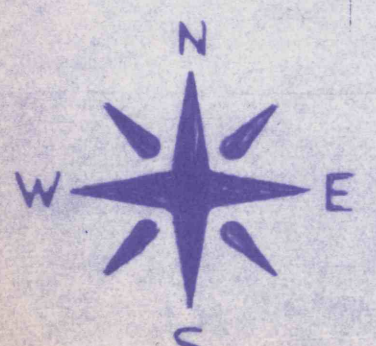

"LEGEND"

- OUTLINE OF PERMIT AREA (466.13 AC)
- OUTLINE OF 5 YEAR SUBSIDENCE CONTROL AREA
- ⊗ GEODSIC DRILL HOLE
- ⊙ GROUNDWATER MONITORING POINT
- ⊕ SURFACE WATER MONITORING POINT
- 3 PROTECTED SURFACE STRUCTURE (PPE'S)
- 4 BARN, SHED, ETC
- 900-900 SEWICKLEY COAL CONTOURS
- GAS OR OIL WELL

RECEIVED

MAR 13 1986
Dept. of Environmental Resources
McMurray District Office

*Prop. S. McHugh
March 11, 1986*