
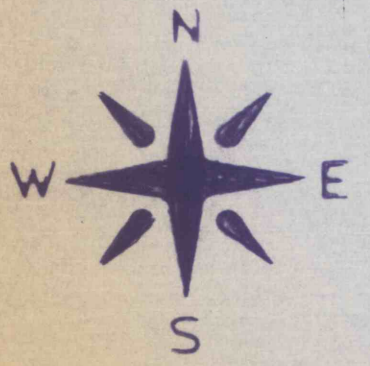


"FINAL MINE MAP"
 TRI-ENT. INC
 BREN-MAR MINE I.D. 36 02370
 DUNKARD TWP., GREENE CO., PA
 SEWICKLEY SEAM SCALE: 1"=400
 TO DATE: 12-21-90
 REVISED: 6-29-91

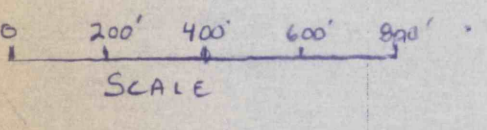

LEGEND

- OUTLINE OF MINE PROPERTY
- ★ GEOLGIC DRILL HOLE OR COREHOLE TO BE SEALED
- ① GROUNDWATER MONITORING POINT (MINE WATER)
- ② SURFACE WATER MONITORING POINT (DURING RECLAMATION)
- ③ PROTECTED SURFACE STRUCTURE (CPEE '66)
- ④ BARN, SHED, ETC
- 900-900 SEWICKLEY COAL CONTOURS
- GAS OR OIL WELL

RECEIVED
 JUL 16 1991

Dept. of Environmental Resources
 McMurray District Office



Roger E. McHugh
 June 29, 1991

GENOVESE STRIP
 SEWICKLEY SEAM - ACTIVE
 DEAN COAL CO
 SEWICKLEY SEAM
 ABANDONED DEEP MINE

38 ACRES
 SURFACE: PA GAME COMM
 SEW. COAL: EBERHART COAL CO
 UNNAMED RUN

SEWICKLEY COAL
 OWNED BY J.L.
 STEEL CO.

BREN-MAR MINE
 LAST DAY WORKED
 12-21-90
 SEWICKLEY COAL
 OWNED BY GEO.
 EBERHART

TWILIGHT INDUSTRIES
 STRIP
 (ABANDONED)
 (WAYNESBURG SEAM)

DUNK. L.T.E. CO - WARWICK MINE PORTAL 3

COAL
 UNMINEABLE

SHANNON MINE
 OPENING
 (PITTSBURGH SEAM)

VILLAGE DE
 BORTOWN, PA

SEW. COAL
 J.L. STEEL CO.

SEWICKLEY COAL
 OWNED BY EMILIO
 MACCLURE HEIRS
 (EMILIO MINING CO)

SEWICKLEY COAL OWNED BY
 J.L. STEEL COMPANY
 LEASED TO: EMILIO MINING

SHANNON MINE
 ACID MINE DRAINAGE
 TREATMENT PLANT
 LOCATION
 (PITTSBURGH SEAM DEEP MINE)
 DISCHARGE POINT