

HAYS RUN COAL CO.
SPACES CORNERS MINE
ESCAPEWAY MAP

DATE: ~~10-22-92~~ SCALE: 1"=400'


Nov 6, 1992

NOTES:
NO CO MONITORING IS UTILIZED
ALONG BELTS.

NO TRACK IS UTILIZED,

LEGEND

- PRIMARY ESCAPEWAY
- ALTERNATE ESCAPEWAY
- INTAKE AIR
- BELT AIR
- RETURN AIR
- STOPPING
- STOPPING W/ MAN DOOR
- CHECK CURTAIN
- BELT ENTRY
- HAWLAGE INTAKE ENTRY
- AIR FLOW

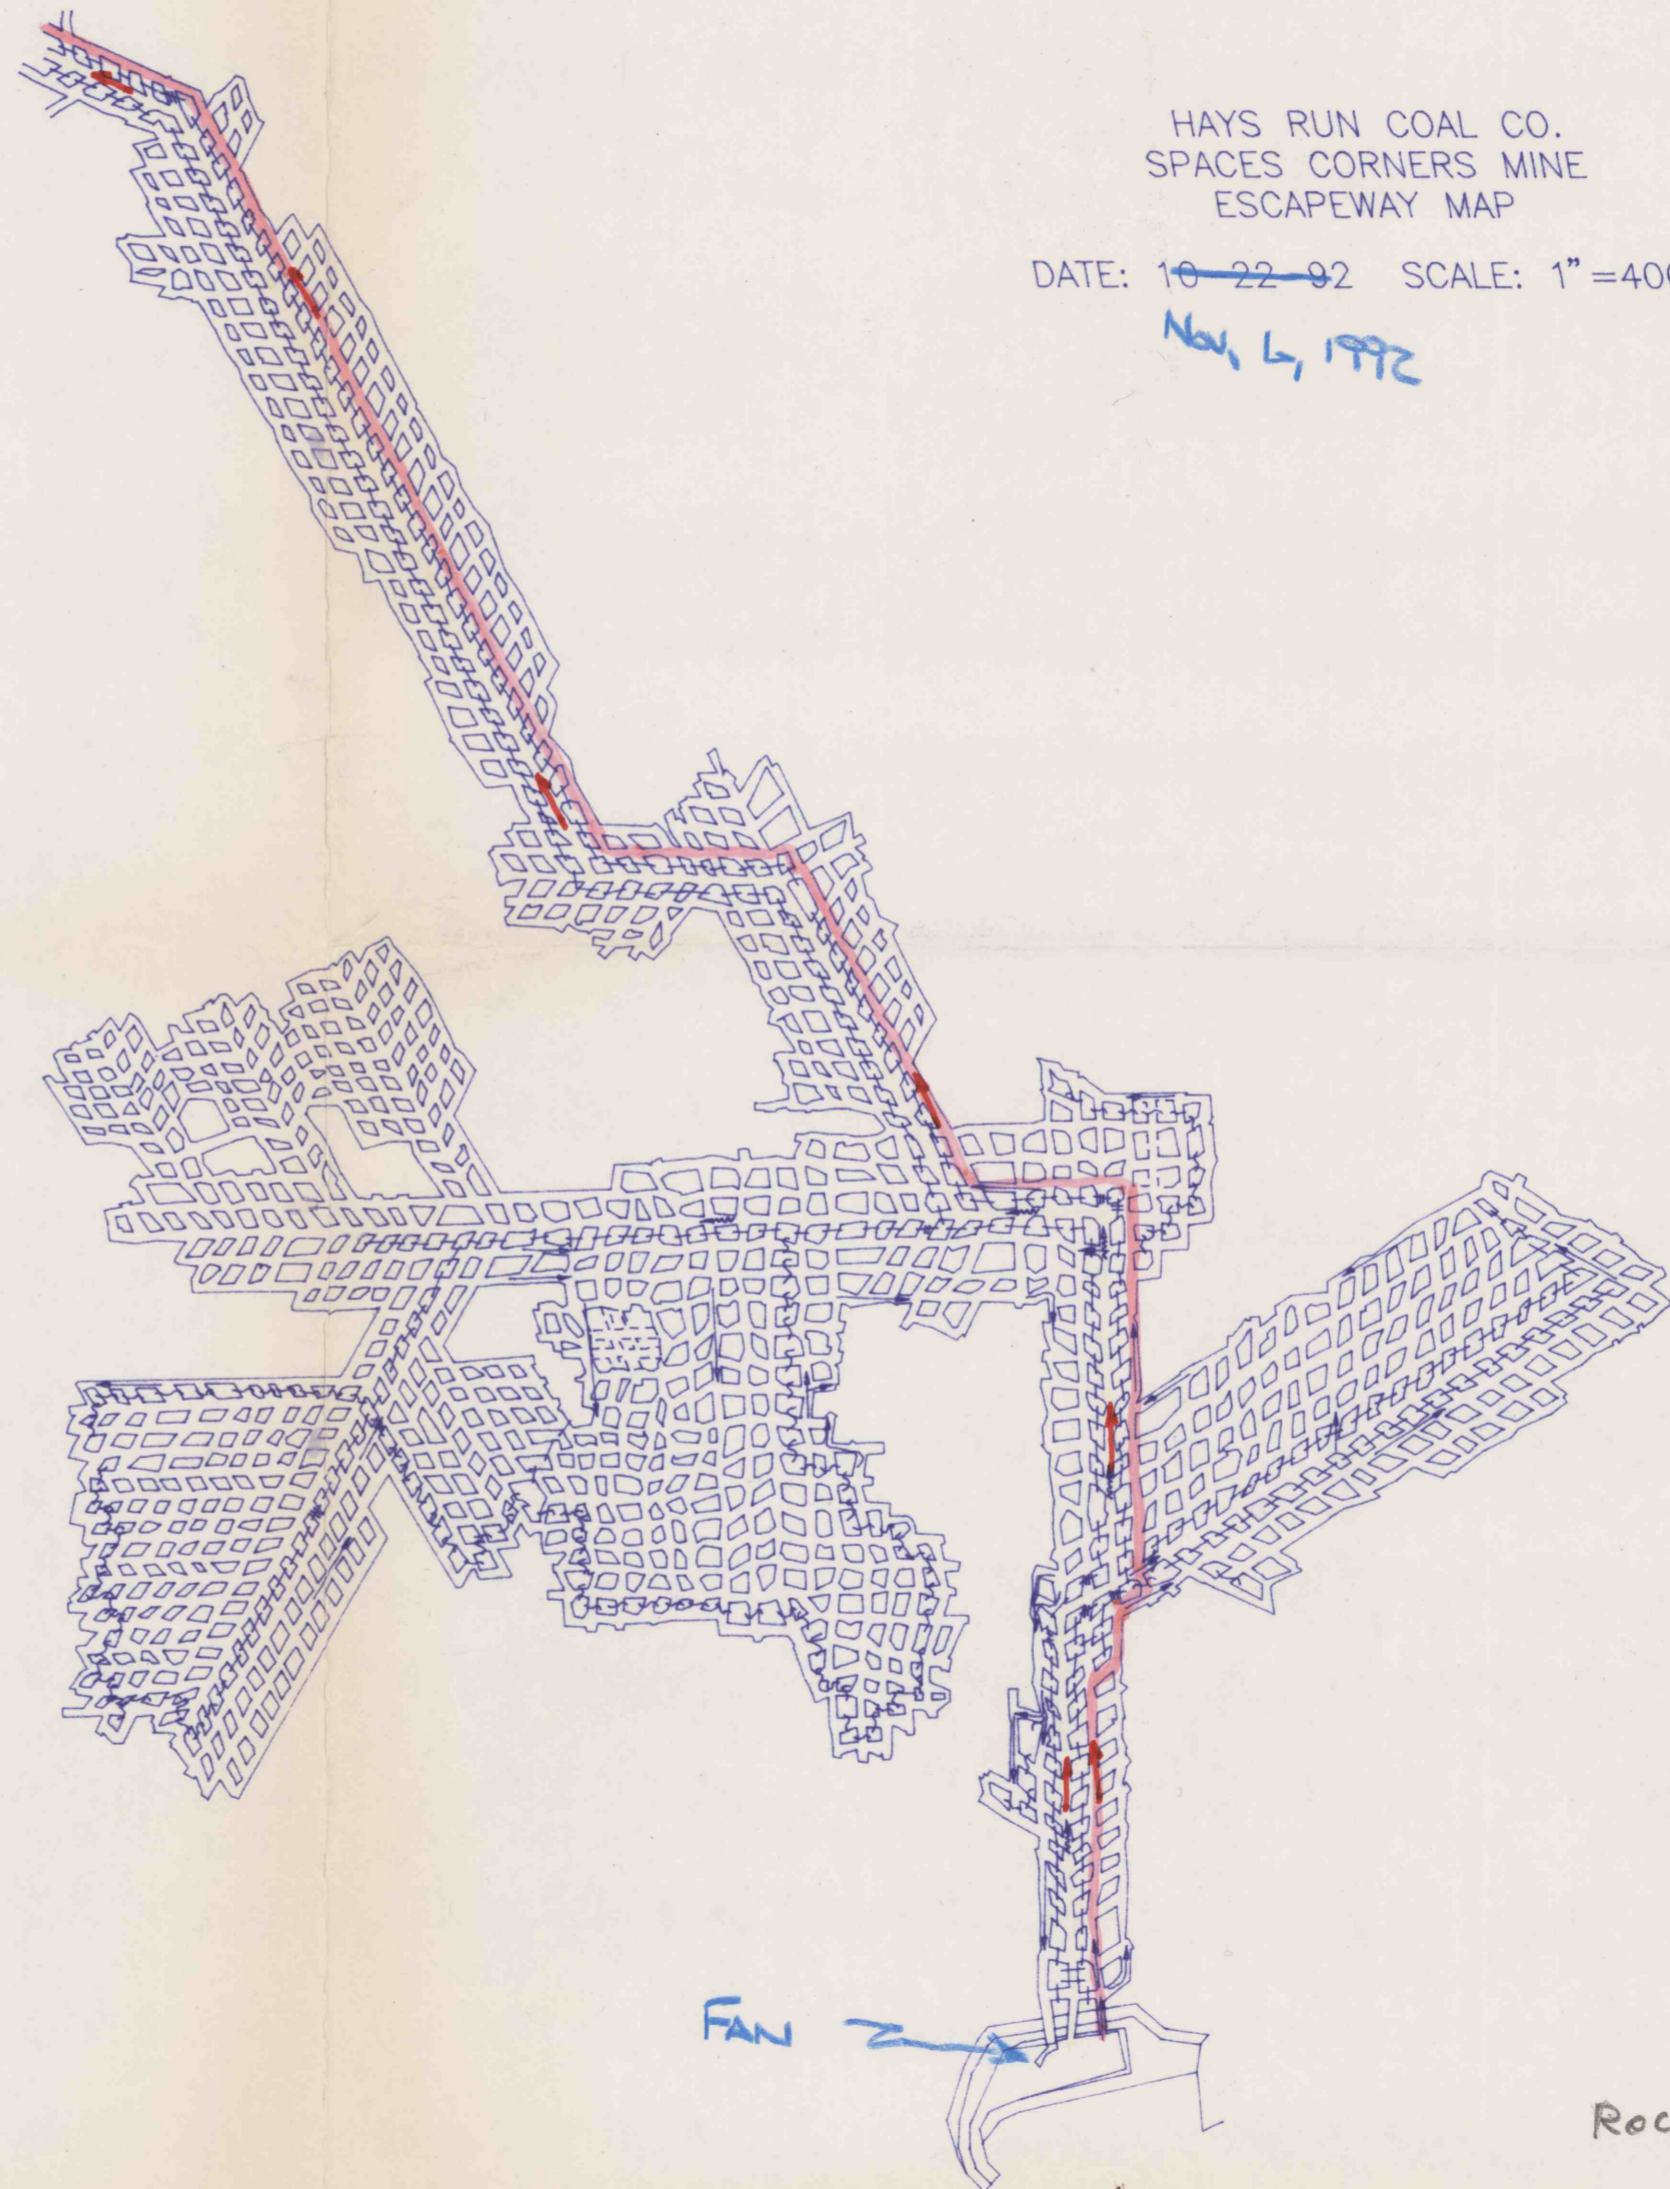

Rec. 11-6-92
DM