


BETHLEHEM MINES CORP.  
MINE NO. 38D (FINAL SURVEY)  
SCALE: 1" = 400' DATE: 4/30/80

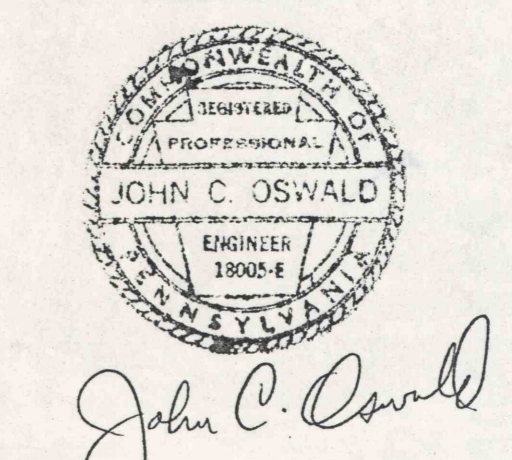

*John C. Oswald*