

*David Alan Coblaugh*

NO. 1 SHAFT  
2 COMPARTMENT  
SEALED


TRACK SLOPE  
SEALED

BELT SLOPE  
SEALED

NO. 2 SHAFT  
2 COMPARTMENT  
SEALED

4 INCH WATER  
MONITORING HOLE

NO. 3 SHAFT  
2 COMPARTMENT  
SEALED

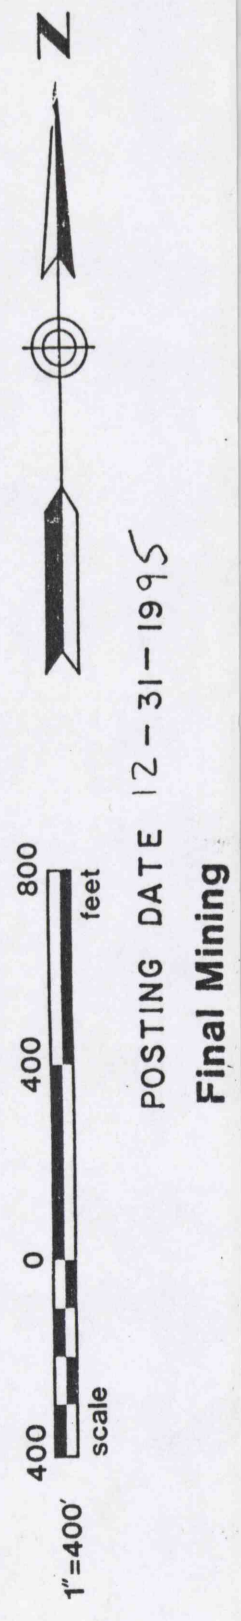

9-3-96  
R.T.A.