




MATCH TO SHEET 31

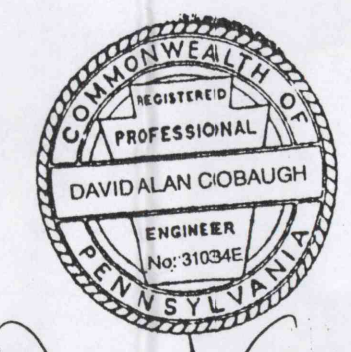

David A. Coblough


2804
J. A. LAMBING
156 A.

JANE MINE (MSHA) No. 3600823
JANE MINE PERMIT (DER) No. 03831305

(COAL SEAM)
LOWER FREEPORT

JANE MINE
KEYSTONE COAL MINING CORP.
PLUMCREEK & COWANSHANOCK TWP. ARMSTRONG CO.

9-3-96
RTA

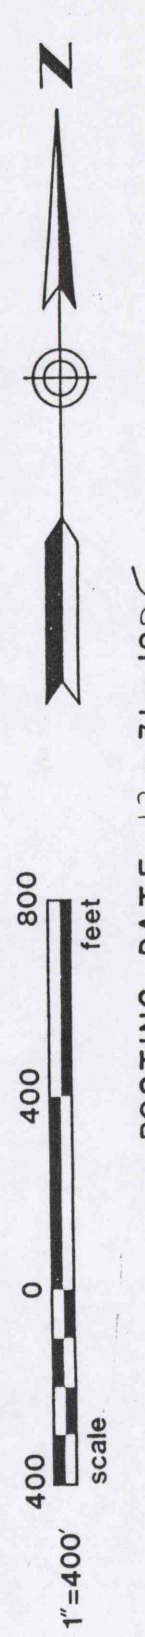

POSTING DATE 12-31-1995
Final Mining