



MATCH TO SHEET 10

MATCH TO SHEET 12



2 INCH WATER MONITORING HOLE

NO. 9 SHAFT 2 COMPARTMENT SEALED

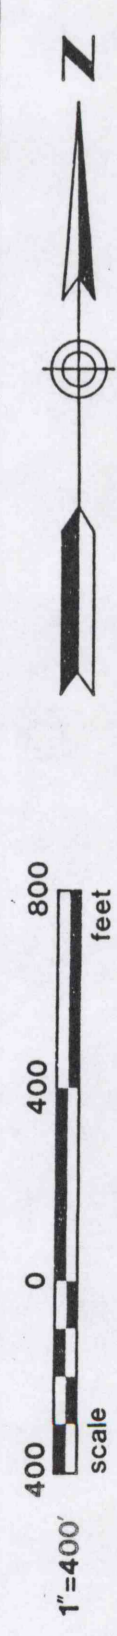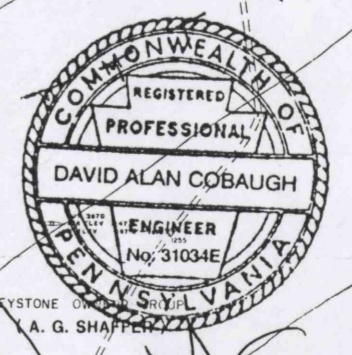

POSTING DATE 1/2 - 31 - 1995
Final Mining

11

11

MATCH TO SHEET 2

MATCH TO SHEET 15

JANE MINE (MSHA) No. 3600823 (COAL SEAM)
 JANE MINE PERMIT (DER) No. 03831305 LOWER FREEPORT PLUMCREEK & COWANSHANNOCK TWP. ARMSTRONG CO.
 KEystone COAL MINING CORP.
 9-3-96
 RTA