


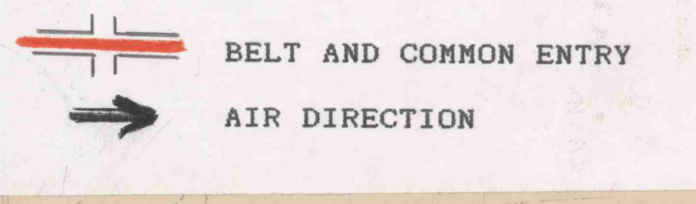

TUNNELTON MINING COMPANY
MARION MINE
BELT & COMMON ENTRY MAP
SCALE 1" = 400'
MAP POSTED 7-1-52
BELTS SHOWN AS OF 11-1-52



RECEIVED
NOV 17 1952
DEPT. OF MINES
FIELD SUPERVISOR