

LEGEND

- LIMIT OF PERMIT AREA
- 100' COVER LINE
- STRUCTURAL INVENTORY KEY NO.
- PROJECTED MINING SEQUENCE 1993
- 1994
- 1995
- 1996
- 1997
- 1998 - 2003

Structural ID Key

- POST -66 DWELLING - D. BUNDY Jr.
- PRE -66 DWELLING - ELVIN M. DINGER
- POST -66 DWELLING - TERRY DINGER
- PRE -66 DWELLING - DARL CARR
- POST -66 TRAILER - GARY L. SHAFFER
- BARN - ELVIN M. DINGER
- BARN - DARL CARR
- SPRING HOUSE - DARL CARR



- 1
- 2
- 3
- 4
- 5
- 6
- 7
- 8
- 9
- 10
- 11

FINAL CLOSURE MAP

MODULE 193
 SUBSIDENCE CONTROL PLAN MAP
KENNEDY COAL COMPANY

Mine no. 4 Portal no. 2
 Perry & Porter Twps. Jefferson Co.
 Scale 1" = 400' Dec. 1992
 SURVEY DATE: 10-29-94

PREPARED BY
VAPCO ENGINEERING
 PUNXSUTAWNEY, PENNSYLVANIA

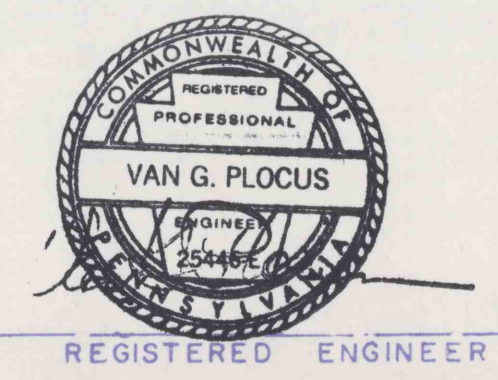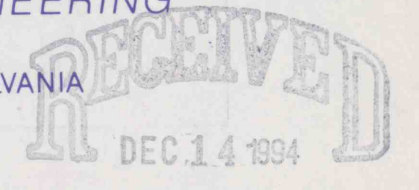

Dept. of Environmental Resources
 McMurray District Office