


- LEGEND**
- 100' BOUNDARY LINE
 - PROPERTY LINE
 - PERMITTING LINE & SUBS. CNTRL. PLAN BOUNDARY
 - HIGH VOLTAGE LINE
 - GAS LINE
 - TOWNSHIP/BOROUGH LINE
 - RAILROAD
 - CREEK
 - STREAM
 - OUTCROP UPPER KITTANNING
 - STRUCTURES
 - DWELLING
 - OTHERS - BARN
 - GARAGE
 - CHURCH
 - CEMETERY
 - LEGISLATIVE ROUTE
 - TOWNSHIP ROAD
 - DRILL HOLES
 - CORE DRILLED
 - ROTARY CORE RECD
 - ROTARY LOGGED
 - SURFACE MINE
 - COAL CONTOUR
 - PROPERTY INDEX
 - SURFACE SUPPORT AREA
 - WELLS
 - BARRIER WIDTH
 - MONITORING SAMPLE
 - BACKGROUND SAMPLE
 - ORIGINAL PERMIT LINE
 - 100' COVER LINE
 - PERMIT LINE & SUBS. CNTRL. PLAN BOUNDARY - REVISED AUG. 1991

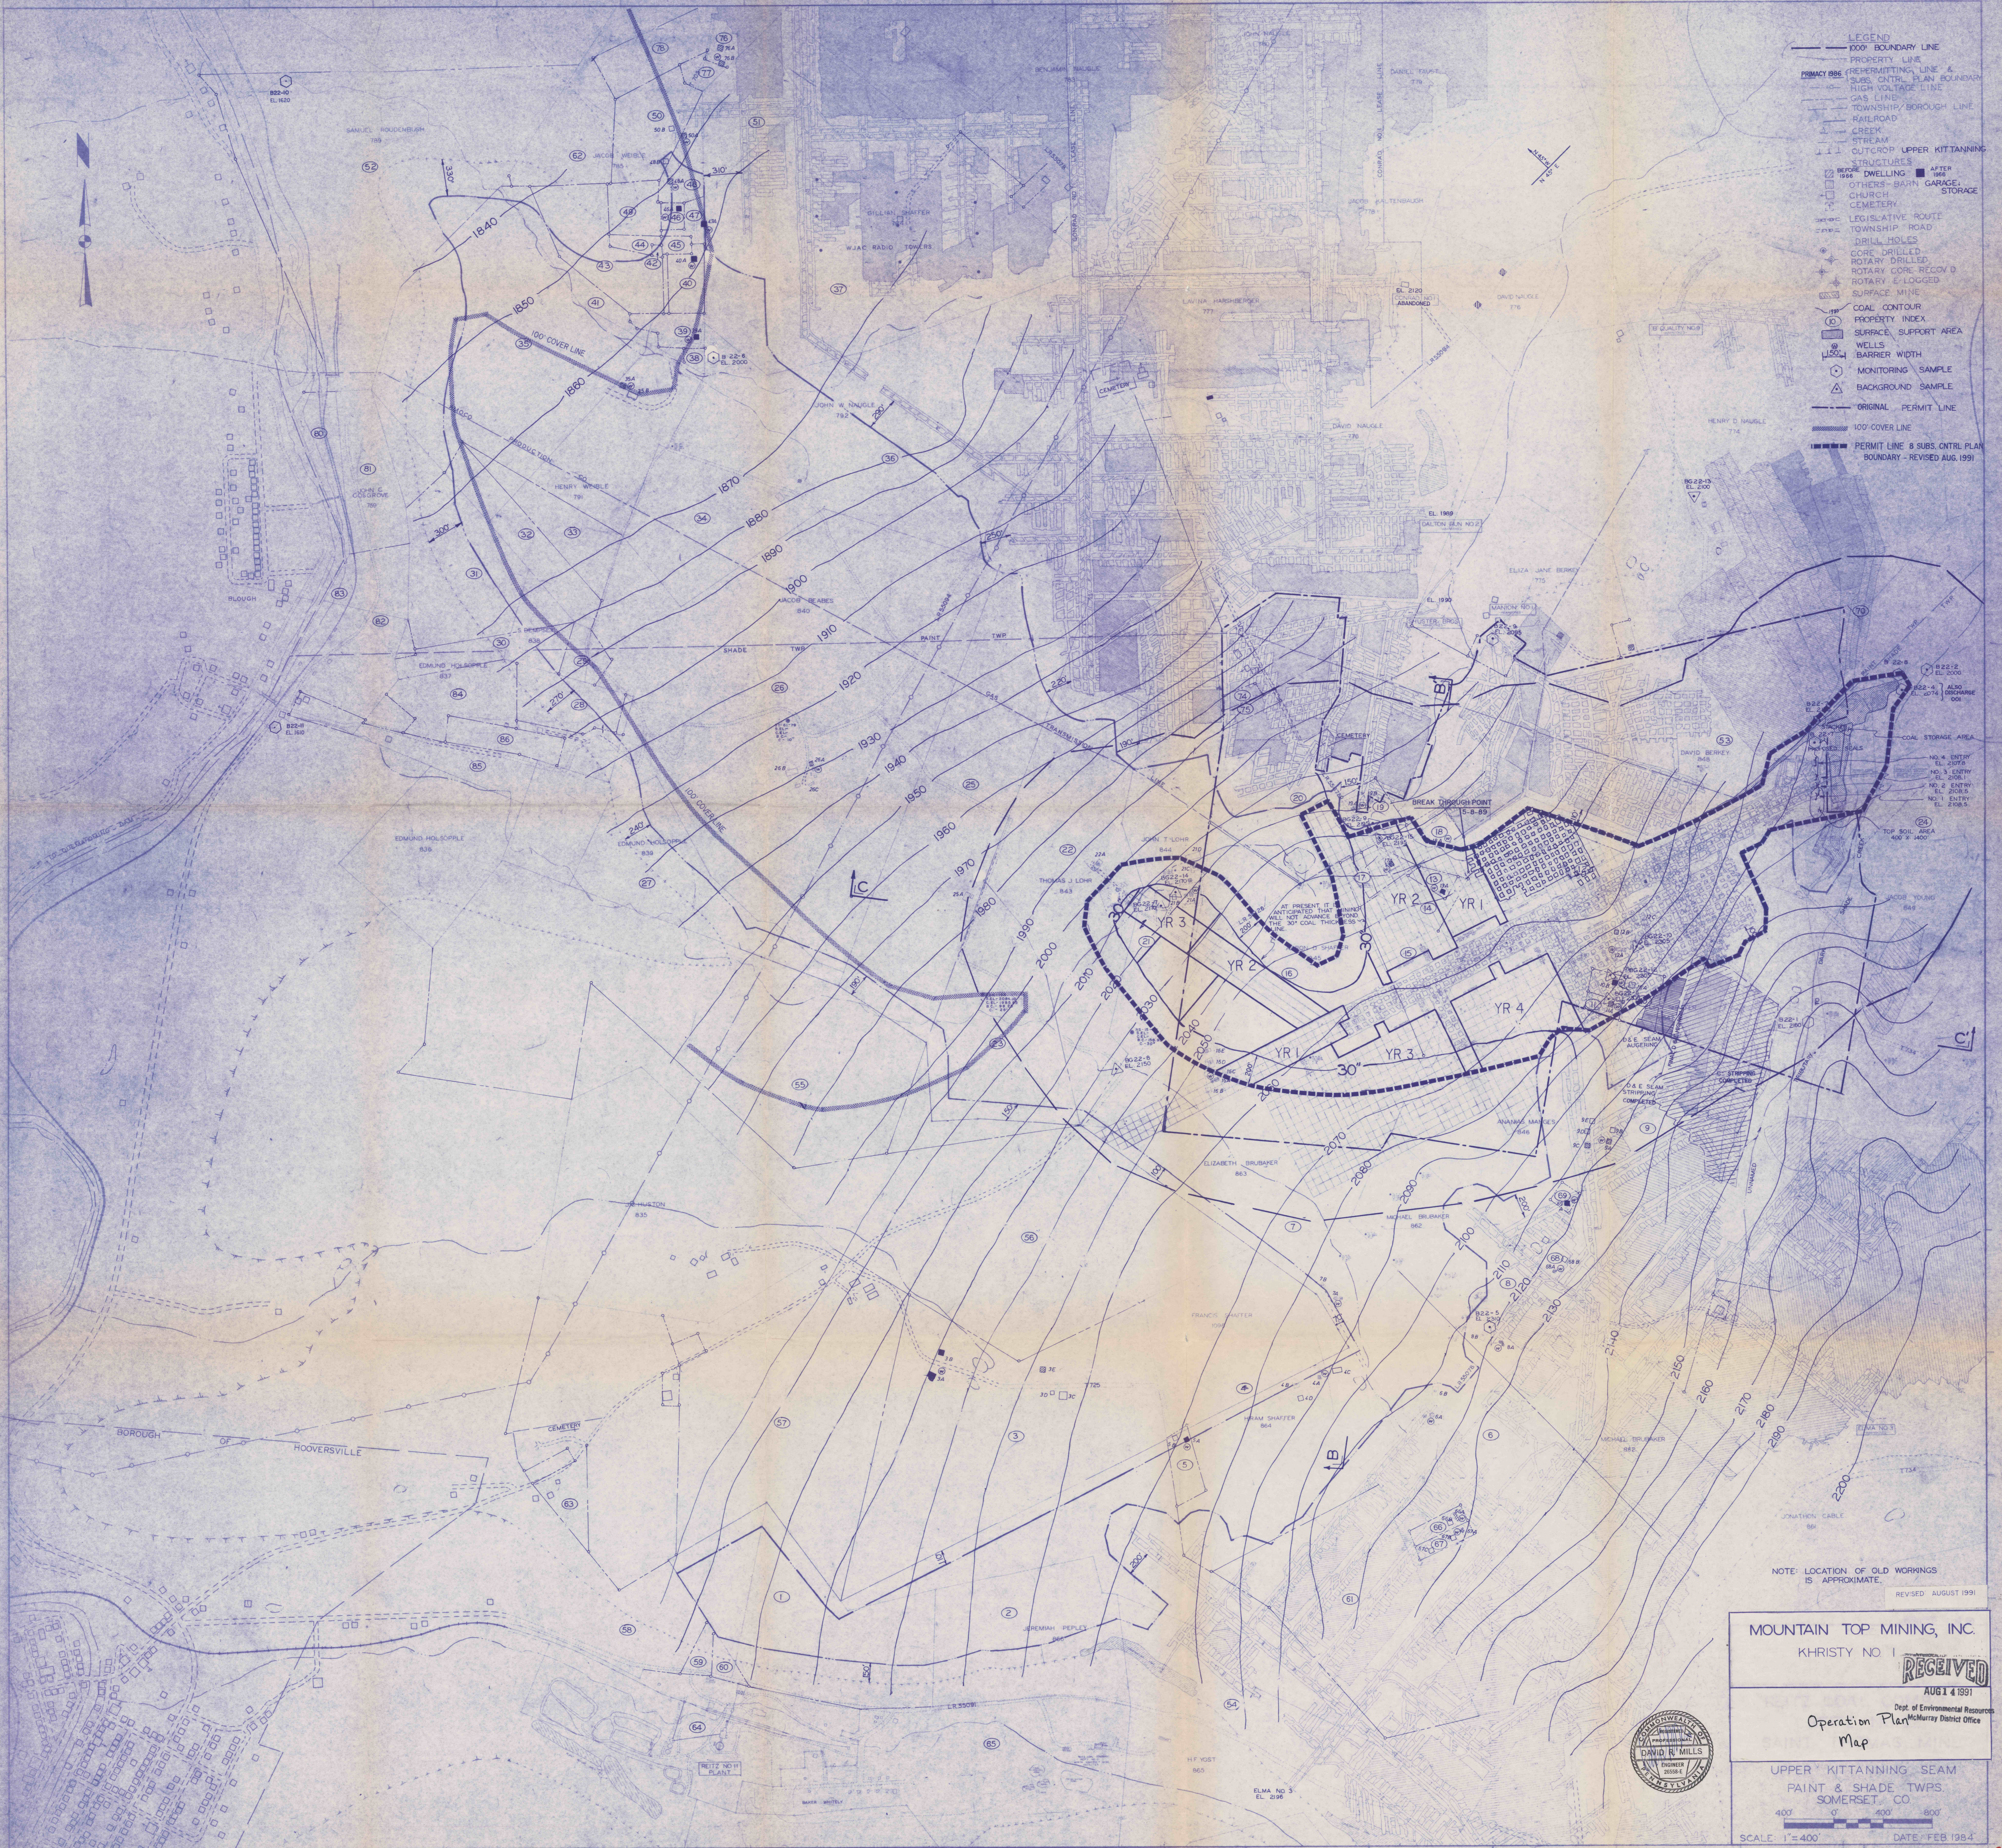

AT PRESENT IT IS ANTICIPATED THAT THE ADVANCE BEYOND THIS COAL THRESHOLD WILL NOT BE MADE.

NOTE: LOCATION OF OLD WORKINGS IS APPROXIMATE.
REVISED AUGUST 1991

MOUNTAIN TOP MINING, INC.
KHRISTY NO 1

RECEIVED
AUG 14 1991
Dept. of Environmental Resources
McMurray District Office

Operation Plan
Map

UPPER KITTANNING SEAM
PAINT & SHADE TWPS.
SOMERSET CO.

SCALE: 1"=400' DATE: FEB 1984

