


- LEGEND**
- 1000' BOUNDARY LINE
 - PROPERTY LINE
 - PERMITTING LINE & SUBS. CNTRL. PLAN BOUNDARY
 - HIGH VOLTAGE LINE
 - GAS LINE
 - TOWNSHIP/BOROUGH LINE
 - RAILROAD
 - CREEK
 - STREAM
 - OUTCROP UPPER KITTANNING
 - STRUCTURES
 - BEFORE 1966 DWELLING
 - AFTER 1966 DWELLING
 - OTHERS - BARN, GARAGE, CHURCH, CEMETERY
 - LEGISLATIVE ROUTE
 - TOWNSHIP/ROAD
 - DRILL HOLES
 - CORE DRILLED
 - ROTARY DRILLED
 - ROTARY CORE RECOV'D
 - ROTARY E-LOGGED
 - SURFACE MINE
 - COAL CONTOUR
 - PROPERTY INDEX
 - SURFACE SUPPORT AREA
 - WELLS
 - BARRIER WIDTH
 - MONITORING SAMPLE
 - SAMPLE PTS. B22-6, 6, 10, 8, 11 EXCLUDED FROM BACKGROUND SAMPLE
 - ORIGINAL PERMIT LINE
 - 100' COVER LINE
 - PERMIT LINE 8 SUBS. CNTRL. PLAN BOUNDARY - REVISED AUG. 1991

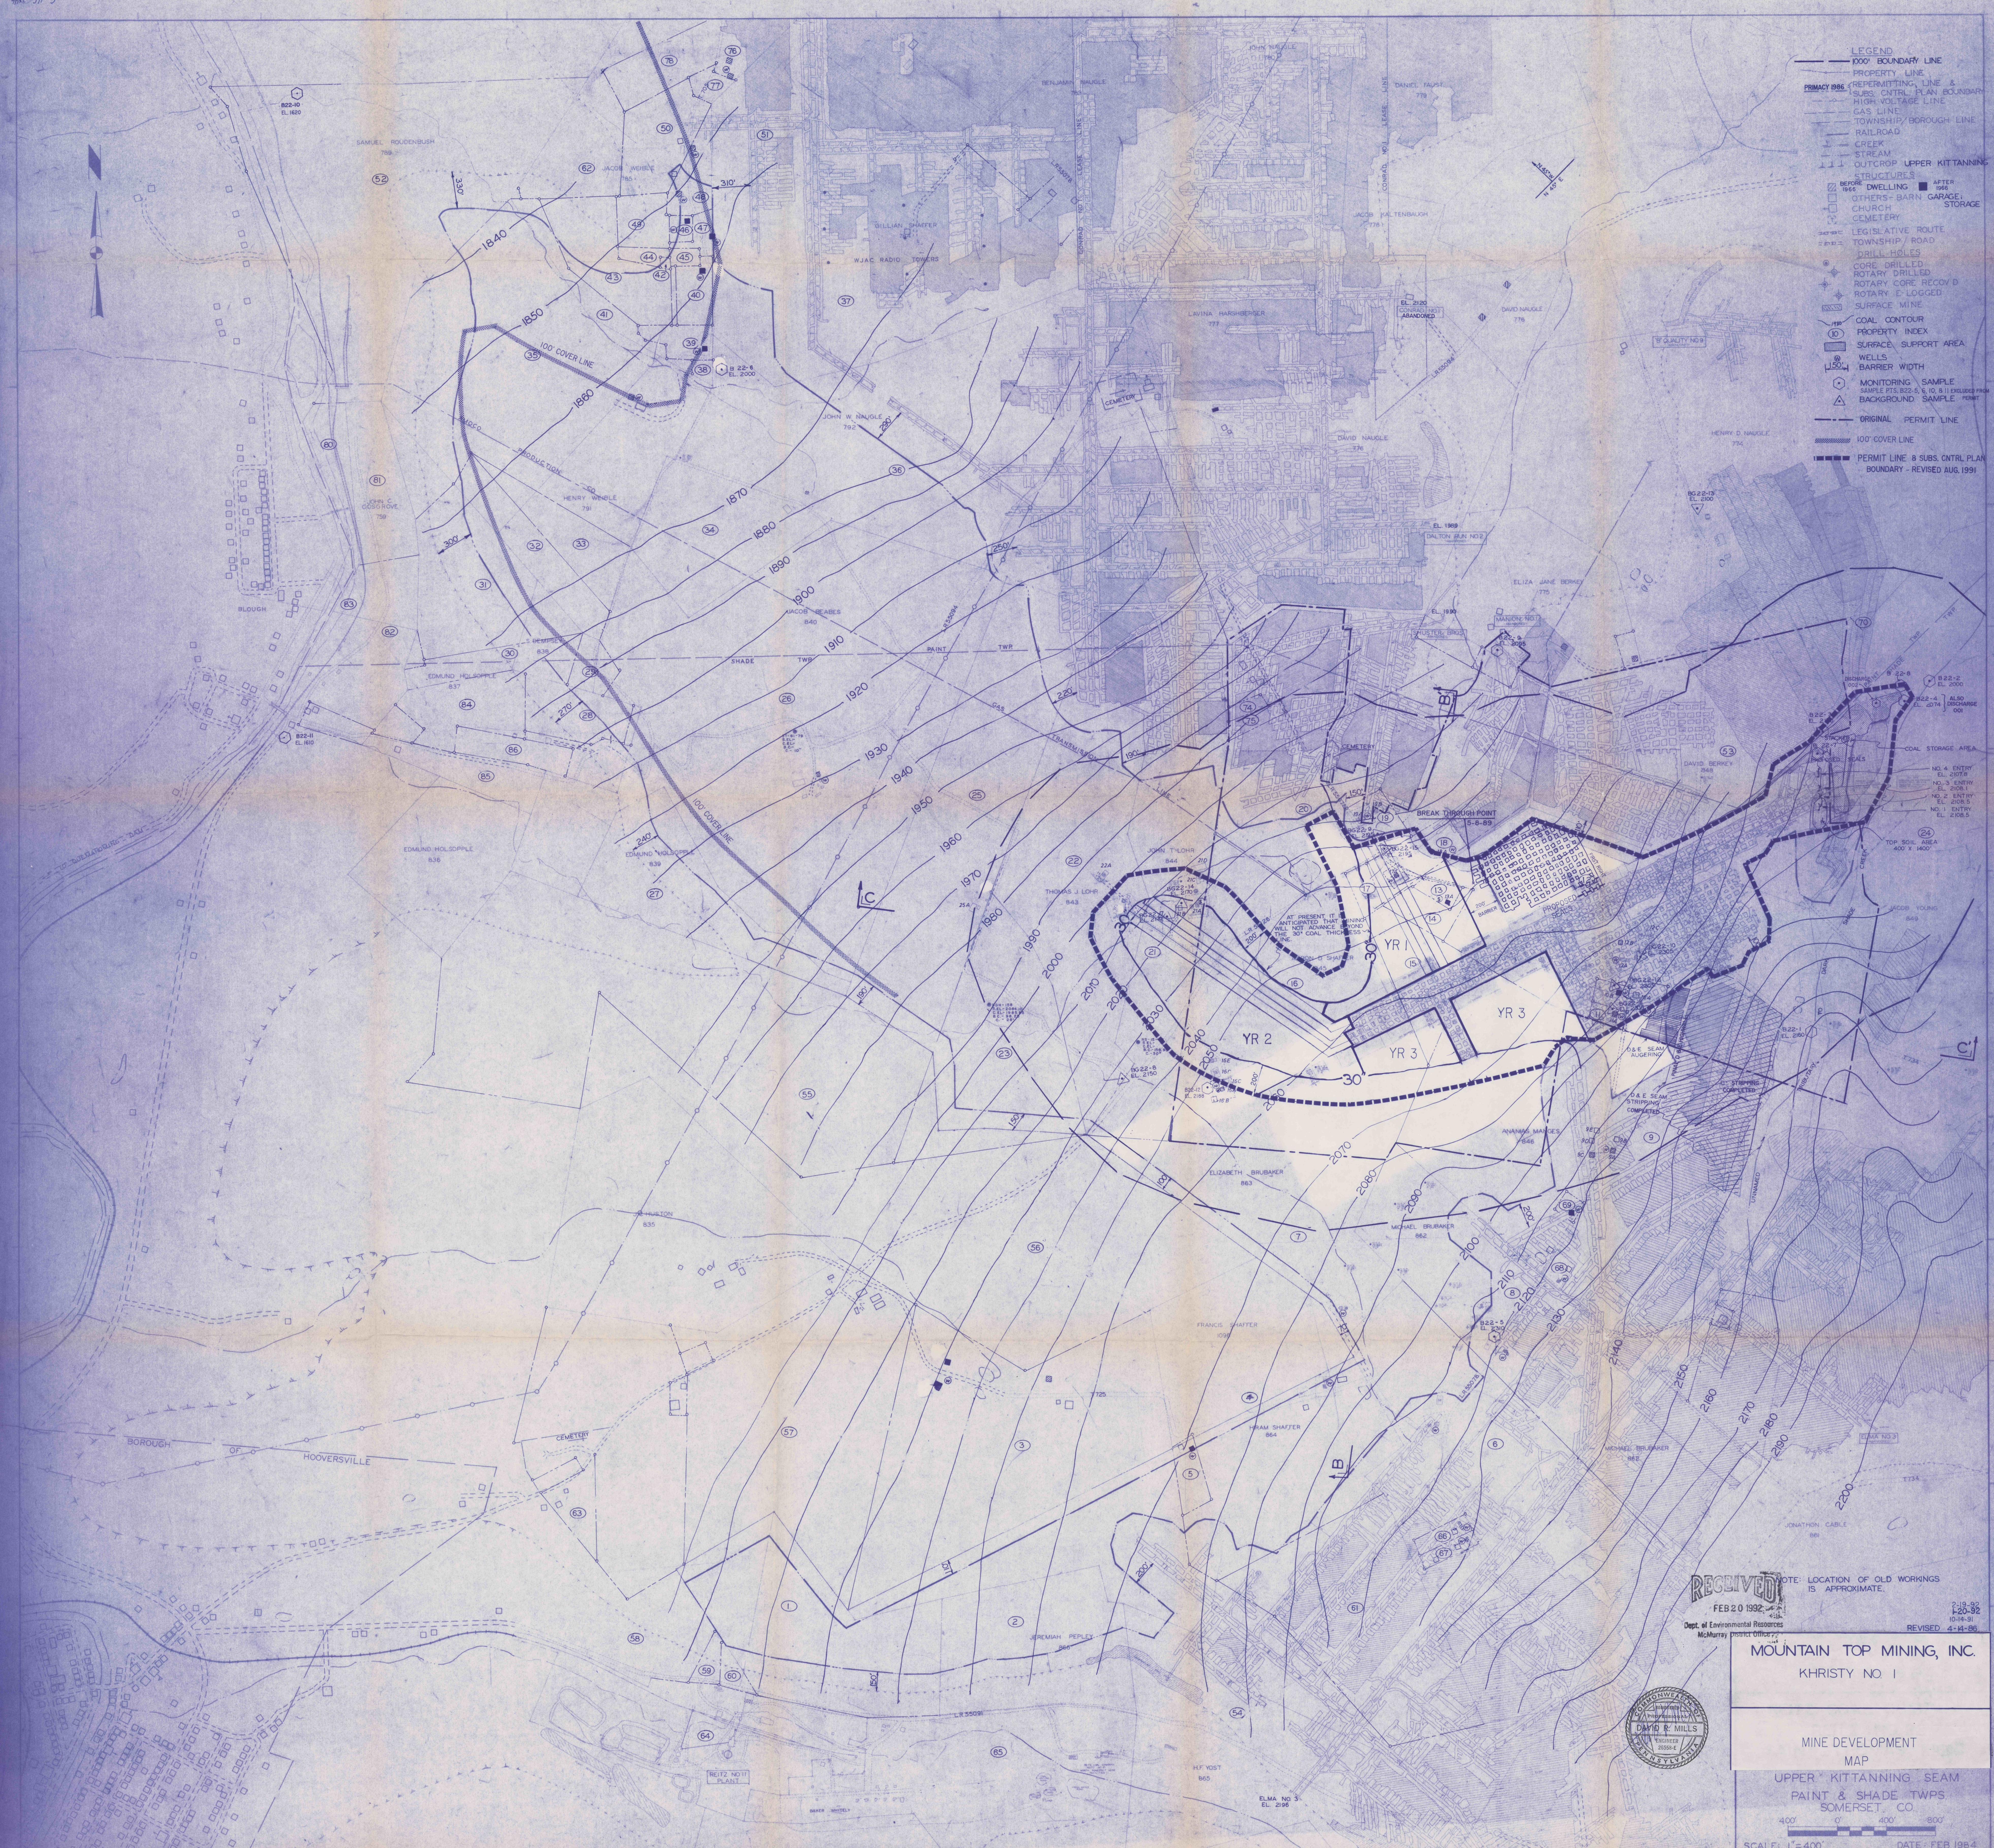

RECEIVED
 FEB 20 1992
 Dept. of Environmental Resources
 McMurry District Office

NOTE: LOCATION OF OLD WORKINGS IS APPROXIMATE.

MOUNTAIN TOP MINING, INC.
 KHRISTY NO. 1

MINE DEVELOPMENT
 MAP
 UPPER KITTANNING SEAM
 PAINT & SHADE TWPS
 SOMERSET CO.

SCALE: 1"=400' DATE: FEB 1994



C-14-261