




FINAL MINE MAP
 (LAST DAY WORKED: OCT 4, 1999)

B & M COAL COMPANY
No. 2 MINE
 SEWICKLEY SEAM SCALE: 1"=400'
 DUNKARD TWP., GREENE CO., PA.
 CMAP # 30841311

MAP LEGEND

- 2 ■ PROTECTED SURFACE STRUCTURE IN PLACE APRIL 1966
- 6 □ SURFACE DWELLING IN PLACE AFTER APRIL 1966
- 20 □ ALL OTHER SURFACE BUILDINGS OR COMMERCIAL BUILDINGS
- GAS OR OIL WELLS
- BORE HOLE BY MINE OWNERS INTO MINE OPENING
- △ DRILL HOLE BY OTHERS
- SEWICKLEY COAL OUTCROP
- 900' --- 900' KNOWN SEWICKLEY COAL CONTOURS
- 900' --- 900' ESTIMATED SEWICKLEY COAL CONTOURS
- OUTLINE OF MINE PROPERTY
- - - - - OUTLINE 5 YEAR SUBSIDENCE CONTROL PLAN
- ▲ GEOLOGIC BATHOLITH
- ▲ N.P.D.E.S. MONITORING POINT LOCATION
- ▲ PROTECTED SURFACE STRUCTURE - 50' YEAR OF MINING AND TYPE OF MINING
- ▲ PROTECTED SURFACE STRUCTURE - 70' YEAR OF MINING
- ▲ INTAKE AIR
- ▲ RETURN AIR
- ▲ FLECKER AIR
- ▲ PROPOSED FINAL MINE SEALS (SEE EXHIBIT 6.5)
- SURFACE WATER MONITORING POINT
- ADJACENT MINE'S WATER DISCHARGE POINT
- SYMBOLS FOR OTHER MINING OPERATIONS

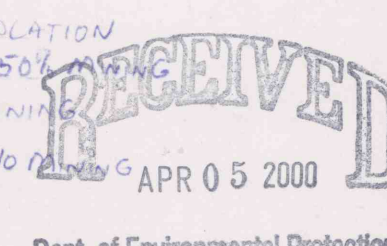

Robert M. Hoff
 April 11, 2000

- NOTES:**
1. THE LIMITS OF ALL MINES SHOWN ON THIS MAP ARE WITHIN THE CONFINES OF DUNKARD TOWNSHIP.
 2. THERE ARE NO AREAS OVER ANY OF THE ACTIVE MINES ON THIS MAP THAT HAVE BEEN DECLARED UNSUITABLE FOR MINING. COAL GAS WELLS EXCLUDED.
 3. THERE ARE NO MAJOR AQUIFERS WHICH SERVE AS SIGNIFICANT SOURCES OF WATER SUPPLY TO PUBLIC WATER SYSTEMS.
 4. THE LIMITS OF SEWICKLEY SEAM DEEP AND STRIP MINES ARE SHOWN ON THIS MAP.
 5. THERE ARE NO KNOWN INDIAN BURIAL GROUNDS WITHIN THE PROPOSED PERMIT AREA.

E 330.0

E 0530

E 280.0

E 2530