


GAS WELL  
WES-23101  
DO NOT MINE

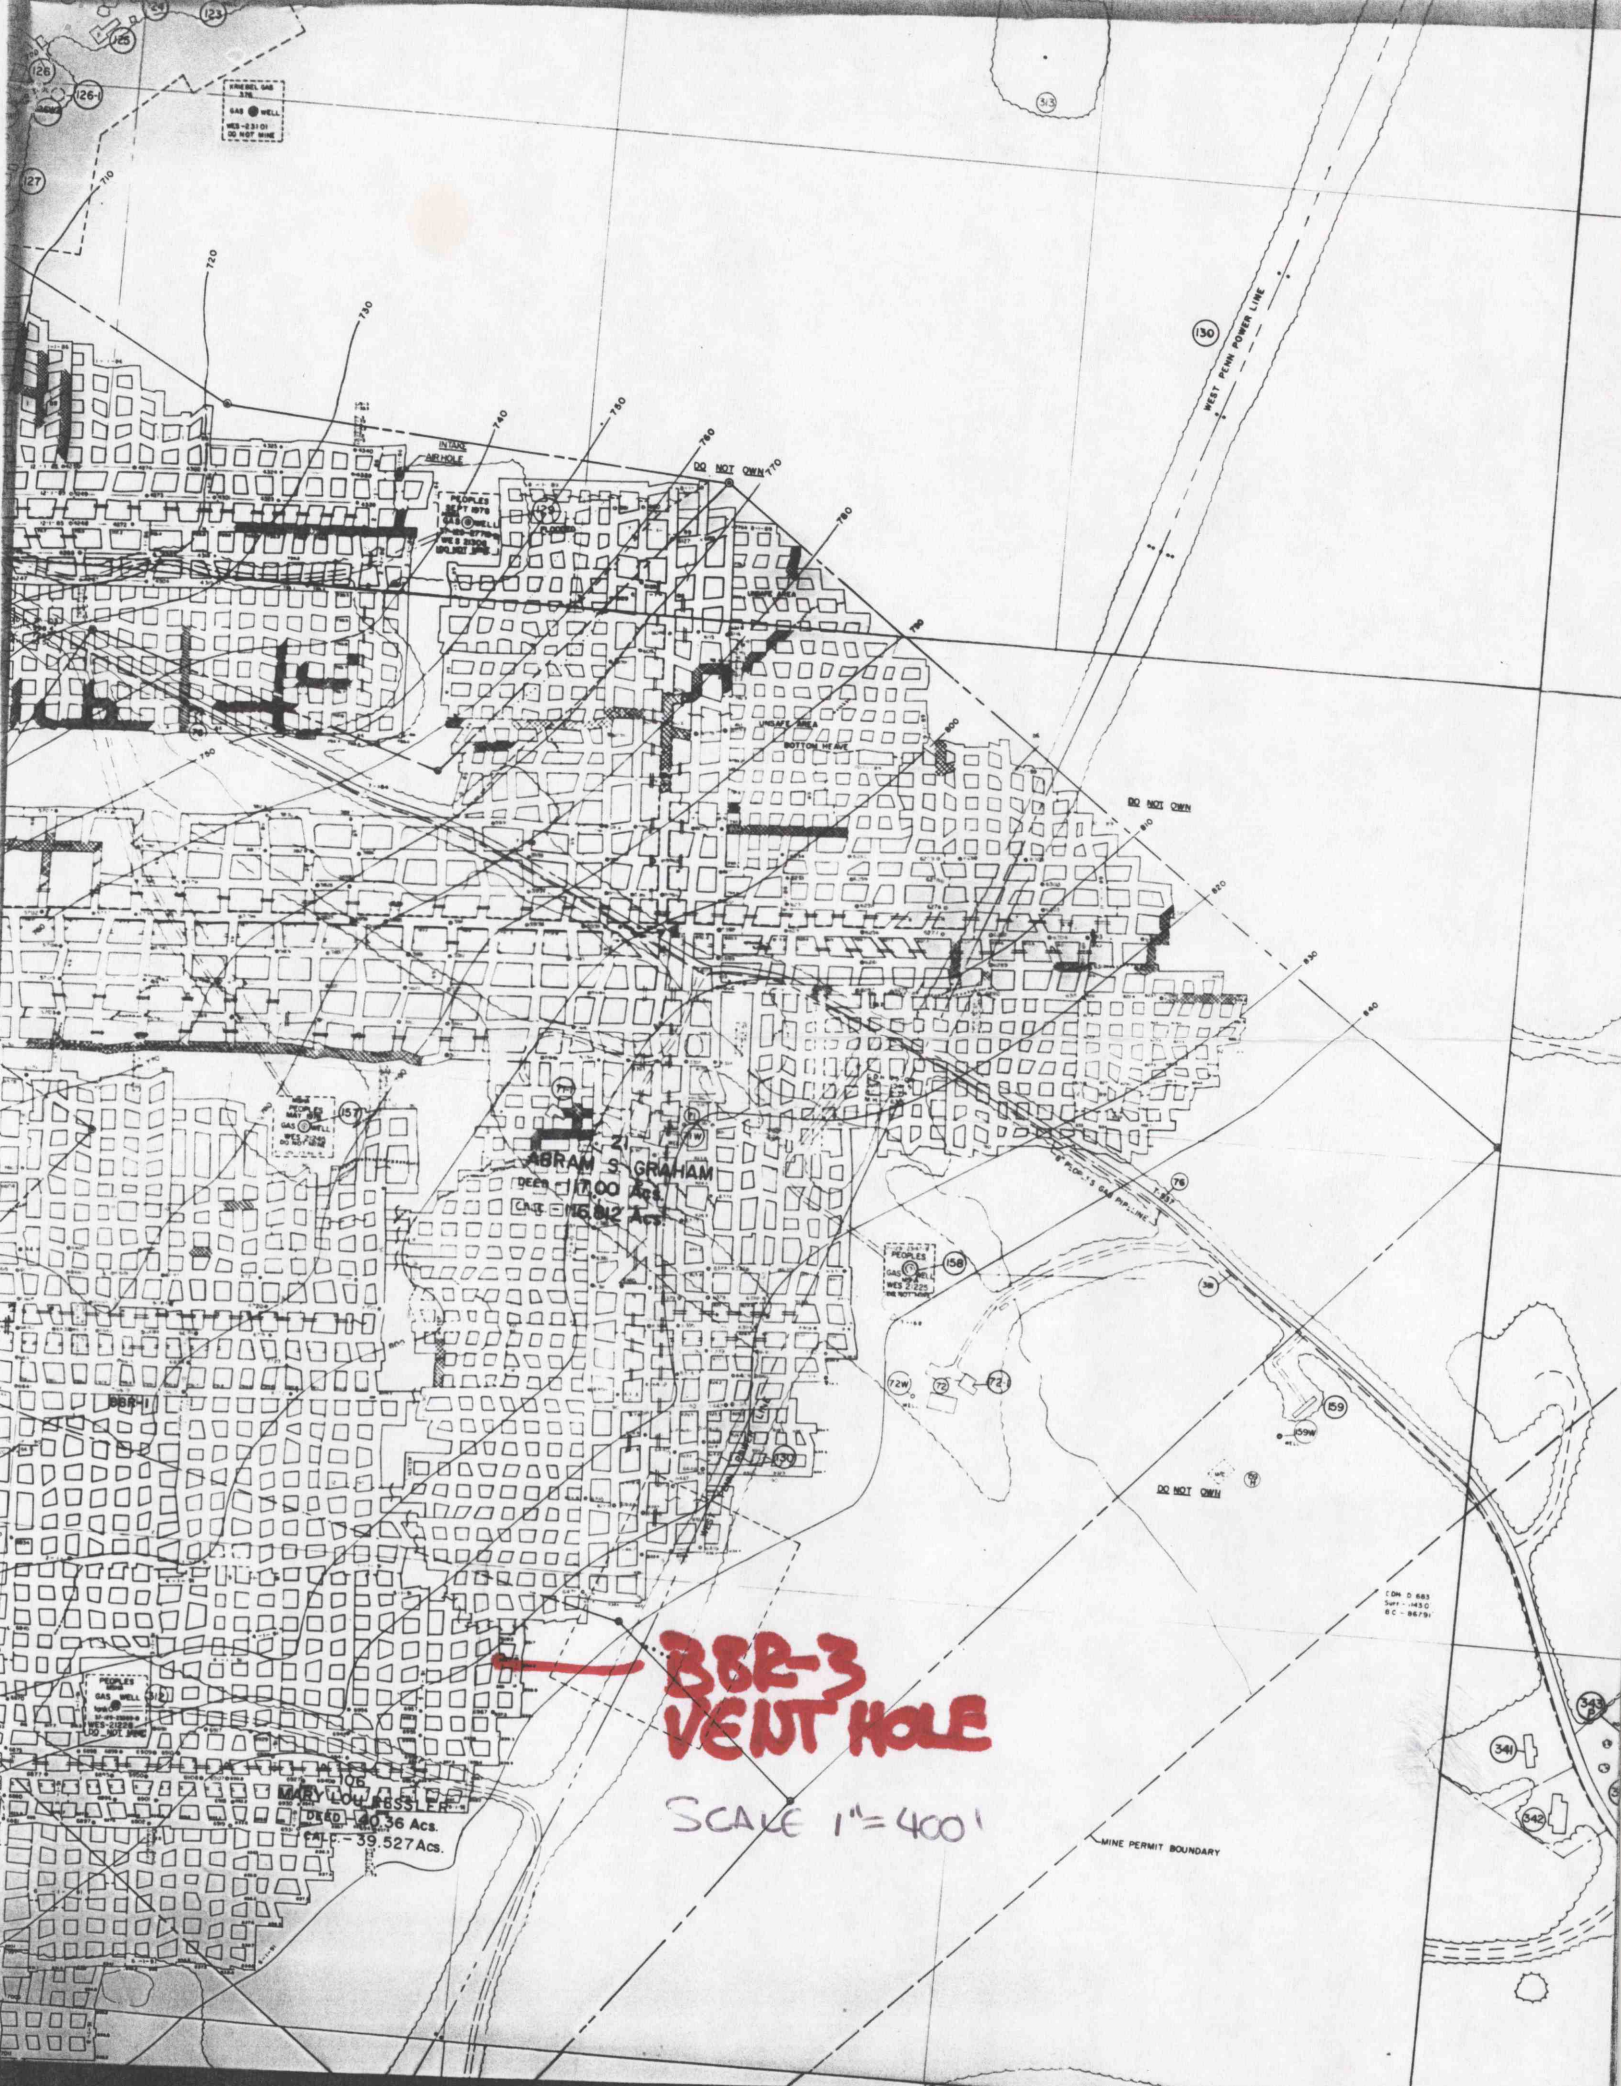

BBR-3  
VENT HOLE

SCALE 1" = 400'


MINE PERMIT BOUNDARY

CON. D. 683  
SPP-1482  
S.C. - 8679