


L-7-94


L-7-94-A

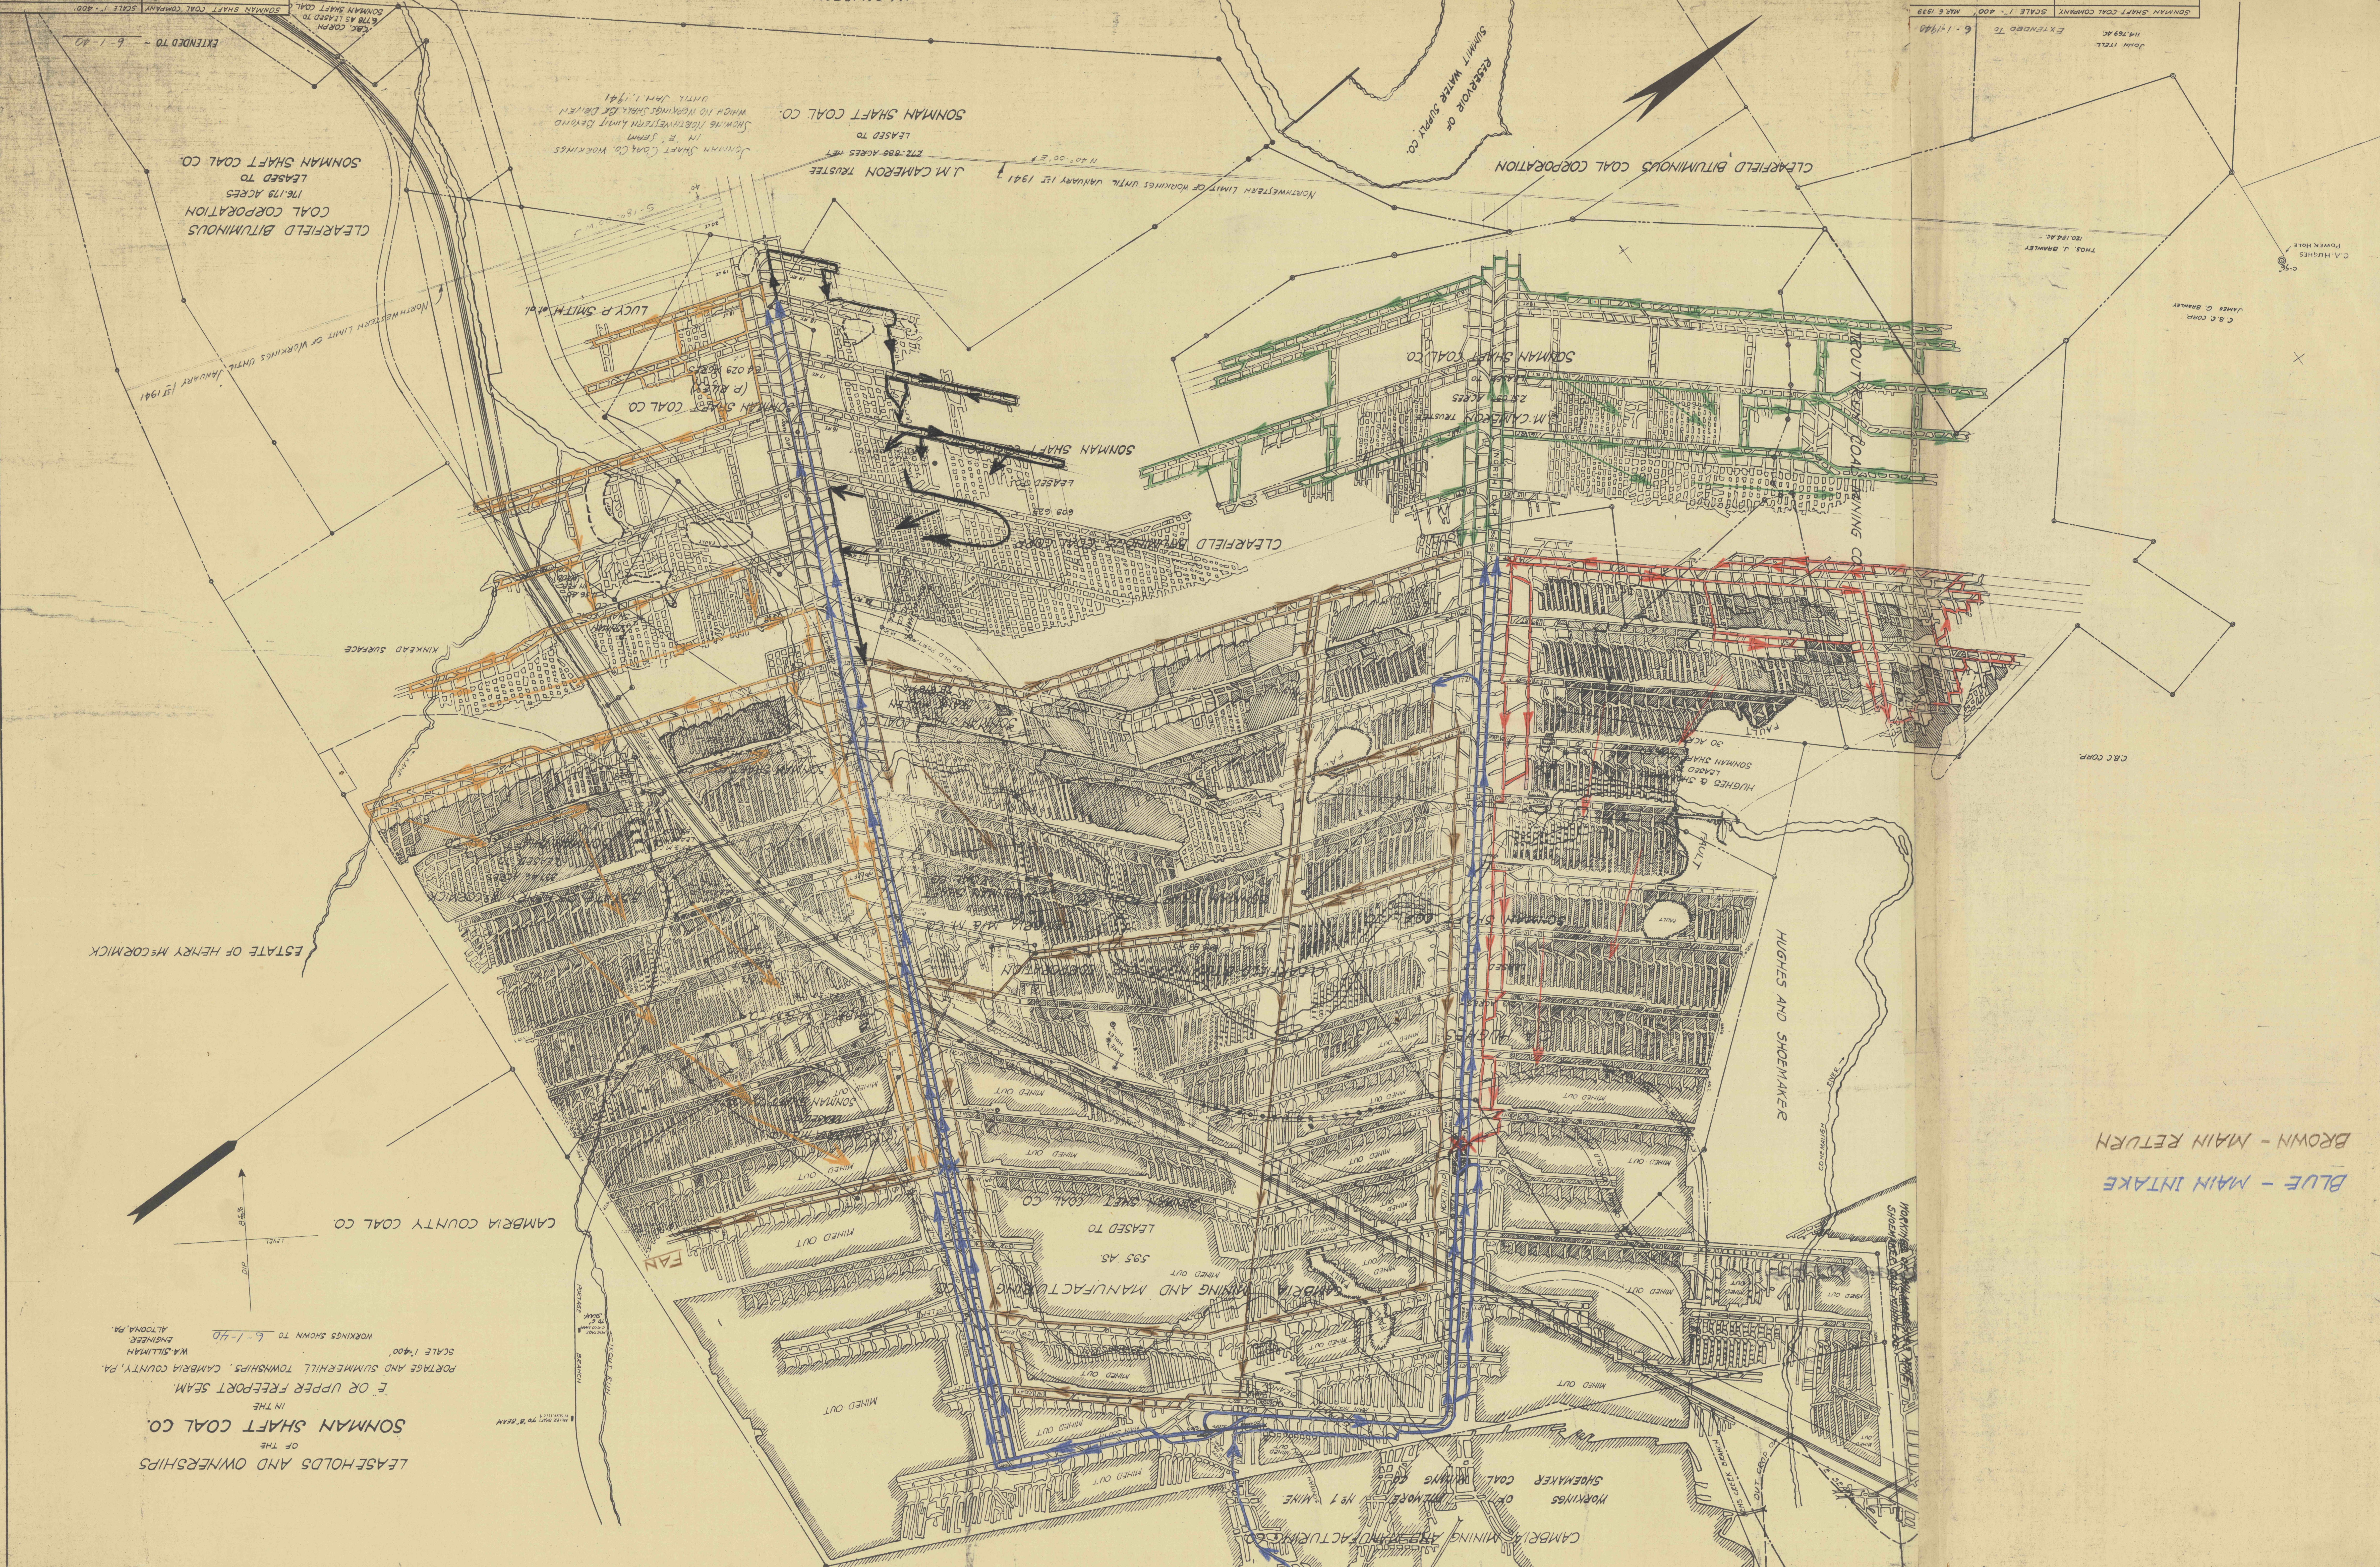

LEASHEOLDS AND OWNERSHIPS
OF THE
SONNMAN SHAFT COAL CO.
IN THE
E OR UPPER FREEPORT SEAM.
PORTAGE AND SUMMERHILL TOWNSHIPS, CAMBRIA COUNTY, PA.
ENGINEER
W.A. SILLIMAN
ALTOONA, PA.

WORKINGS SHOWN TO 6-1-40

CAMBRIA COUNTY COAL CO.

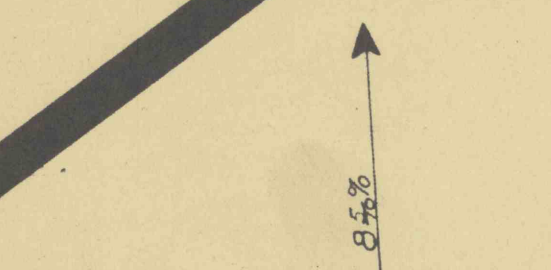

BLUE - MAIN INTAKE
BROWN - MAIN RETURN

HUGHES AND SHOENMAKER

CAMBRIA MINING AND MANUFACTURING CO.
SHOENMAKER COAL MINING CO.
WORKINGS OF
SHOENMAKER NO 1 MINE

CAMBRIA MINING AND MANUFACTURING CO.

LEASD TO
595 AS

SONNMAN SHAF COAL CO.

FAN

CAMBRIA COUNTY COAL CO.

ESTATE OF HENRY M^{RS} CORMICK

KINKSAID SURFACE

CLEARFIELD BITUMINOUS COAL CORPORATION

SONNMAN SHAFT COAL CO.

SONNMAN SHAF COAL CO.

LUCY P. SMITH

CLEARFIELD BITUMINOUS
COAL CORPORATION
176.19 ACRES
LEASD TO
SONNMAN SHAFT COAL CO.

SONNMAN SHAFT COAL CO.
LEASD TO
J.M. CAMERON TRUSTEE
272.889 ACRES NET

SONNMAN SHAFT COAL CO. WORKINGS
IN THE SEAM
SHOWING NORTHEASTERN LIMIT DRAWING
WHICH IS WORKINGS SHOWN AS DRAWING
UNTIL JAN 1, 1941

CLEARFIELD BITUMINOUS COAL CORPORATION

SONNMAN SHAFT COAL CO.

SONNMAN SHAFT COAL CO.

C.B.C. CORP.



C.B.C. CORP.
THOS. J. BIRNBAUM
POWER HOUSE

10.18 AC.

14.769 AC.

EXTENDED TO 6-1-1940

SCALE 1\"/>

PRODUCTION IN THE

SEAM

SONNMAN SHAFT COAL COMPANY






