


L-7-94

L-7-94-A

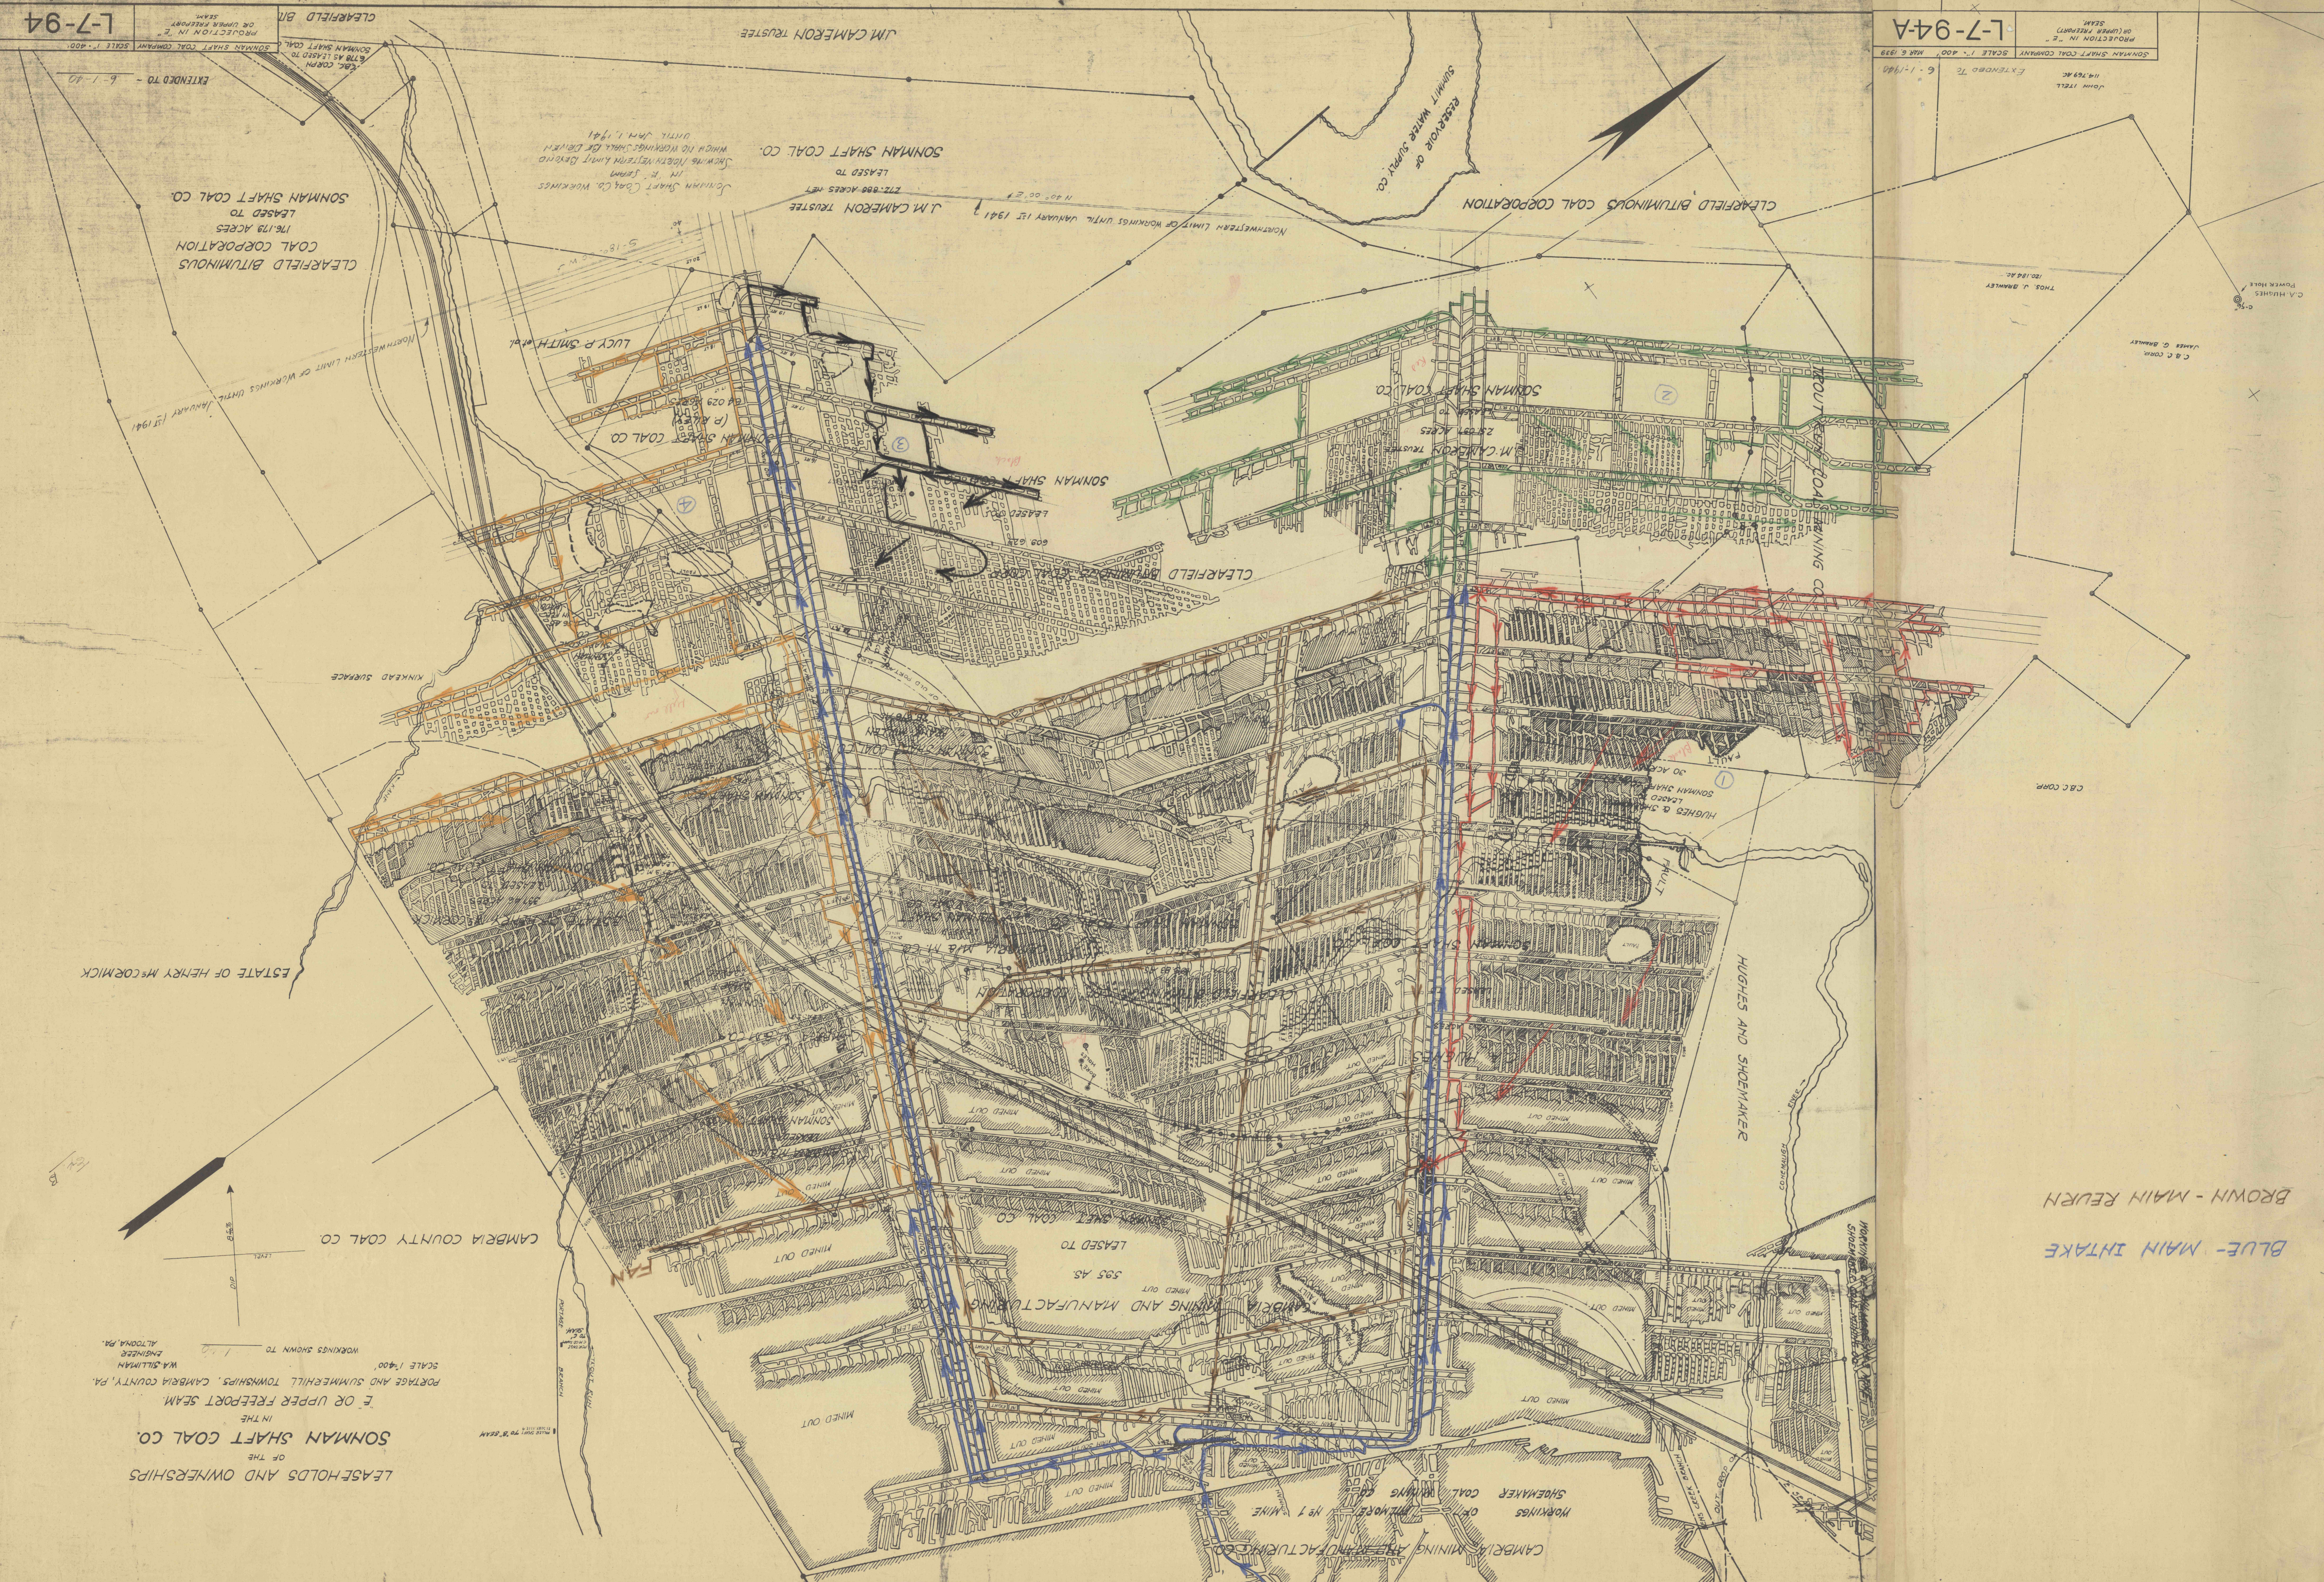

LEASHELD AND OWNERSHIPS OF THE SONMAN SHAFT COAL CO. IN THE E OR UPPER FREEPORT SEAM PORTAGE AND SUMMERHILL TOWNSHIPS, CAMBERIA COUNTY, PA. ENGINEER W.A. SULLIVAN SCALE 1/400 WORKINGS SHOWN TO 1/200

CAMBERIA COUNTY COAL CO.

BROWN - MAIN RETURN
 BLUE - MAIN INTAKE

J.M. CAMERON TRUSTEE
 LEASED TO SONMAN SHAFT COAL CO.
 272.886 ACRES NET
 NORTHWESTERN LIMIT OF WORKINGS UNTIL JANUARY 1ST 1941
 J.M. CAMERON TRUSTEE
 LEASED TO SONMAN SHAFT COAL CO.
 25.597 ACRES
 NORTHWESTERN LIMIT OF WORKINGS UNTIL JANUARY 1ST 1941

SONMAN SHAFT COAL COMPANY SCALE 1" = 400' MAR 6, 1939
 PROJECTION IN "E" OR UPPER FREEPORT SEAM
 L-7-94-A
 6-1-1940
 EXTENDED TO

CLEARFIELD BITUMINOUS COAL CORPORATION
 LEASED TO SONMAN SHAFT COAL CO.
 176.178 ACRES
 NORTHWESTERN LIMIT OF WORKINGS UNTIL JANUARY 1ST 1941

HUGHES AND SHOEMAKER

CAMBERIA MINING AND MANUFACTURING CO.
 WORKINGS OF HUGHES AND SHOEMAKER
 No 1 MINE