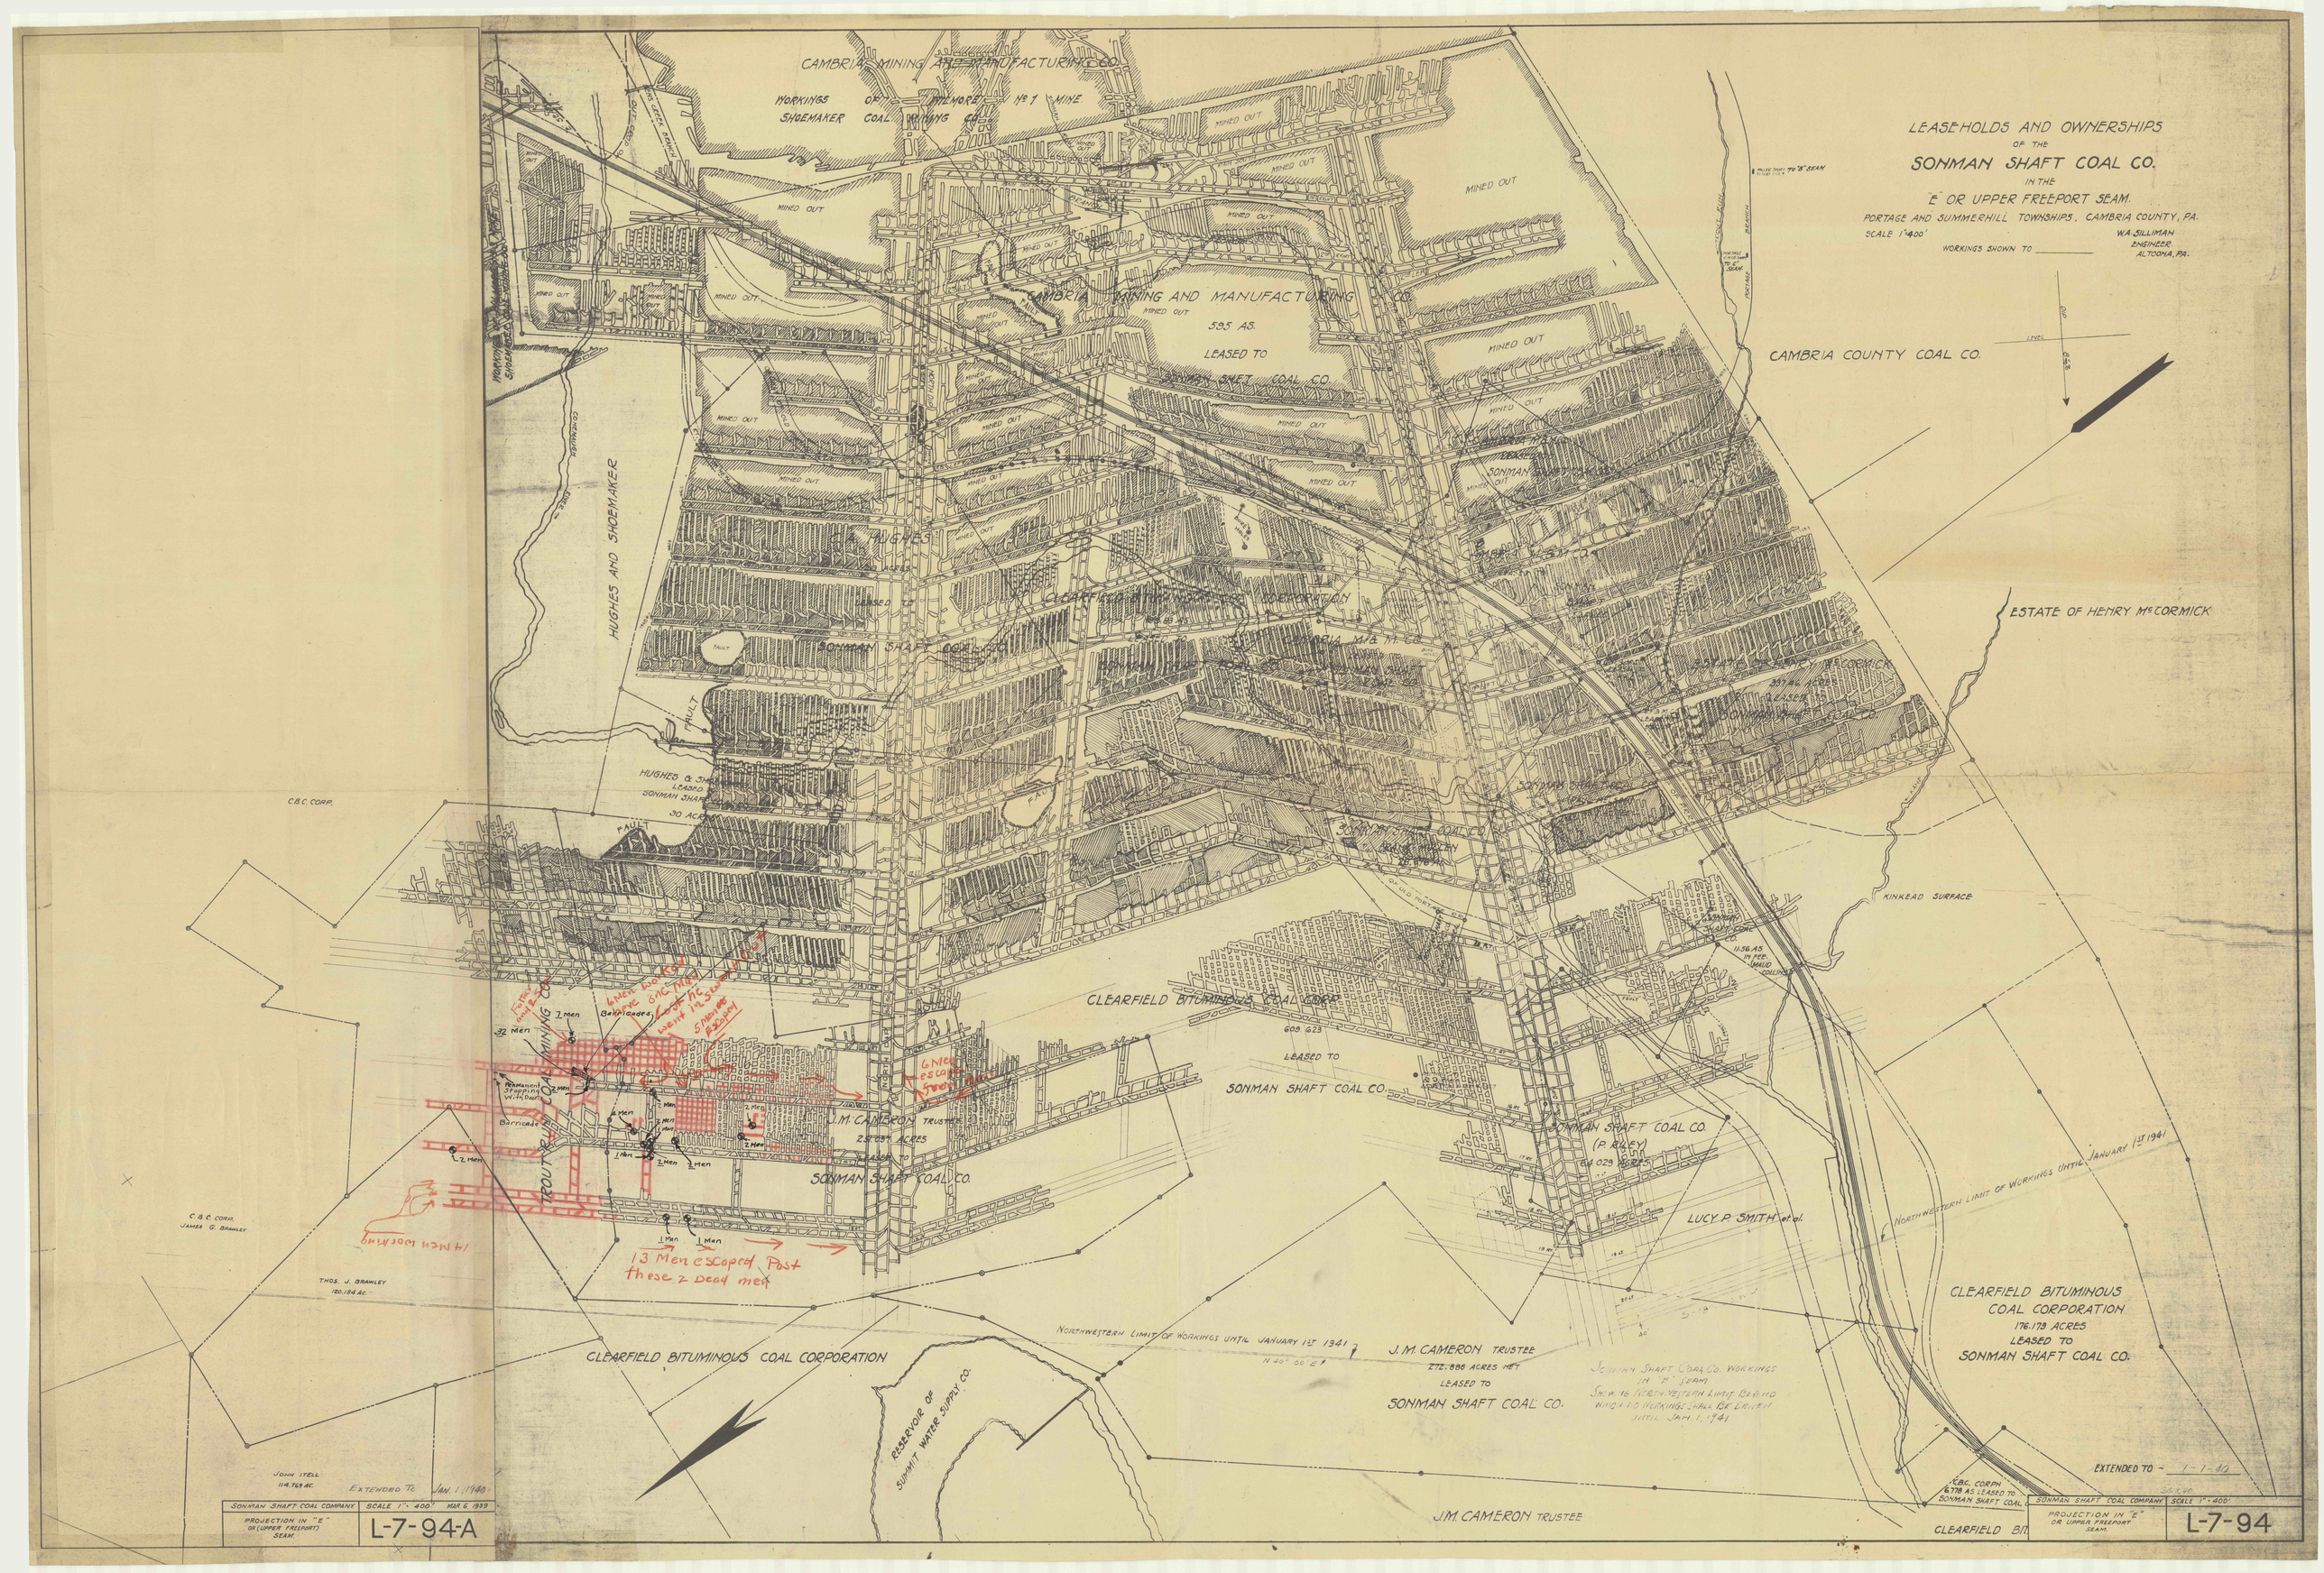
LEASEHOLDS AND OWNERSHIPS
OF THE
SONMAN SHAFT COAL CO.
IN THE
"E" OR UPPER FREEPORT SEAM.
PORTAGE AND SUMMERHILL TOWNSHIPS, CAMBRIA COUNTY, PA.
SCALE 1"=400'
WORKINGS SHOWN TO
W.A. SILLIMAN
ENGINEER.
ALTOONA, PA.
CAMBRIA MINING AND MANUFACTURING CO.
WORKINGS OF FILMORE No 1 MINE
SHOEMAKER COAL MINING CO.
MINED OUT
CAMBRIA MINING AND MANUFACTURING CO.
595 AS.
LEASED TO
SONMAN SHAFT COAL CO.
CAMBRIA COUNTY COAL CO.
HUGHES AND SHOEMAKER
ESTATE OF HENRY McCORMICK
KINKEAD SURFACE
CLEARFIELD BITUMINOUS COAL CORP.
LEASED TO
SONMAN SHAFT COAL CO.
J.M. CAMERON TRUSTEE
SONMAN SHAFT COAL CO.
SONMAN SHAFT COAL CO.
(P. RILEY)
LUCY P. SMITH et al.
NORTHWESTERN LIMIT OF WORKINGS UNTIL JANUARY 1ST 1941
CLEARFIELD BITUMINOUS COAL CORPORATION
176.179 ACRES
LEASED TO
SONMAN SHAFT COAL CO.
CLEARFIELD BITUMINOUS COAL CORPORATION
NORTHWESTERN LIMIT OF WORKINGS UNTIL JANUARY 1ST 1941
J.M. CAMERON TRUSTEE
272.886 ACRES NET
LEASED TO
SONMAN SHAFT COAL CO.
RESERVOIR OF SUMMIT WATER SUPPLY CO.
J.M. CAMERON TRUSTEE
C.B.C. CORP.
JAMES G. BRAWLEY
THOS. J. BRAWLEY
120.184 AC.
JOHN ITELL
114.769 AC.
EXTENDED TO JAN. 1, 1940
EXTENDED TO - 1-1-40
SONMAN SHAFT COAL COMPANY
SCALE 1" = 400'
MAR. 6, 1939
PROJECTION IN "E" OR (UPPER FREEPORT) SEAM.
L-7-94-A
SONMAN SHAFT COAL COMPANY
SCALE 1" = 400'
PROJECTION IN "E" OR UPPER FREEPORT SEAM.
L-7-94