


DATE OF LAST SURVEY	
1887	1888

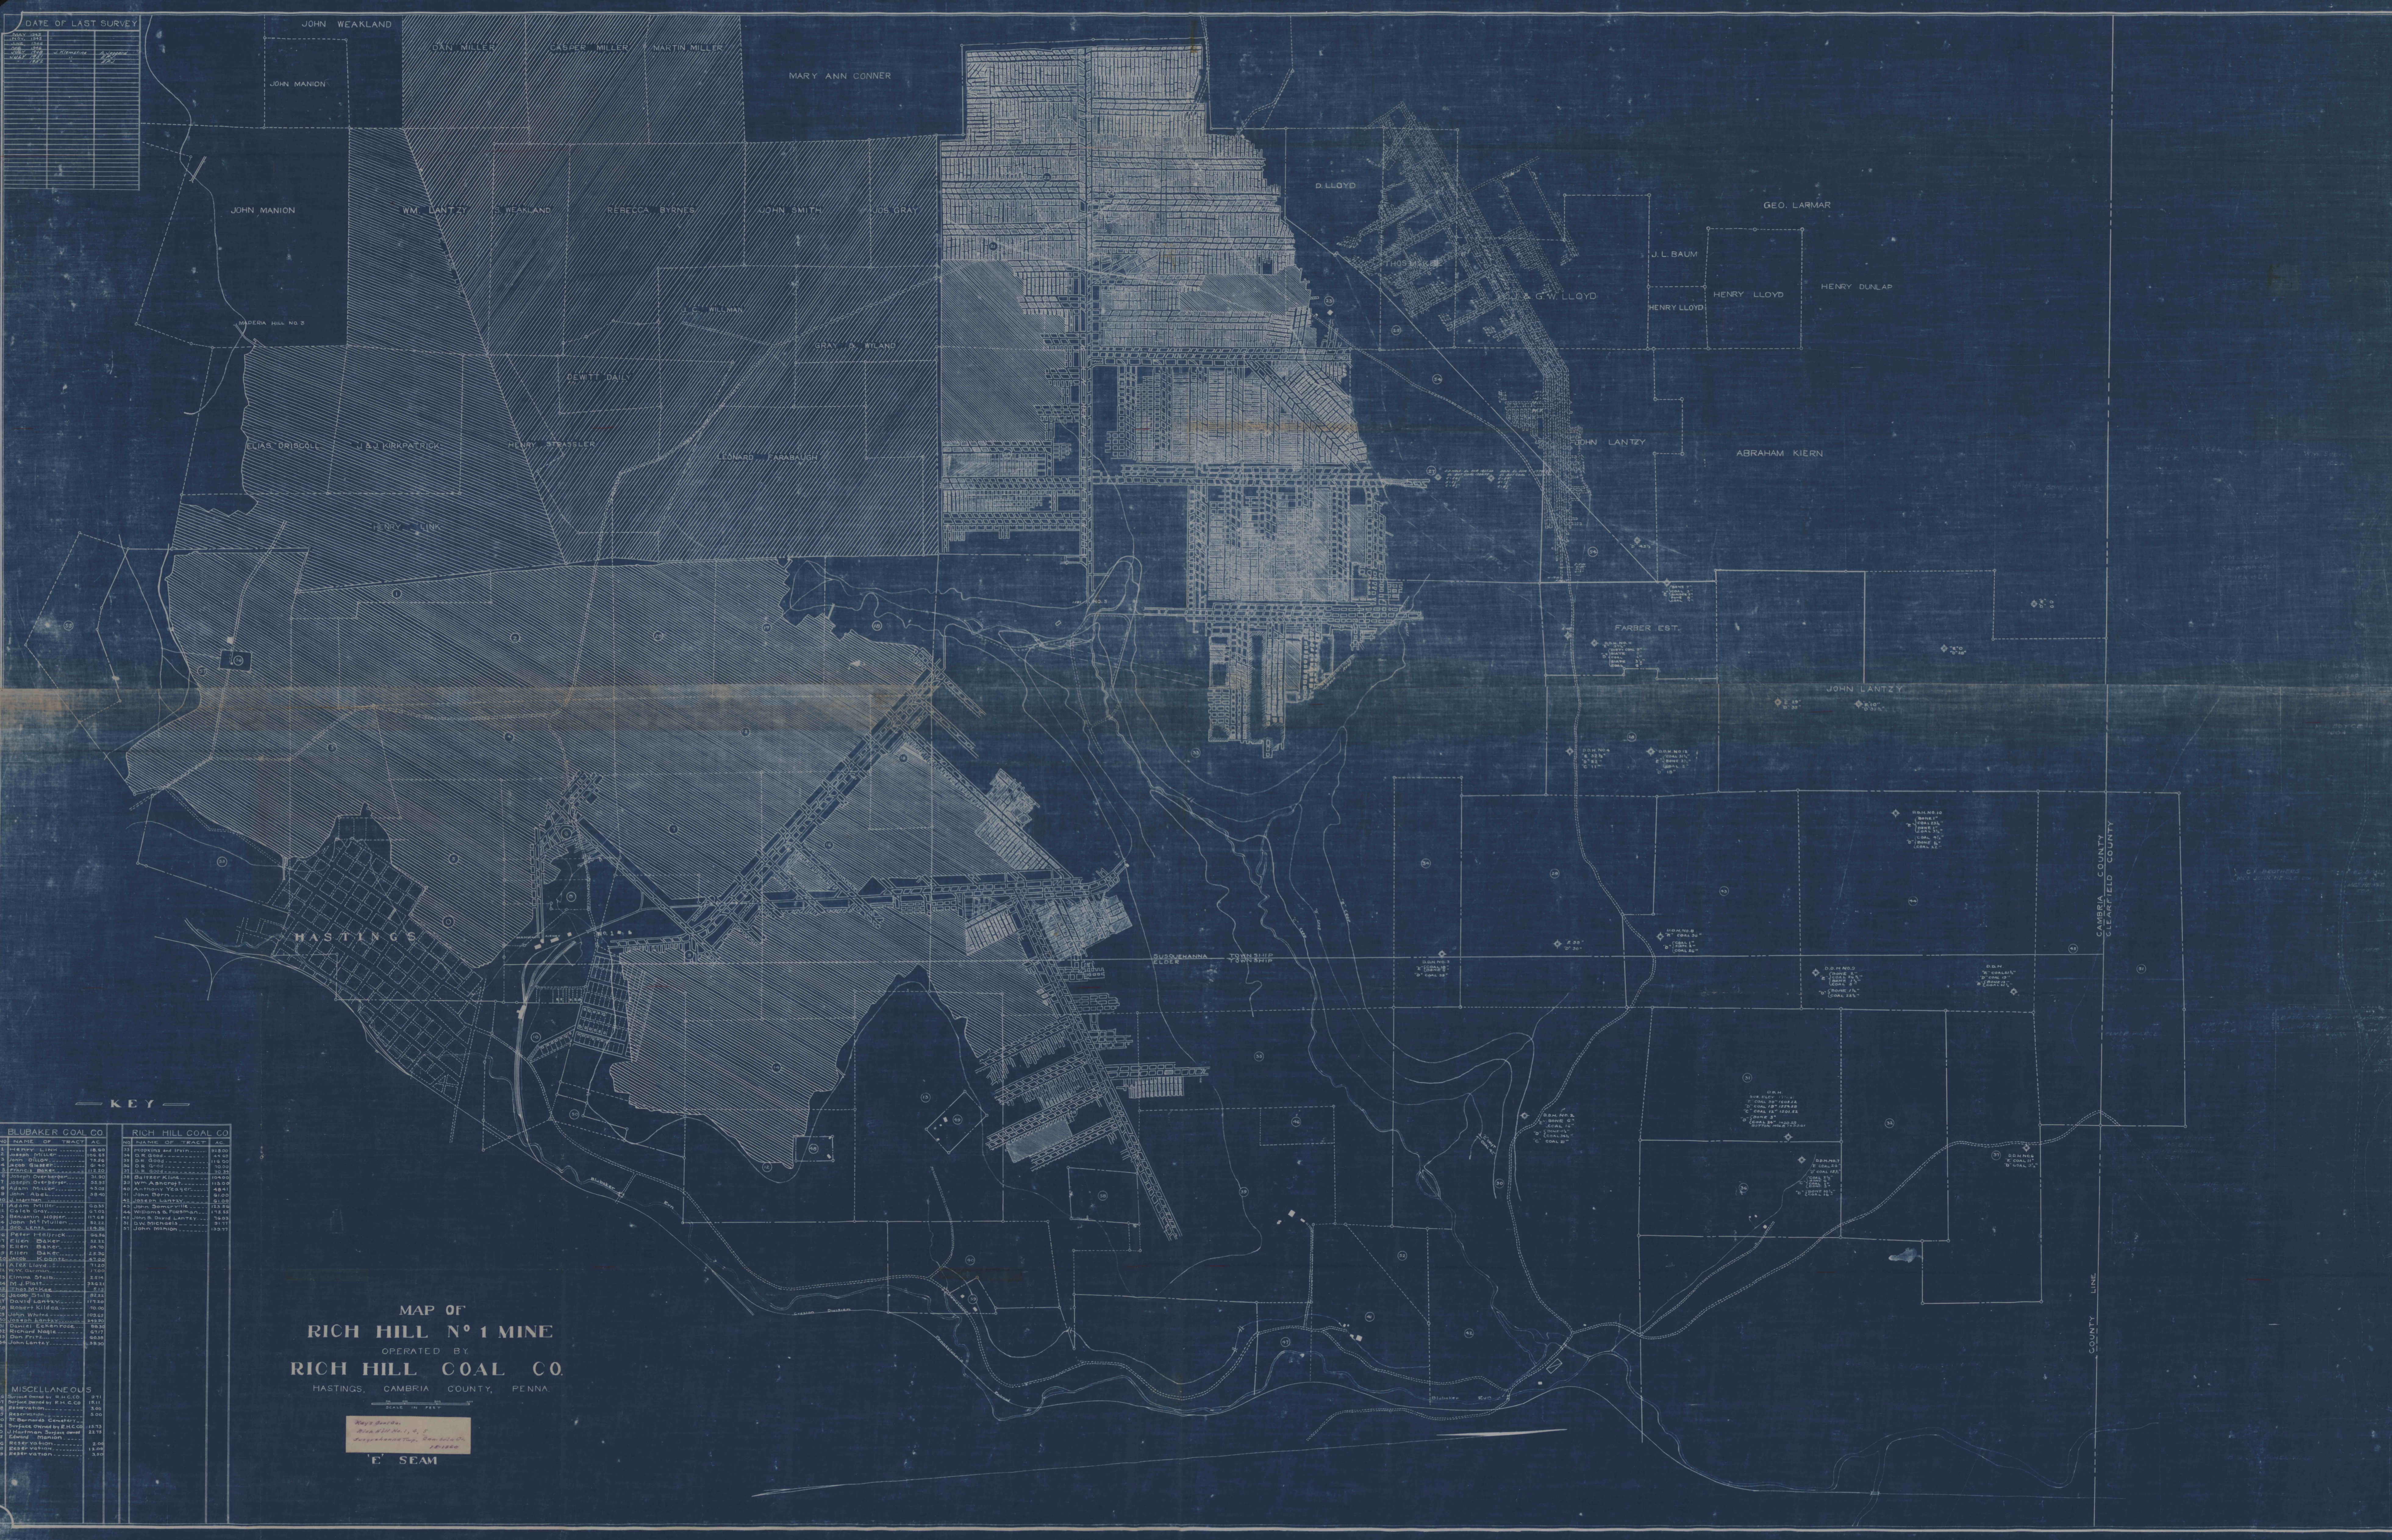

KEY

BLUBAKER COAL CO.		RICH HILL COAL CO.			
NO.	NAME OF TRACT	AC.	NO.	NAME OF TRACT	AC.

**MAP OF
RICH HILL N° 1 MINE
OPERATED BY
RICH HILL COAL CO.
HASTINGS, CAMBRIA COUNTY, PENNA.**

Scale in Feet
1" = 40'

E SEAM

CAMBRIA COUNTY
CLINTON COUNTY
COUNTY LINE