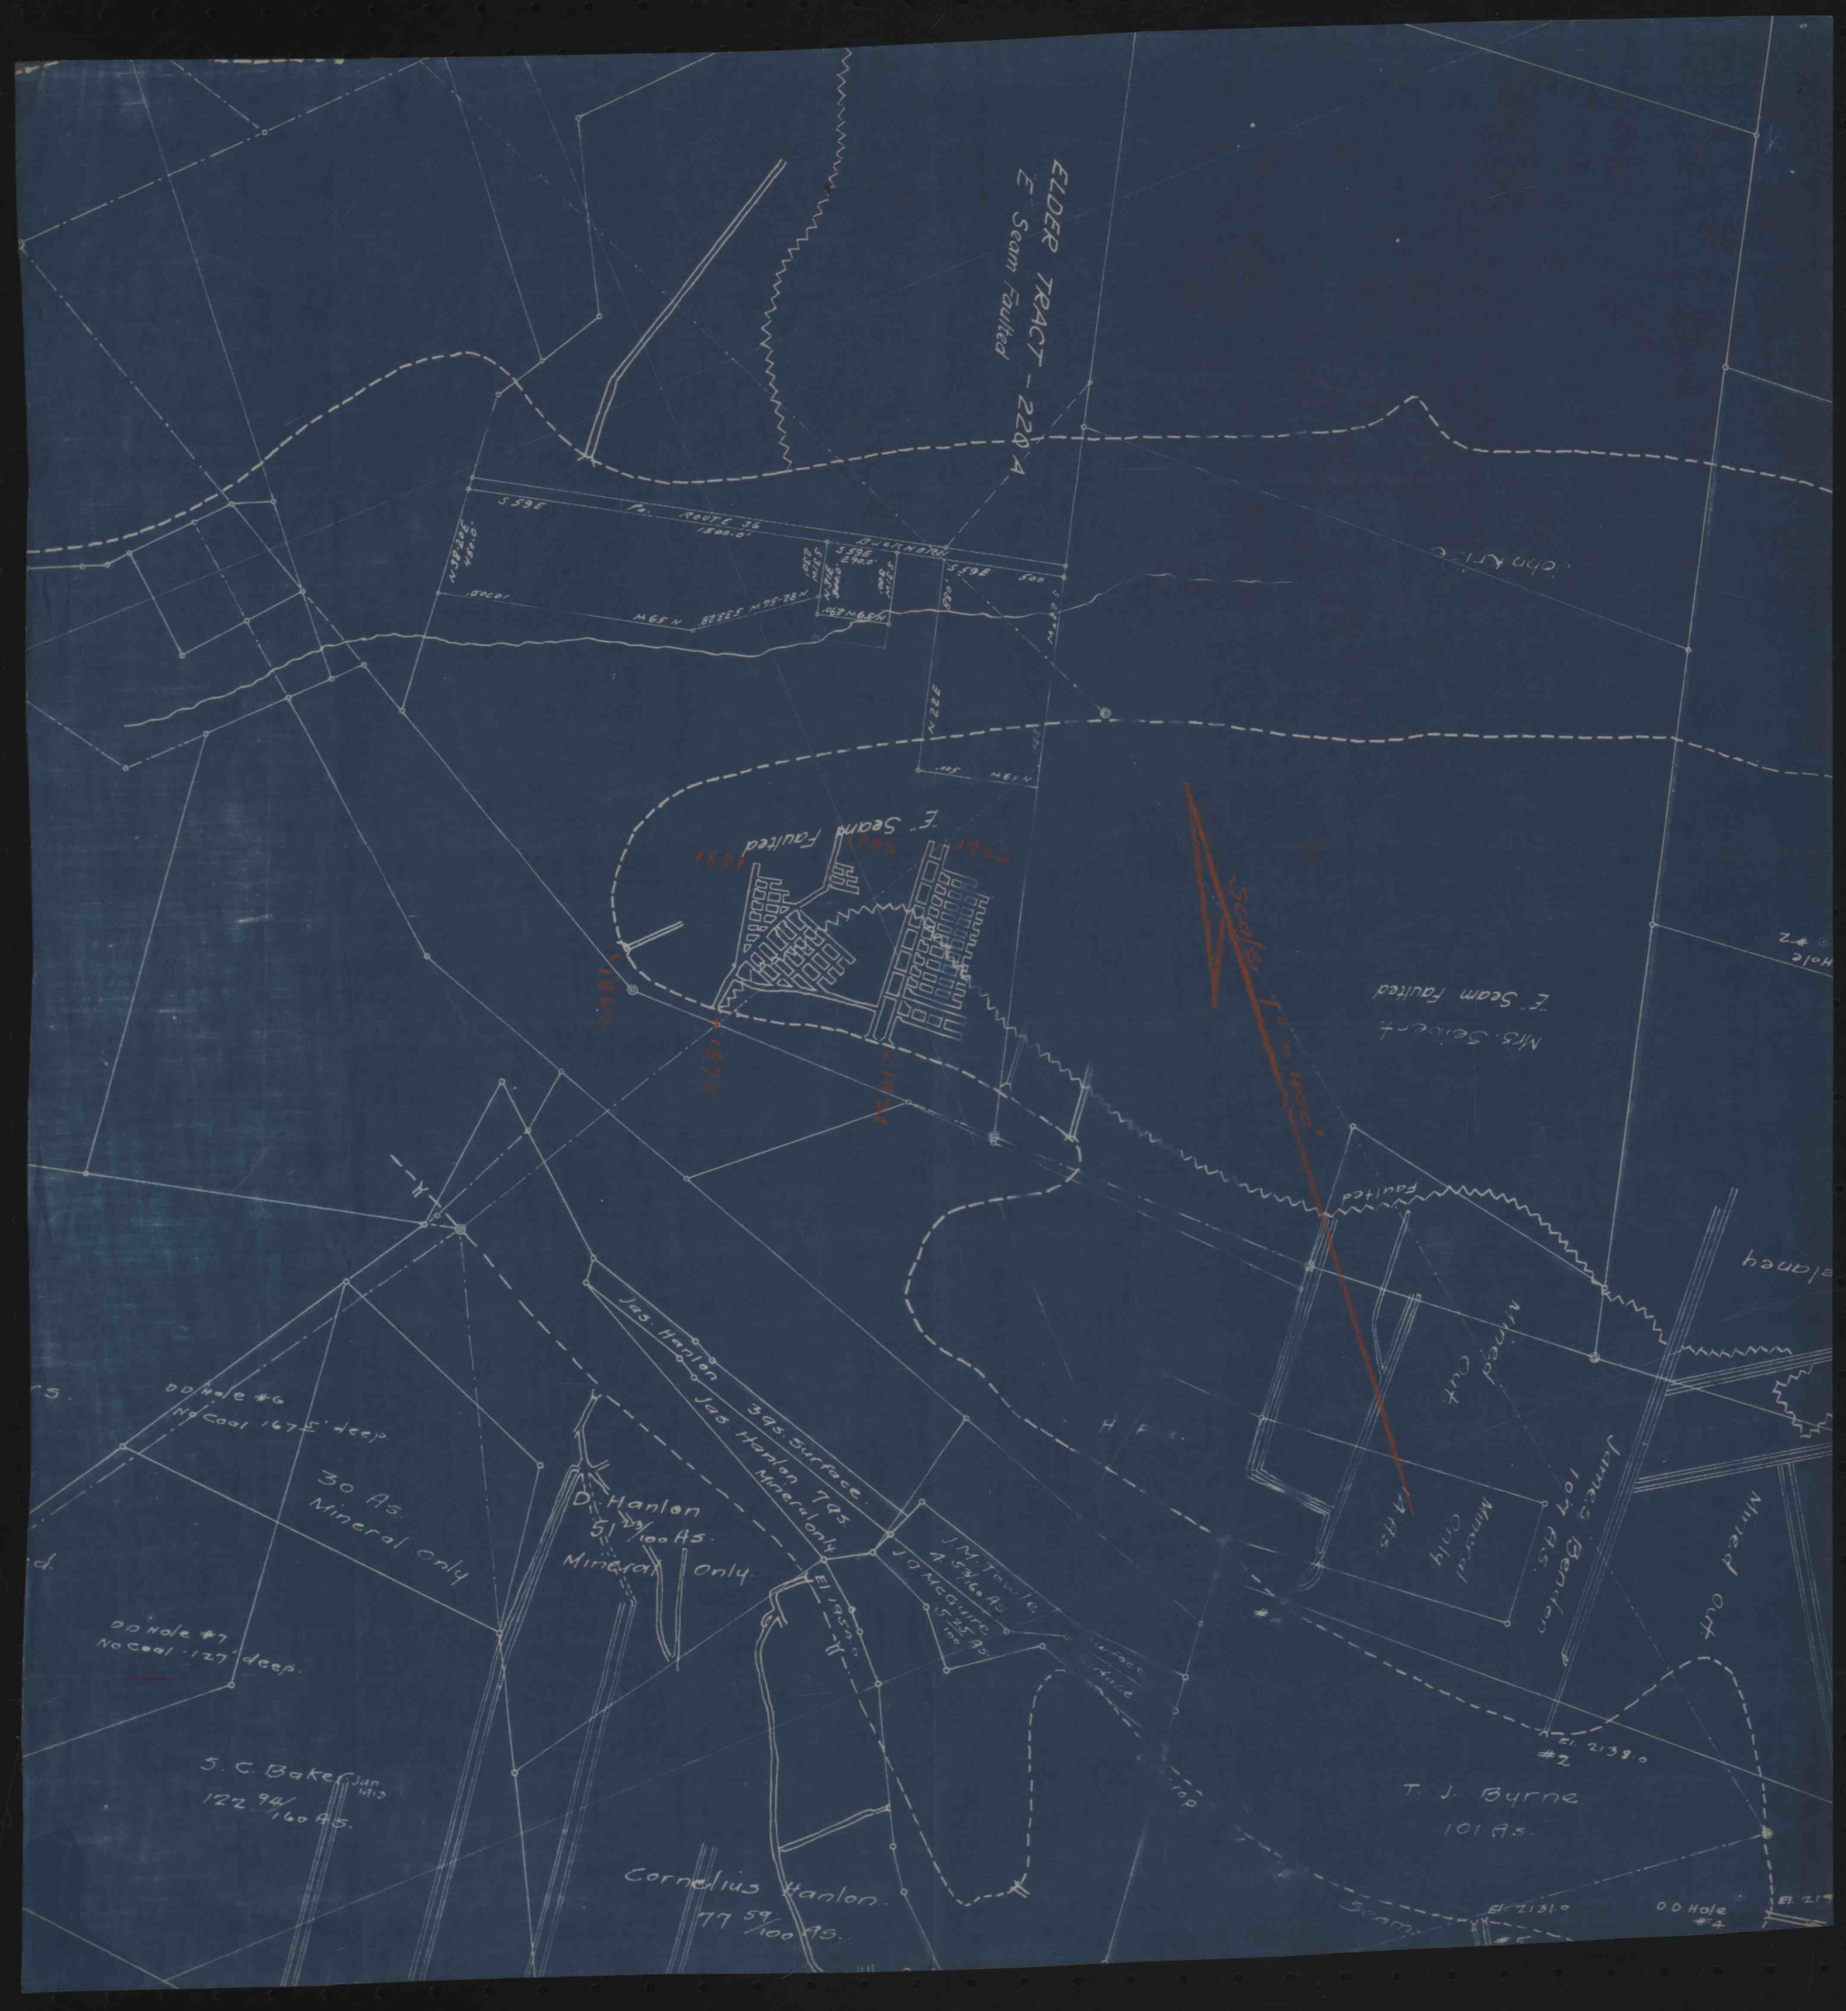
ELDER TRACT - 220 A
"E" Seam Faulted
Fa. ROUTE 36
1500.0'
BUCKHORN
"E" Seam Faulted
Scale 1" = 400'
Mrs. Seibert
"E" Seam Faulted
Faulted
Mined Out
Mined Out
James Benton
107 As.
Mined Out
Jas. Hanlon
39 As. Surface
Jas. Hanlon 79 As.
Mineral only
D. Hanlon
51 23/100 As.
Mineral Only
J.M. Towle
4 53/160 As.
J.O. McGuire
5 25/100 As.
DD Hole #6
No Coal 167.5' deep.
30 As.
Mineral Only
DD Hole #7
No Coal 127' deep.
S. C. Baker
122 94/160 As.
Cornelius Hanlon
77 59/100 As.
T. J. Byrne
101 As.
El. 2138.0
#2
El. 2131.0
DD Hole #4