


Legend "B" or Miller Ave. Height 4'4"

Fee (Coal & Surface Owned)	Shown Thus	Acceage
Coal Only		
Coal Under Lease		
Coal Tracts Owned in Fee		
Frank Flamm		85.635
Coal Only		
Walter S. Lane		46.798
W. J. Suder		18.356
L. H. Suder		19.102
D. J. Brubaker		37.654
Coal Under Lease		
None		219.18

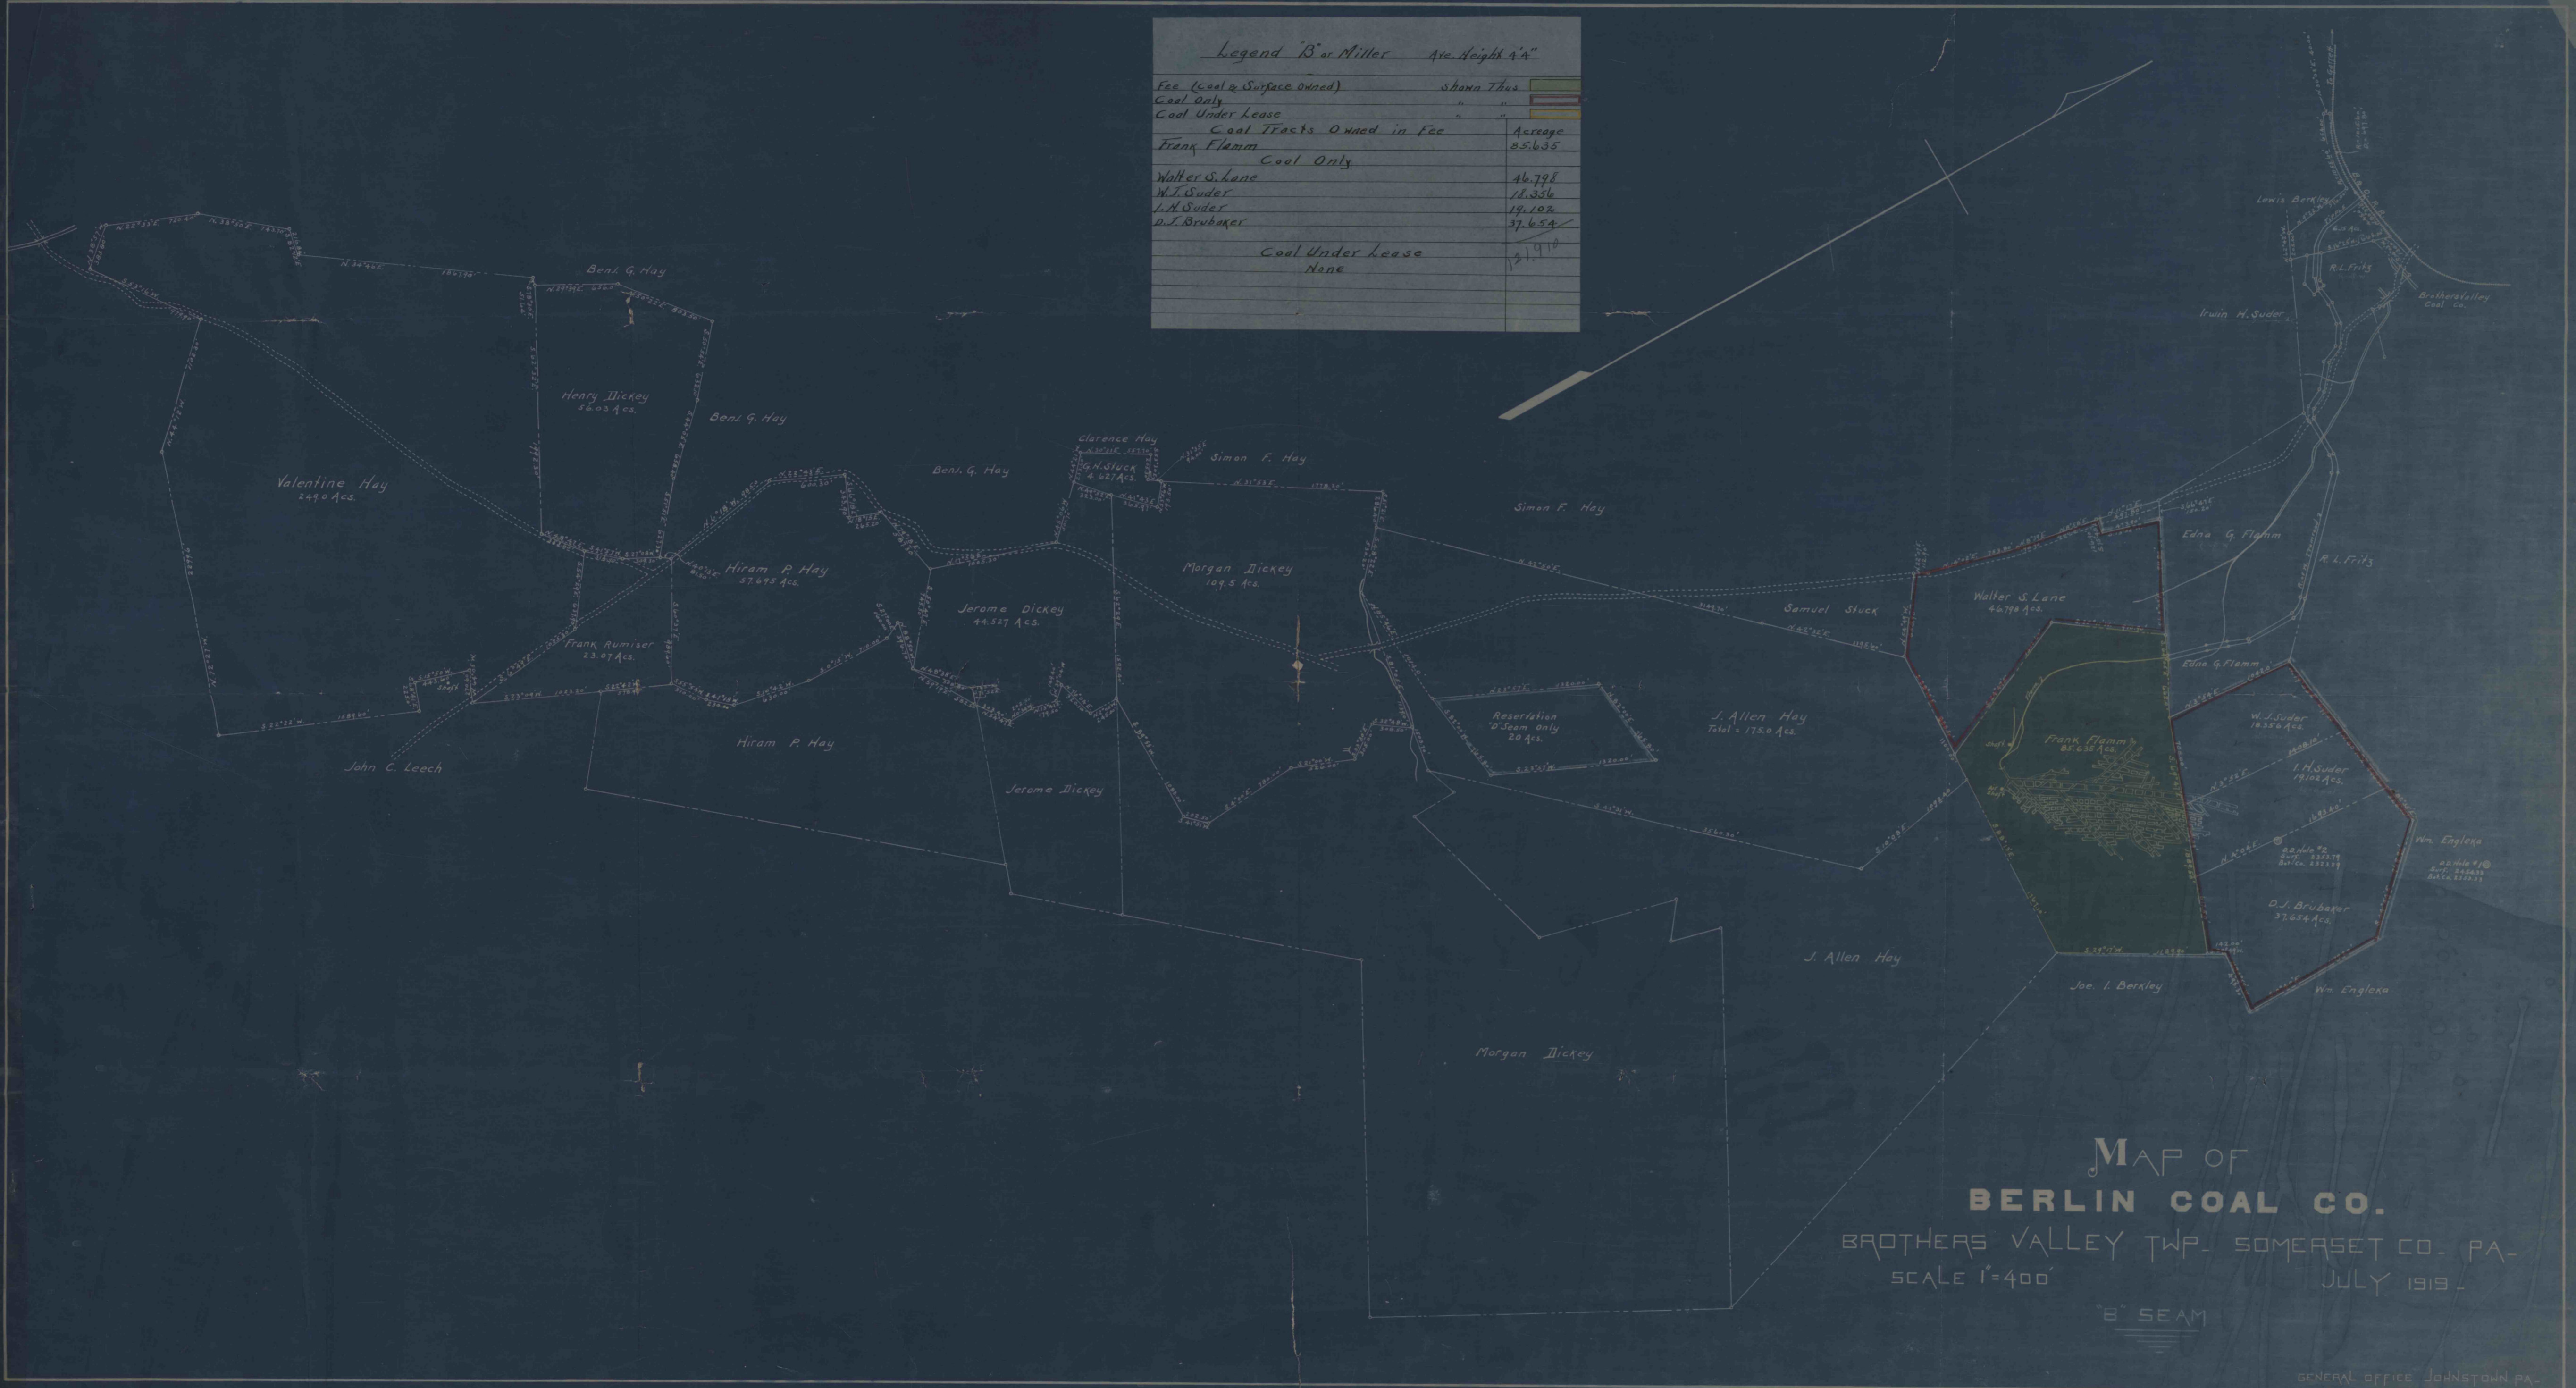

MAP OF  
**BERLIN COAL CO.**  
 BROTHERS VALLEY TWP. SOMERSET CO. PA.  
 SCALE 1"=400'  
 JULY 1919

"B" SEAM