



LEGEND

NPDES DISCHARGE POINTS		
001 AMD Plant Discharge	To Be Stopped	Stopped
002 No. 1 Shaft Discharge	To Be Stopped	Stopped
003 No. 2 Shaft Discharge	To Be Stopped	Stopped
004 No. 4 Shaft Discharge	To Be Stopped	Stopped
005 No. 5 Shaft Discharge	To Be Stopped	Stopped
006 No. 2 Shaft Sewage Treatment Discharge	To Be Stopped	Stopped
007 Tipple Runoff No. 1 - Not Shown	To Be Stopped	To Be Stopped
008 Tipple Runoff No. 2 - Not Shown	To Be Stopped	To Be Stopped
009 Refuse Pile Treated Discharge	To Be Stopped	To Be Stopped
010 No. 6 Shaft Discharge	To Be Stopped	To Be Stopped
011 No. 6 Shaft Site Runoff	To Be Stopped	To Be Stopped
001 No. 6 Shaft Sewage Treatment Plant	To Be Stopped	To Be Stopped

SURFACE WATER MONITORING POINTS		
A. Upstream A.M.D. Plant Discharge		
B. Downstream A.M.D. Plant Discharge		
C. Downstream Slope Area Runoff		
D. Downstream No. 5 Shaft Discharge		


GROUNDWATER MONITORING POINT		
1. Monitoring Well No. 1		
2. Monitoring Well No. 2		

MINE OPENING		

PERMIT BOUNDARY		



I, the undersigned, hereby certify that this map is correct and shows all the information, to the best of my knowledge and belief, required by the mining laws of this state, and covers the parcel ending

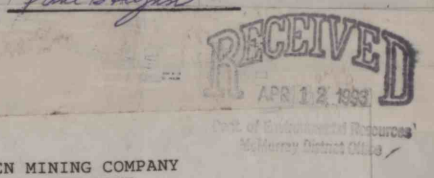

**THE HELEN MINING COMPANY
HOMER CITY MINE**

Blacklick, Center, Burrell, Conemaugh Townships
Indiana County

Upper Freeport "E" Coal Seam Scale 1" = 400'
Map Posted to January 31, 1993
FINAL MINE MAP
WEST SIDE