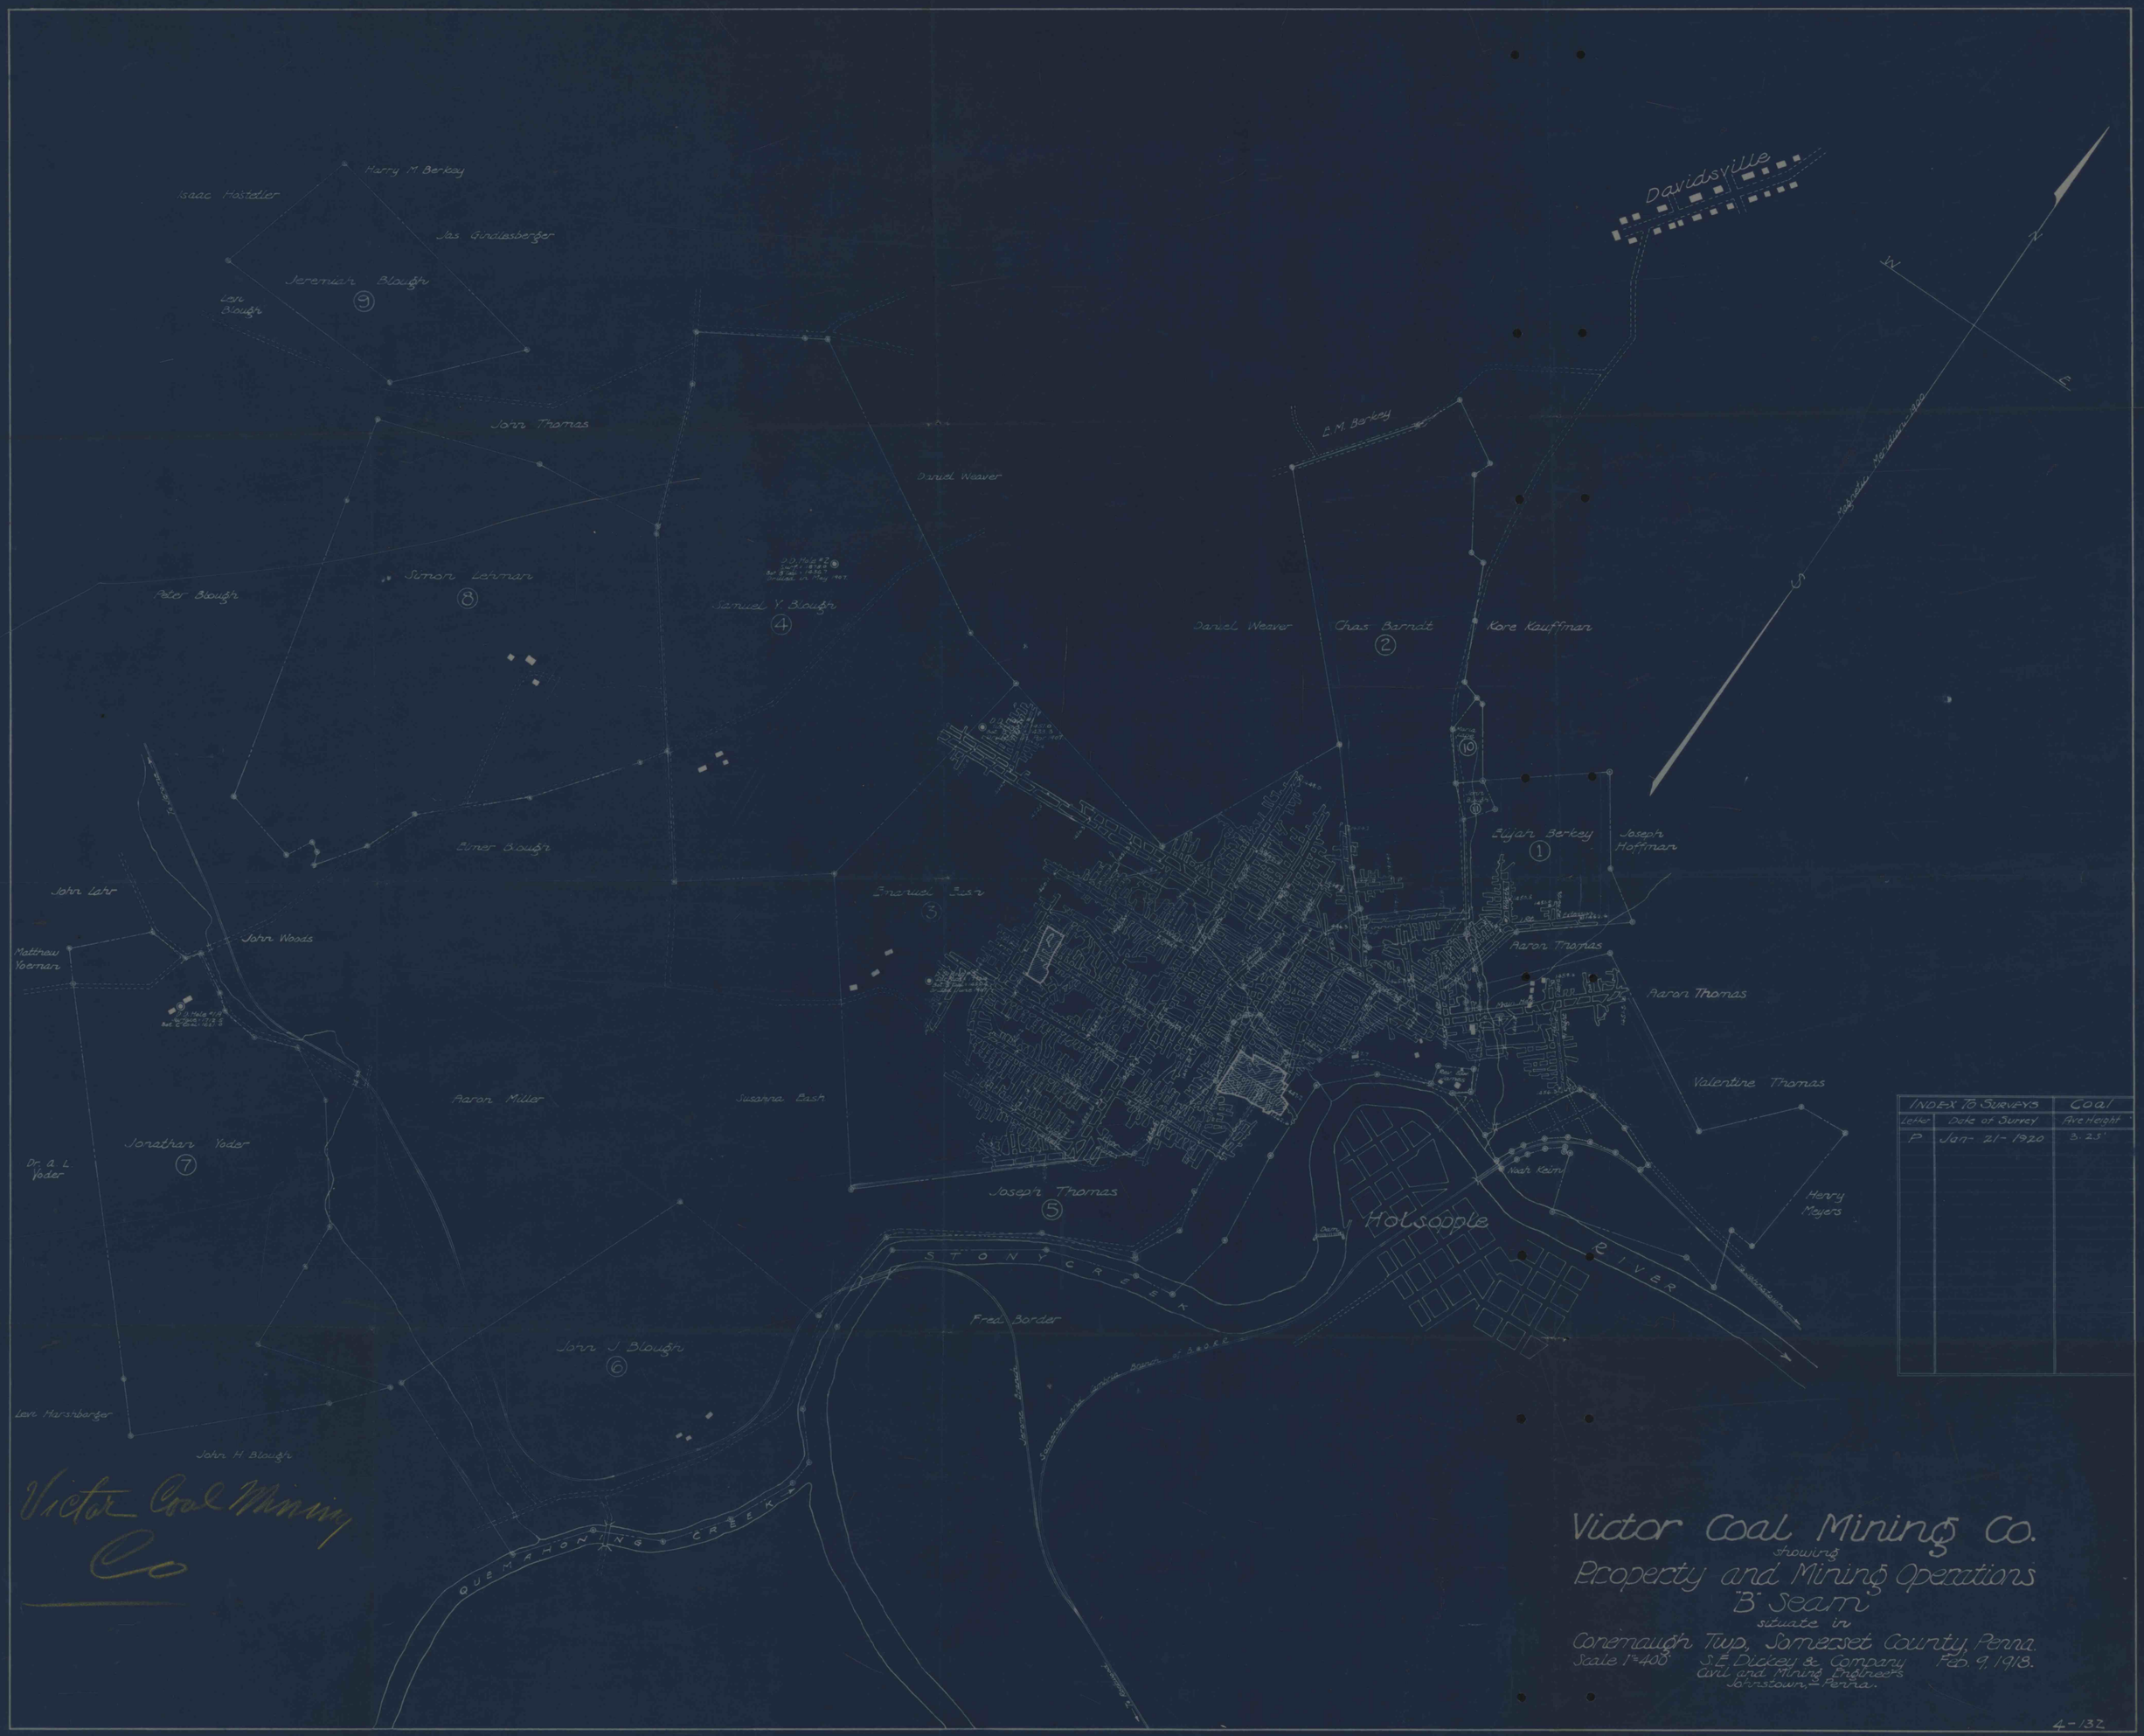

INDEX TO SURVEYS		Coal
Letter	Date of Survey	Ave Height
P	Jan- 21- 1920	3.25'

Victor Coal Mining Co.

showing

Property and Mining Operations "B" Seam

situate in

Conemaugh Twp., Somerset County, Penna.

Scale 1"=400' S.E. Dickey & Company Feb. 9, 1918.

Civil and Mining Engineers
Johnstown, Penna.

4-132