


MARYLAND NO 1 SHAFT TERRITORY

MOUNTAIN GOAL CO
YELLOW RUN SHAFT

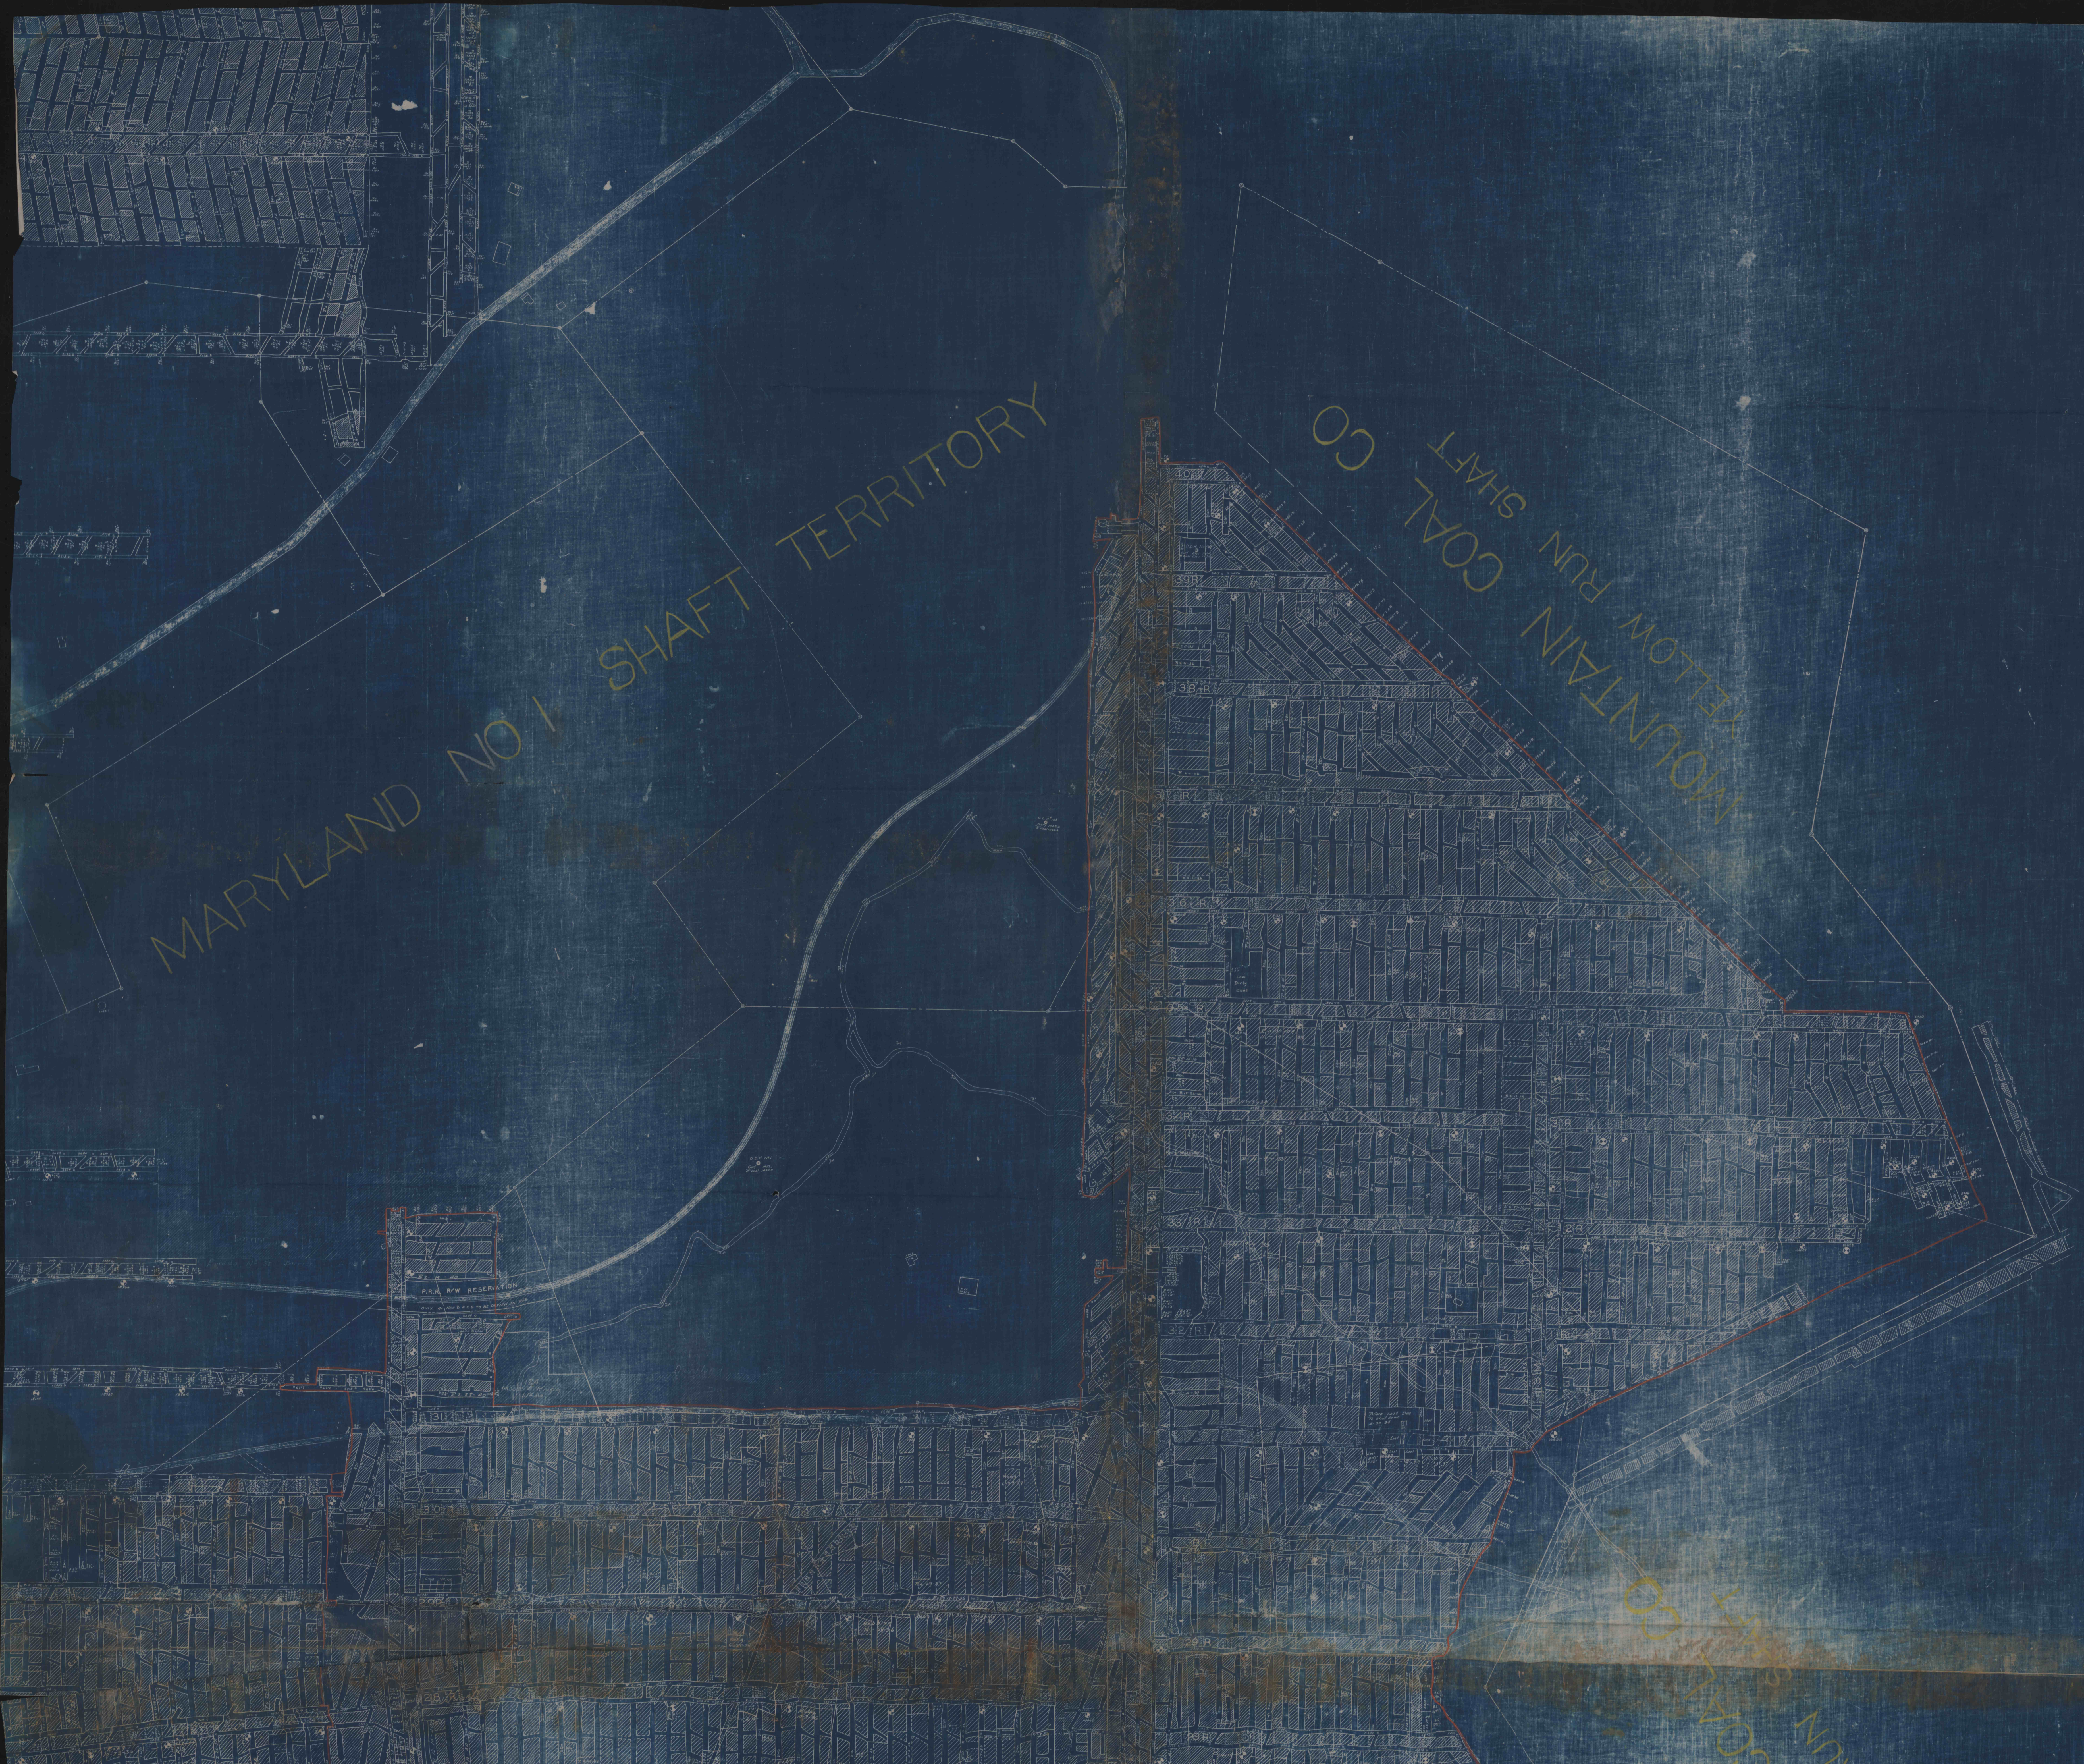

MOUNTAIN GOAL CO