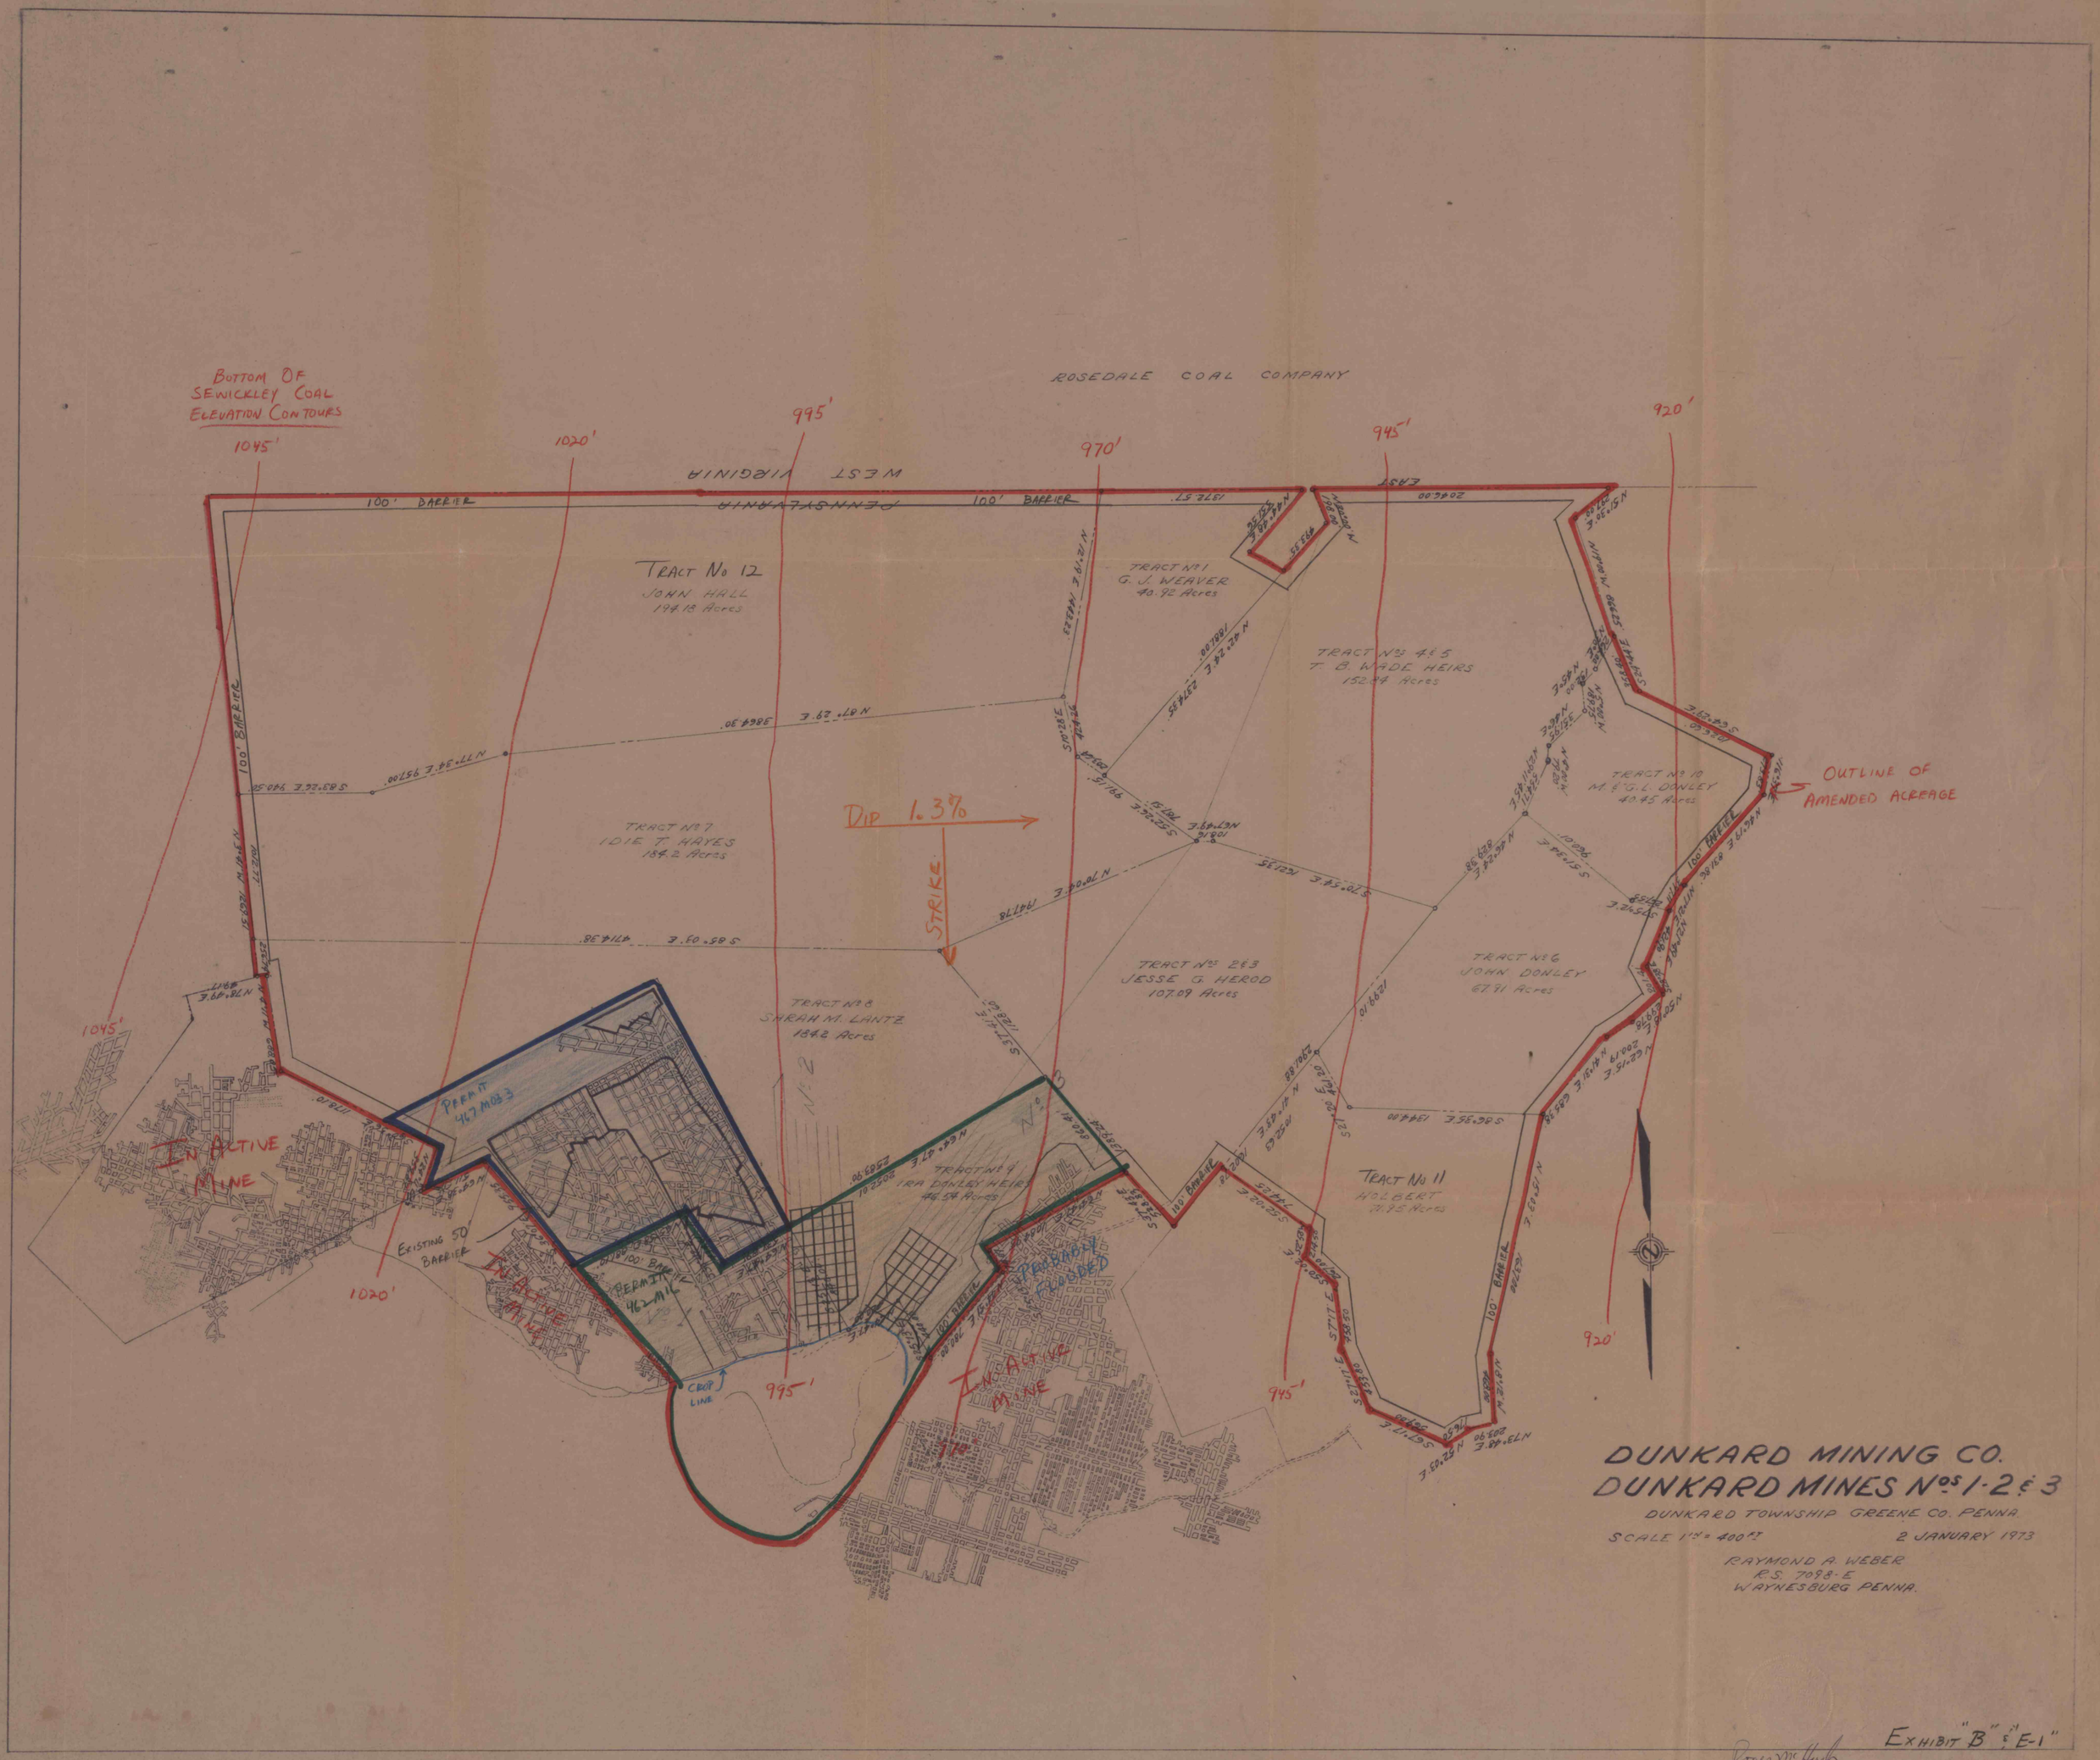

DUNKARD MINING CO.
DUNKARD MINES Nos 1-2 & 3
DUNKARD TOWNSHIP GREENE CO. PENNA.
SCALE 1" = 400 FT
2 JANUARY 1973
RAYMOND A. WEBER
R.S. 7098-E
WAYNESBURG PENNA.

EXHIBIT "B" & "E-1"

Roger McHugh