


- ① 2 STY. FR. DWG. 70' COVER
- ② 1 STY. FR. DWG. 160' COVER
- ③ 1 STY. FR. DWG. 300' COVER

LK = B  
 UK = C.P.  
 LF = D  
 UF = E

B seam lower Kittanning  
 C Prime upper Kittanning  
 D Seam lower Freeport  
 E Seam upper Freeport

- PROPOSED AREA TO BE MINED 3-31-69 TO 2-31-69
- PROPERTY LINES
- AREA AFFECTED BEFORE
- MINING COMPLETED
- SUPPORT AREA

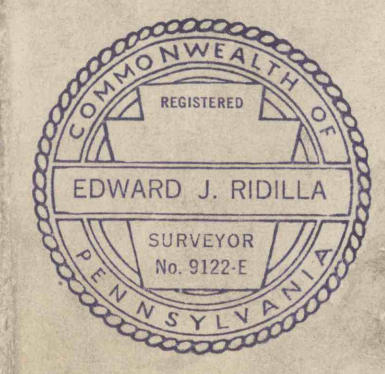

PROPERTY MAP  
 FOR MINE DRAINAGE PERMIT  
 FOR  
 SVONAVEC INC.  
 SOMERSET TWP SOMERSET CO. PA  
 SCALE 1" = 400' APRIL 1967  
 LOCATED BY: Robert W. Cassidy, P.S.  
 166 UNION 445-4884  
 WORKINGS POSTED 5-21-69 E.J.R.  
 2641st Street Acosta BSW 679-6091