


**C.A. HUGHES & CO.**  
HUGHES NO. 2 & LILLY NO. 3 MINES  
THE  
B of LOWER KITTANNING SEAM  
WITH ADJACENT MINES AND PROPERTIES  
SCALE 1:4000

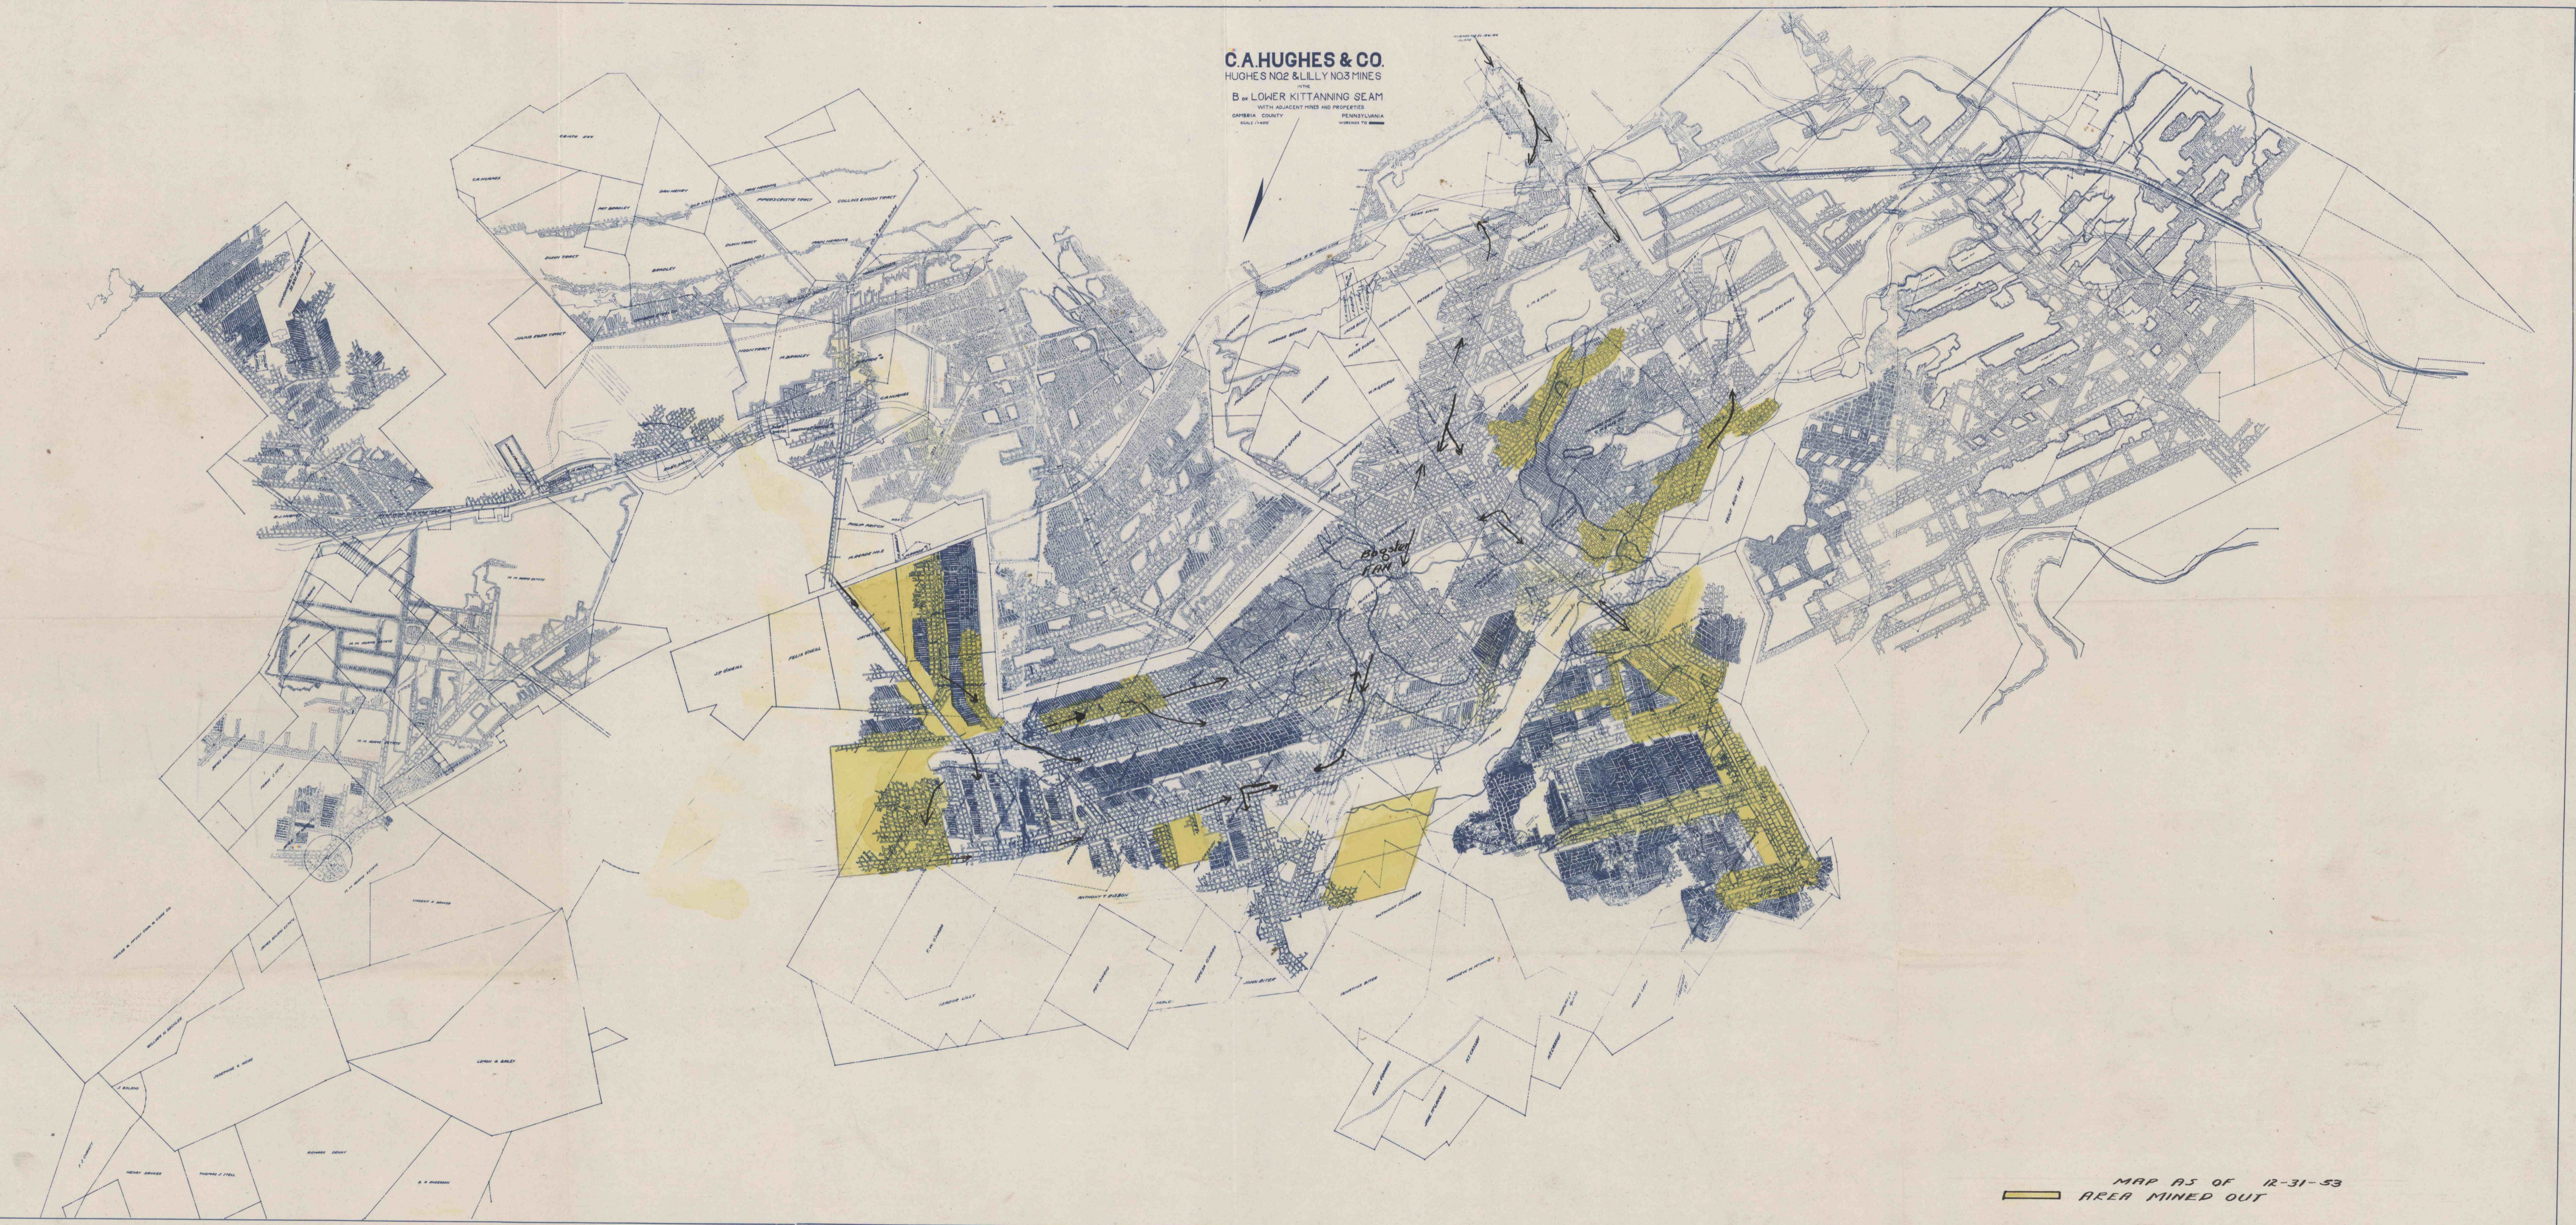

MAP AS OF 12-31-53  
AREA MINED OUT