


BETHLEHEM MINES CORPORATION

BETHLEHEM MINES CORPORATION

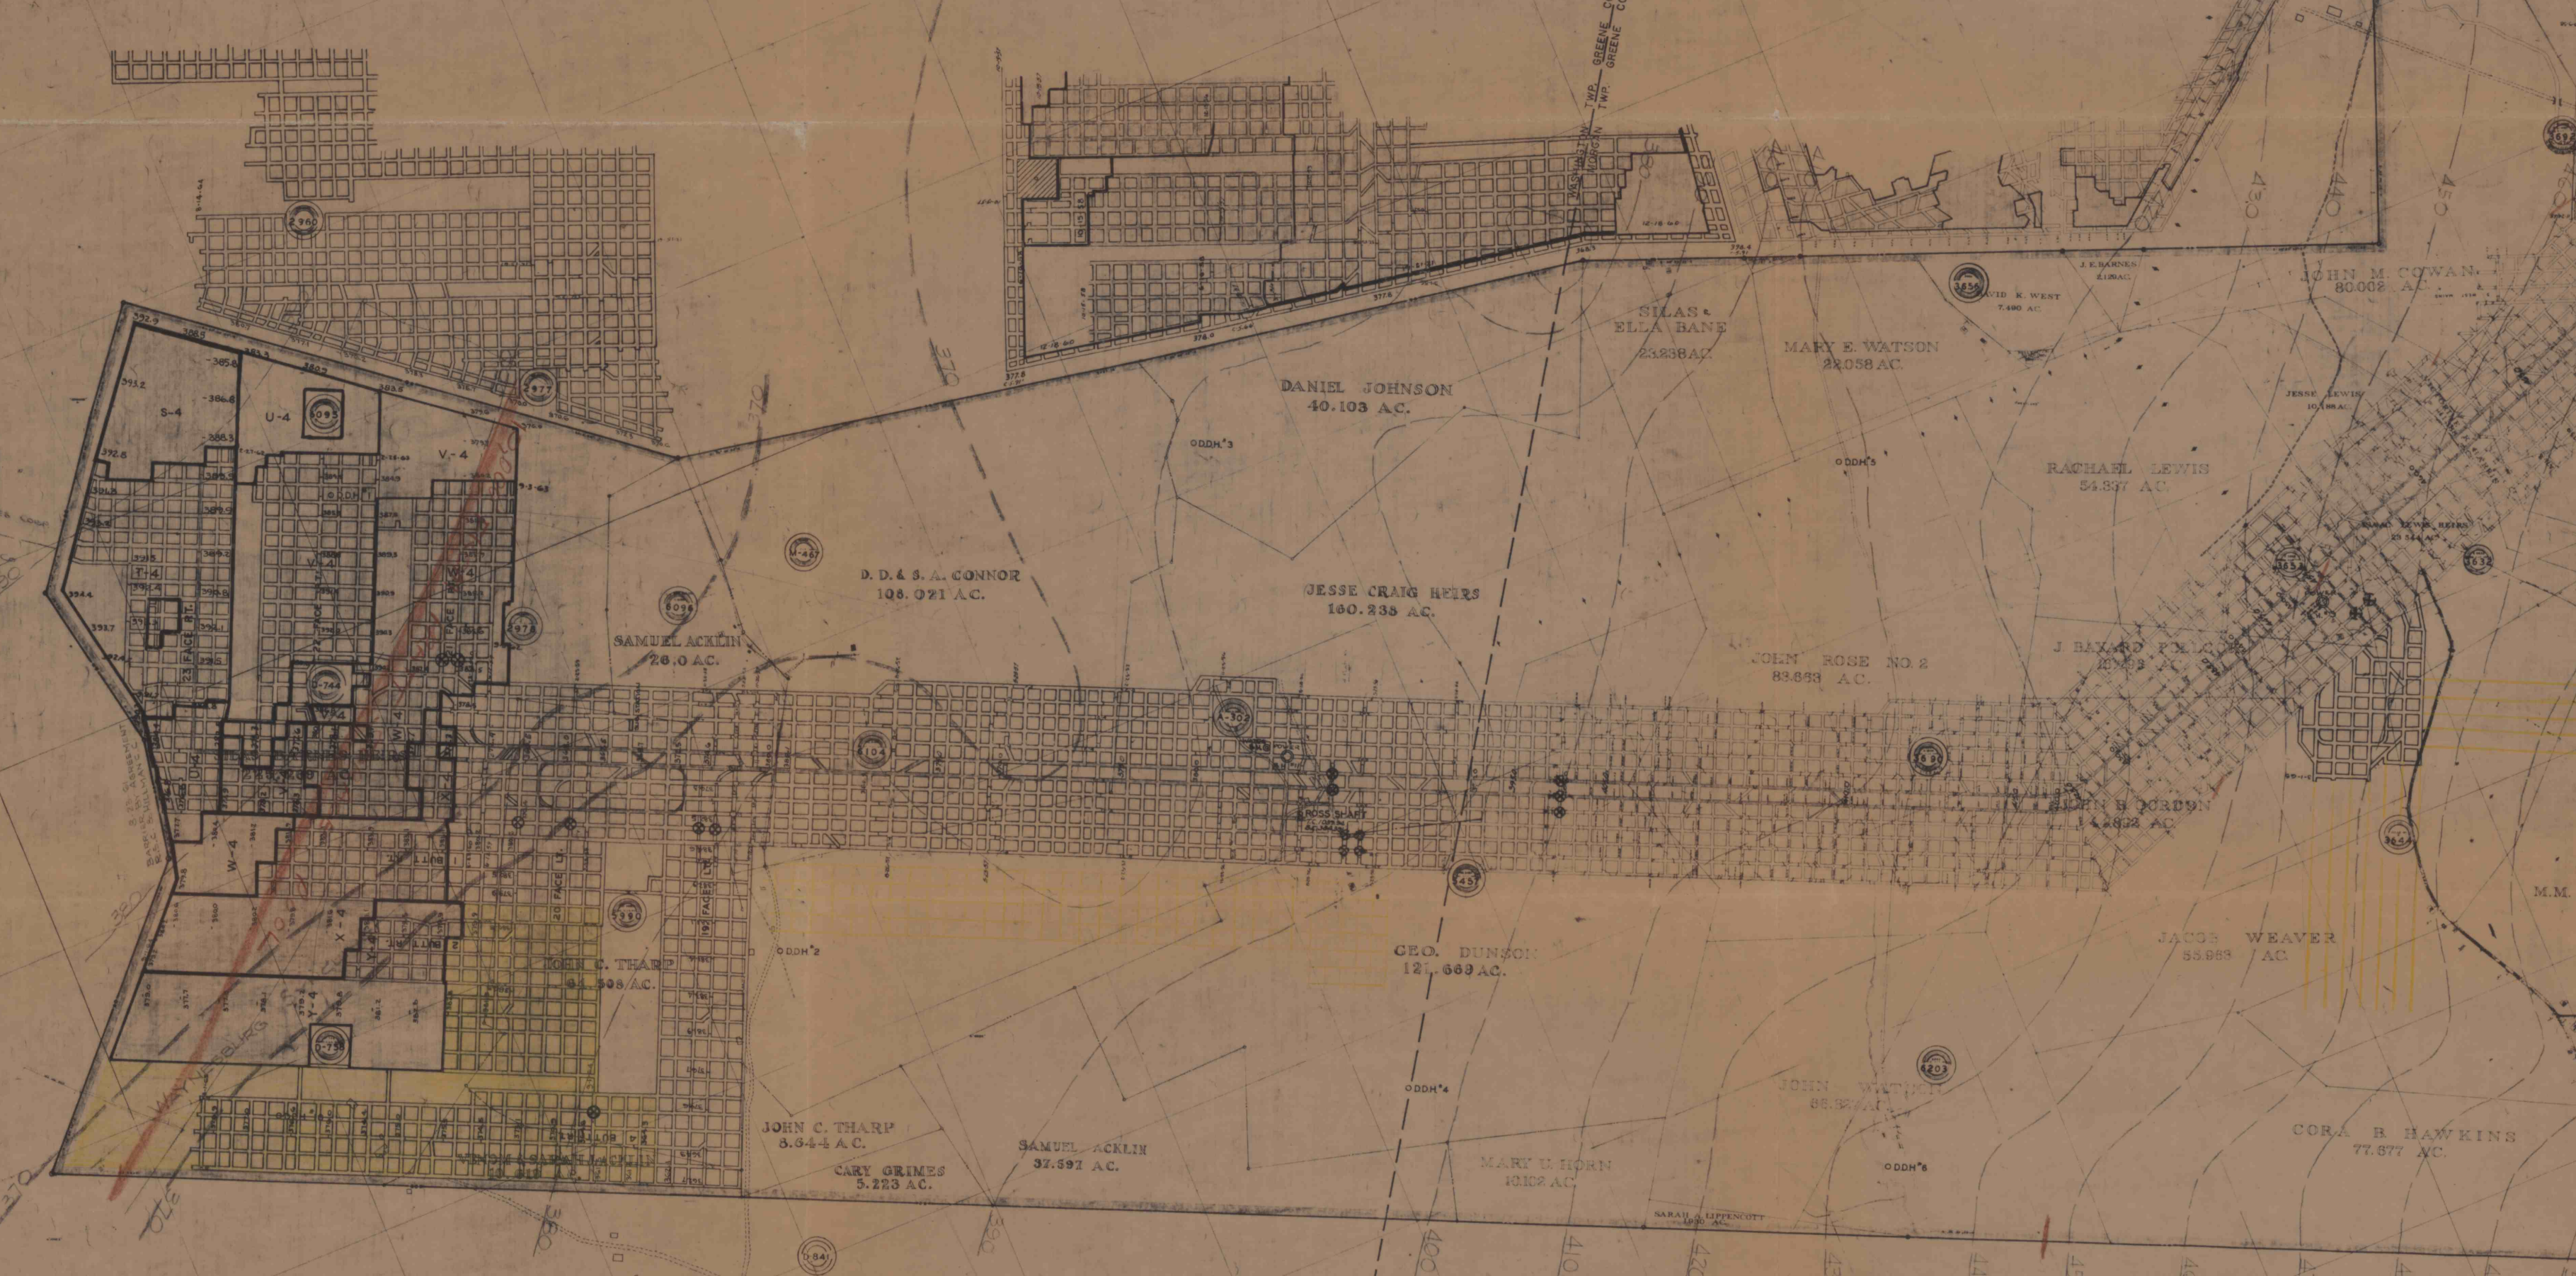

EMERALD COAL AND COKE CO.

CLYDE MINE
OF
REPUBLIC STEEL CORPORATION

EAST BETHLEHEM & WEST BETHLEHEM TOWNSHIPS & DEEMSTON BORO.
WASHINGTON CO.

MORGAN, JEFFERSON & WASHINGTON TOWNSHIPS & CLARKVILLE BORO.
GREENE CO.
PENNSYLVANIA

SCALE 1"=400' 1958

SURVEY EXTENDED TO 2-2-59