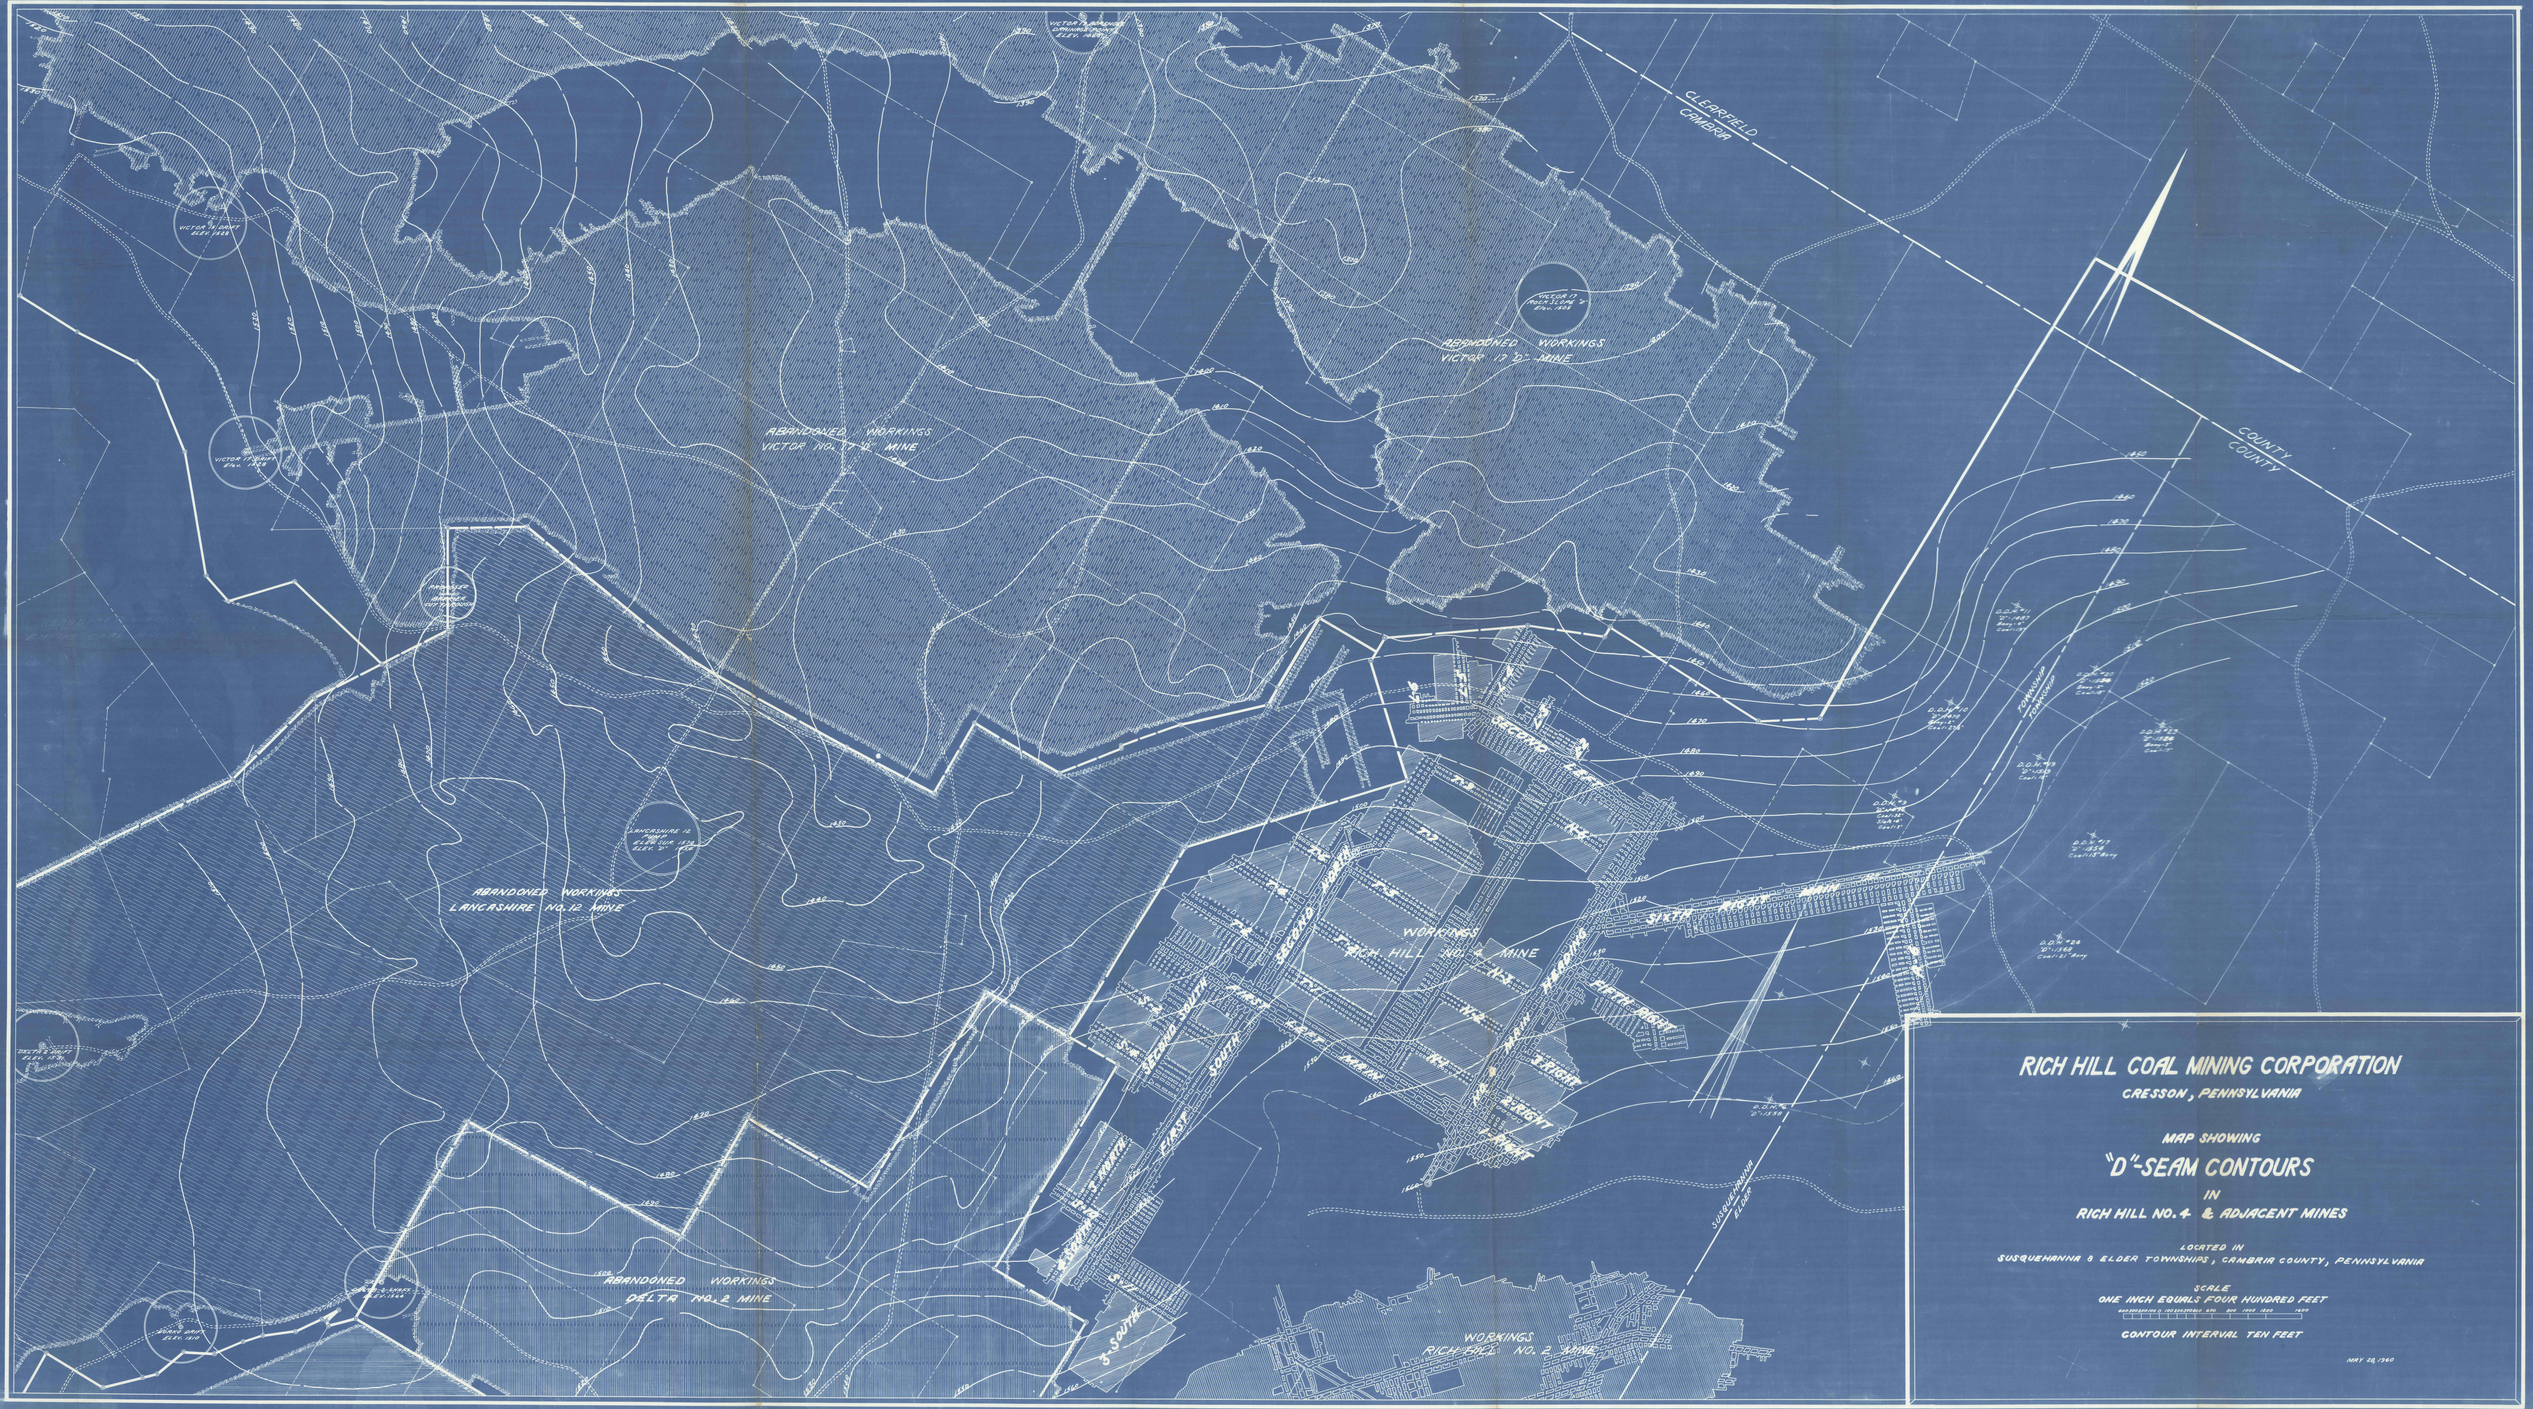
CLEARFIELD
CAMBRIA
COUNTY
COUNTY
ABANDONED WORKINGS
VICTOR 17 "D" MINE
ABANDONED WORKINGS
VICTOR NO. 17 "D" MINE
ABANDONED WORKINGS
LANCASHIRE NO. 12 MINE
ABANDONED WORKINGS
DELTA NO. 2 MINE
WORKINGS
RICH HILL NO. 4 MINE
WORKINGS
RICH HILL NO. 2 MINE
SECOND LEFT
SECOND NORTH
SECOND SOUTH
FIRST SOUTH
FIRST LEFT
SIXTH RIGHT
FIFTH RIGHT
3 RIGHT
2 RIGHT
1 RIGHT
3 SOUTH
SUSQUEHANNA
ELDER
TOWNSHIP
TOWNSHIP
RICH HILL COAL MINING CORPORATION
CRESSON, PENNSYLVANIA
MAP SHOWING
"D"-SEAM CONTOURS
IN
RICH HILL NO. 4 & ADJACENT MINES
LOCATED IN
SUSQUEHANNA & ELDER TOWNSHIPS, CAMBRIA COUNTY, PENNSYLVANIA
SCALE
ONE INCH EQUALS FOUR HUNDRED FEET
CONTOUR INTERVAL TEN FEET
MAY 28, 1960