
 


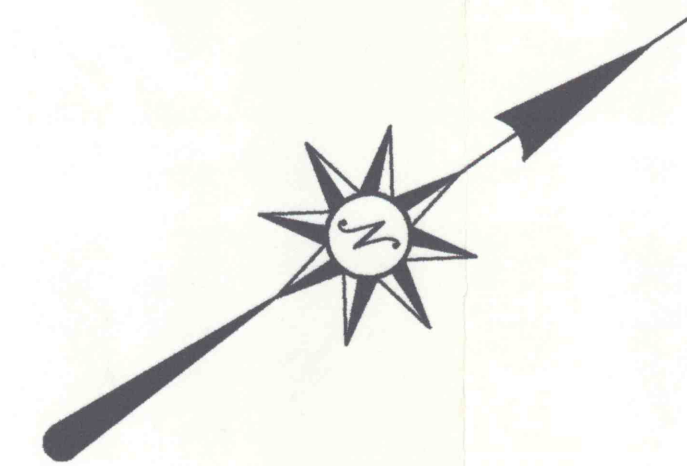

LEGEND


[illegible]

400	0	400	800
-----	---	-----	-----

FINAL MINE MAP
LION MINING COMPANY
GROVE NO. 1 MINE
UPPER KITTANNING COAL SEAM
Jennersburg and Jenner Townships, Somerset County, PA
MSHA ID #36-02398 PERMIT #56841306

Mine Address:
192 Lion Road
Boswell, PA 15531

PERMITTEE:
LION MINING COMPANY
C/O James T. Arnone
P.O. Box 209
Jennerstown, PA 15547

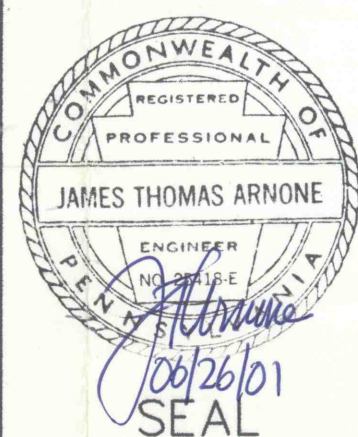

Printed 06/25/0