


10 HENRY SMITH	50.33
11 JOSEPH PREISSER	63.53
12 JOHN B. KIRSCH	114.34
13 WILLIAM PLUMMER	121.12
14 THOMAS EDWARDS	262.70
15 THOS. GRIFFITH EST.	344.04
16 MARGARET AGEER	16.10
17 JOHN BAGLEY	271.30
18 D. E. EDWARDS	114.69
19 MARY GITTINGS	51.84
TOTAL	1905.83

DATE OF LAST SURVEY	
JANUARY 1931	JULY 1938
JULY 1931	JANUARY 1939
JANUARY 1932	JULY 1939
JULY 1932	JANUARY 1940
JAN 1933	JULY 1940
JULY 1933	JANUARY 1941
JAN 1934	JULY 1941
JULY 1934	JANUARY 1942
JAN 1935	JULY 1942
JULY 1935	JANUARY 1943
JAN 1936	JULY 1943
JULY 1936	JANUARY 1944
JAN 1937	JULY 1944
JULY 1937	JANUARY 1945
JAN 1938	JULY 1945
JULY 1938	JANUARY 1946

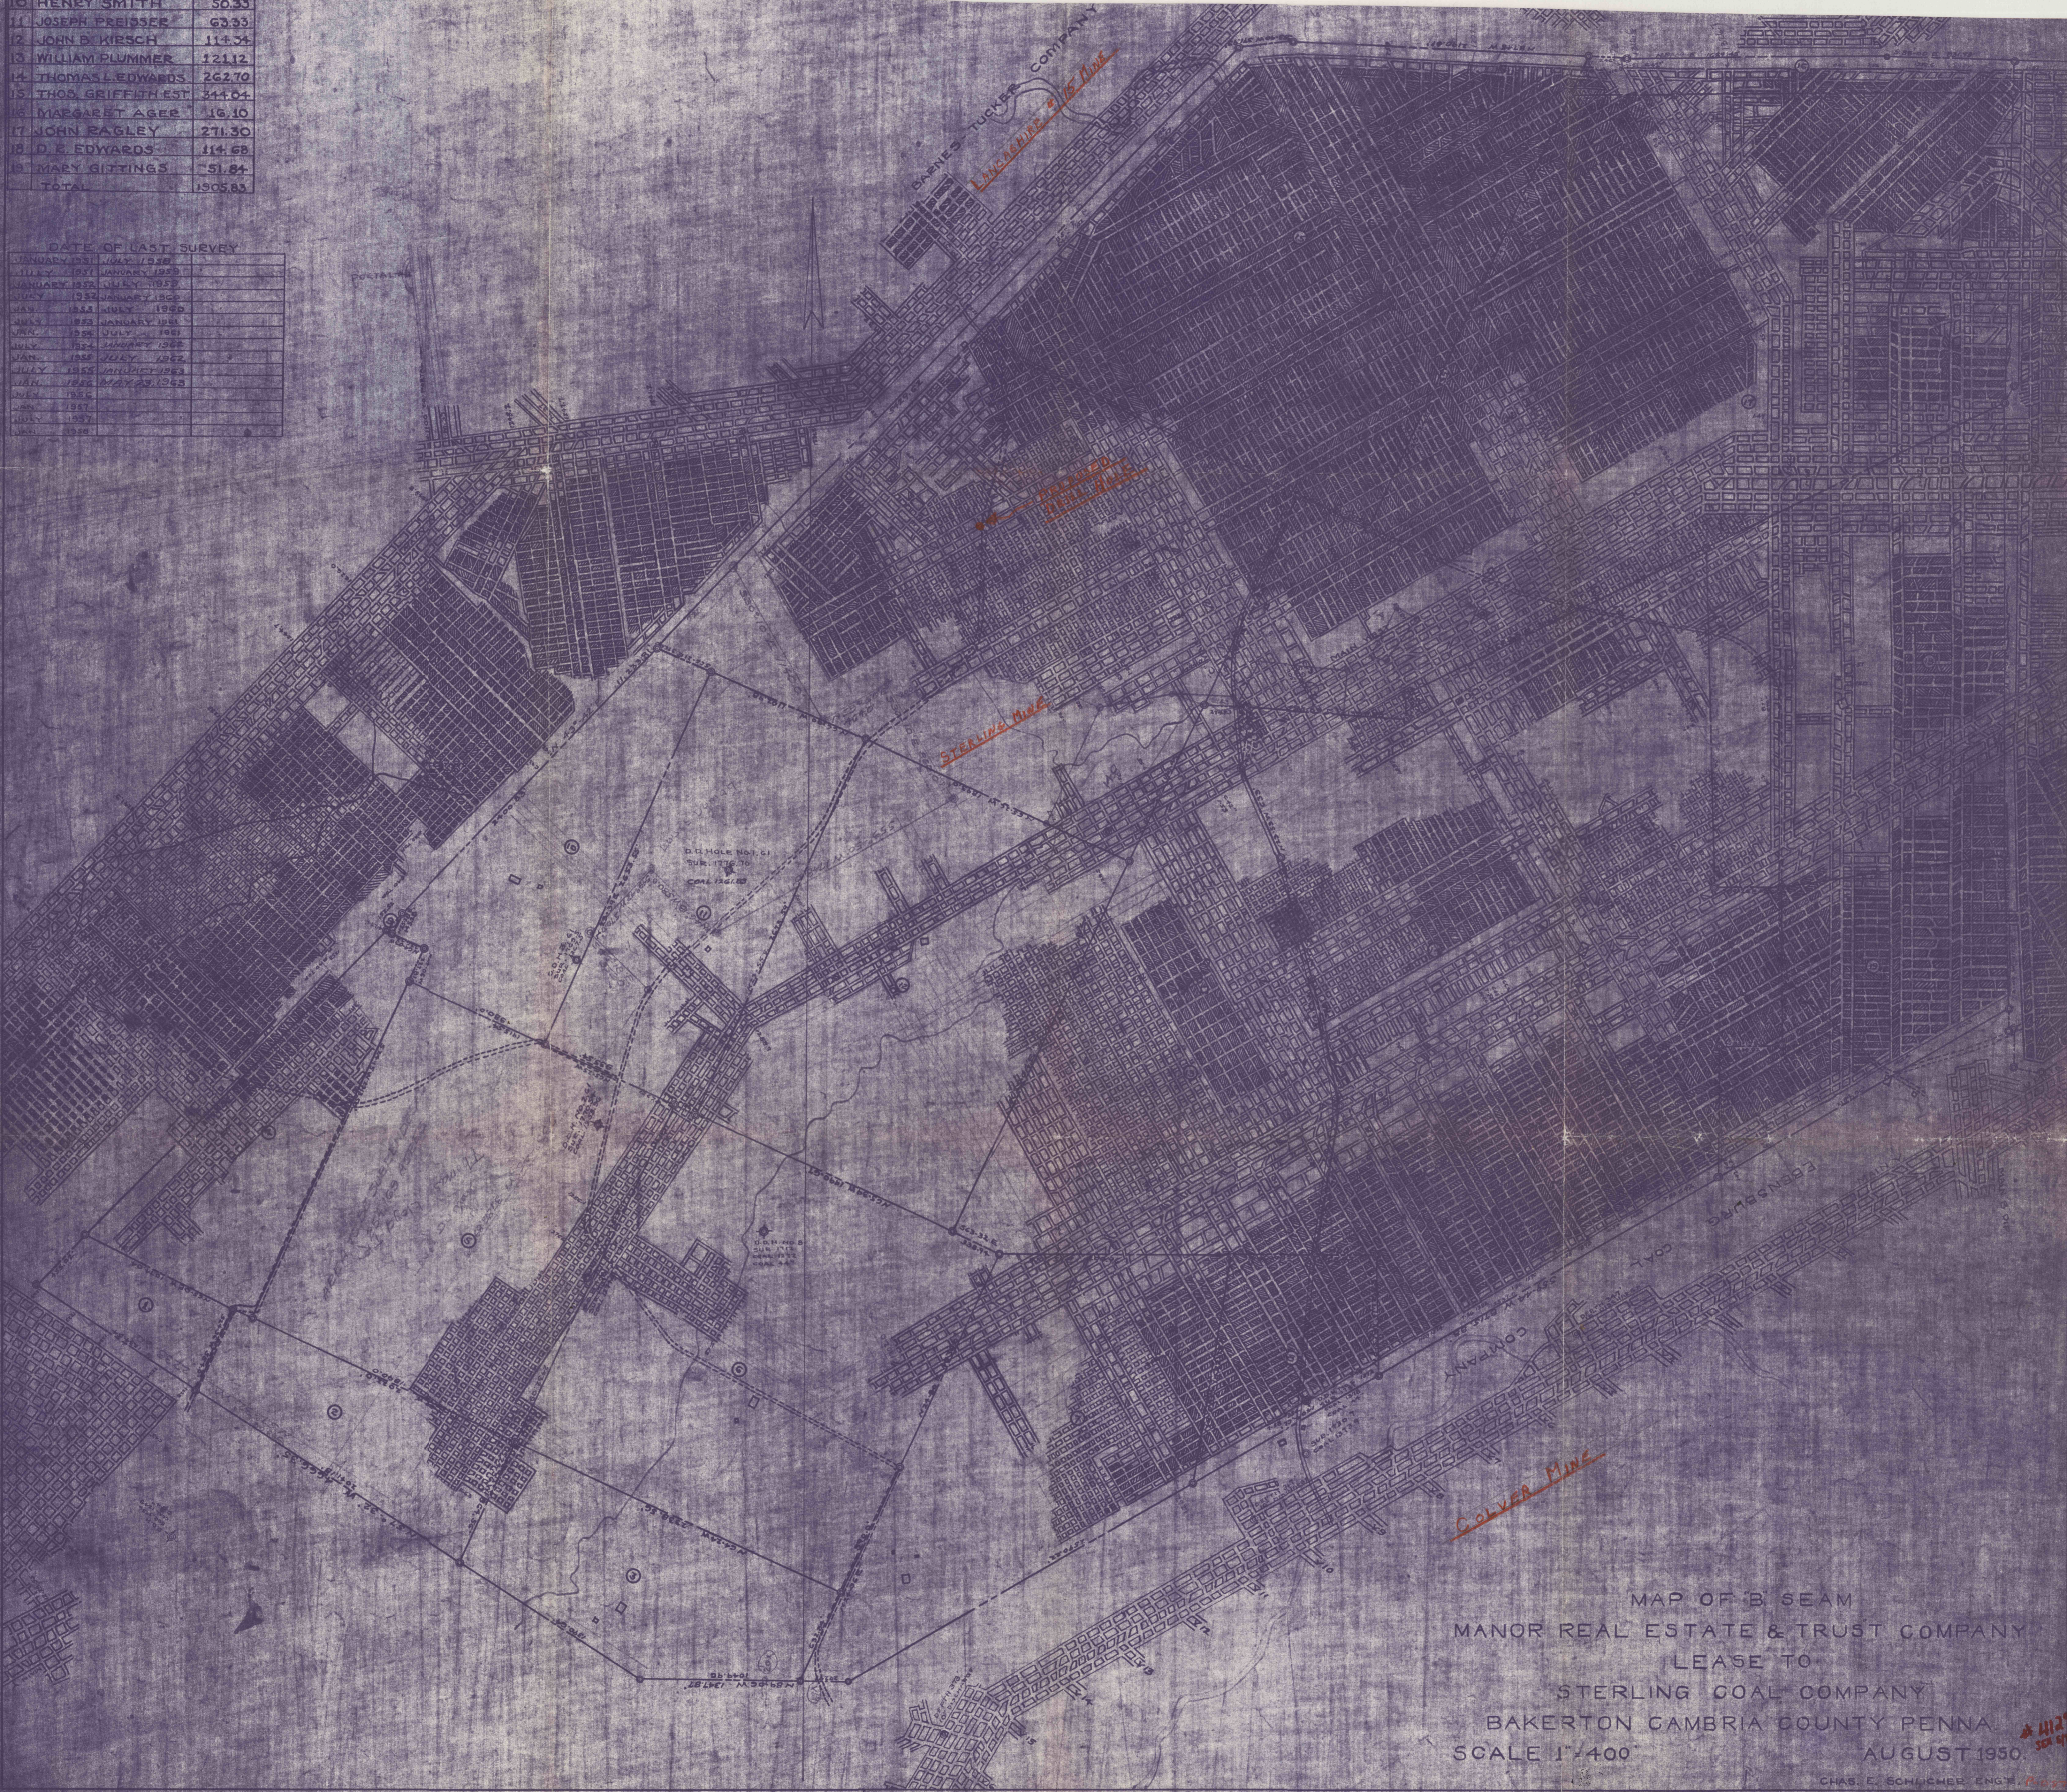

MAP OF 'B' SEAM  
 MANOR REAL ESTATE & TRUST COMPANY  
 LEASE TO  
 STERLING COAL COMPANY  
 BAKERTON GAMBRIA COUNTY PENNA.  
 SCALE 1"=400  
 AUGUST 1950