


4202

EMPIRE COAL MINING CO.

Colored in red
Cape & Savered Coal Area
Lenses & Tracts to be
leased to Burt location
Barnesboro Cambria Co. B
Exhibit A
A part of blue print sent to Mr
D. Sam Barnes & Tractor Co
22-4-11-11
27-15-23

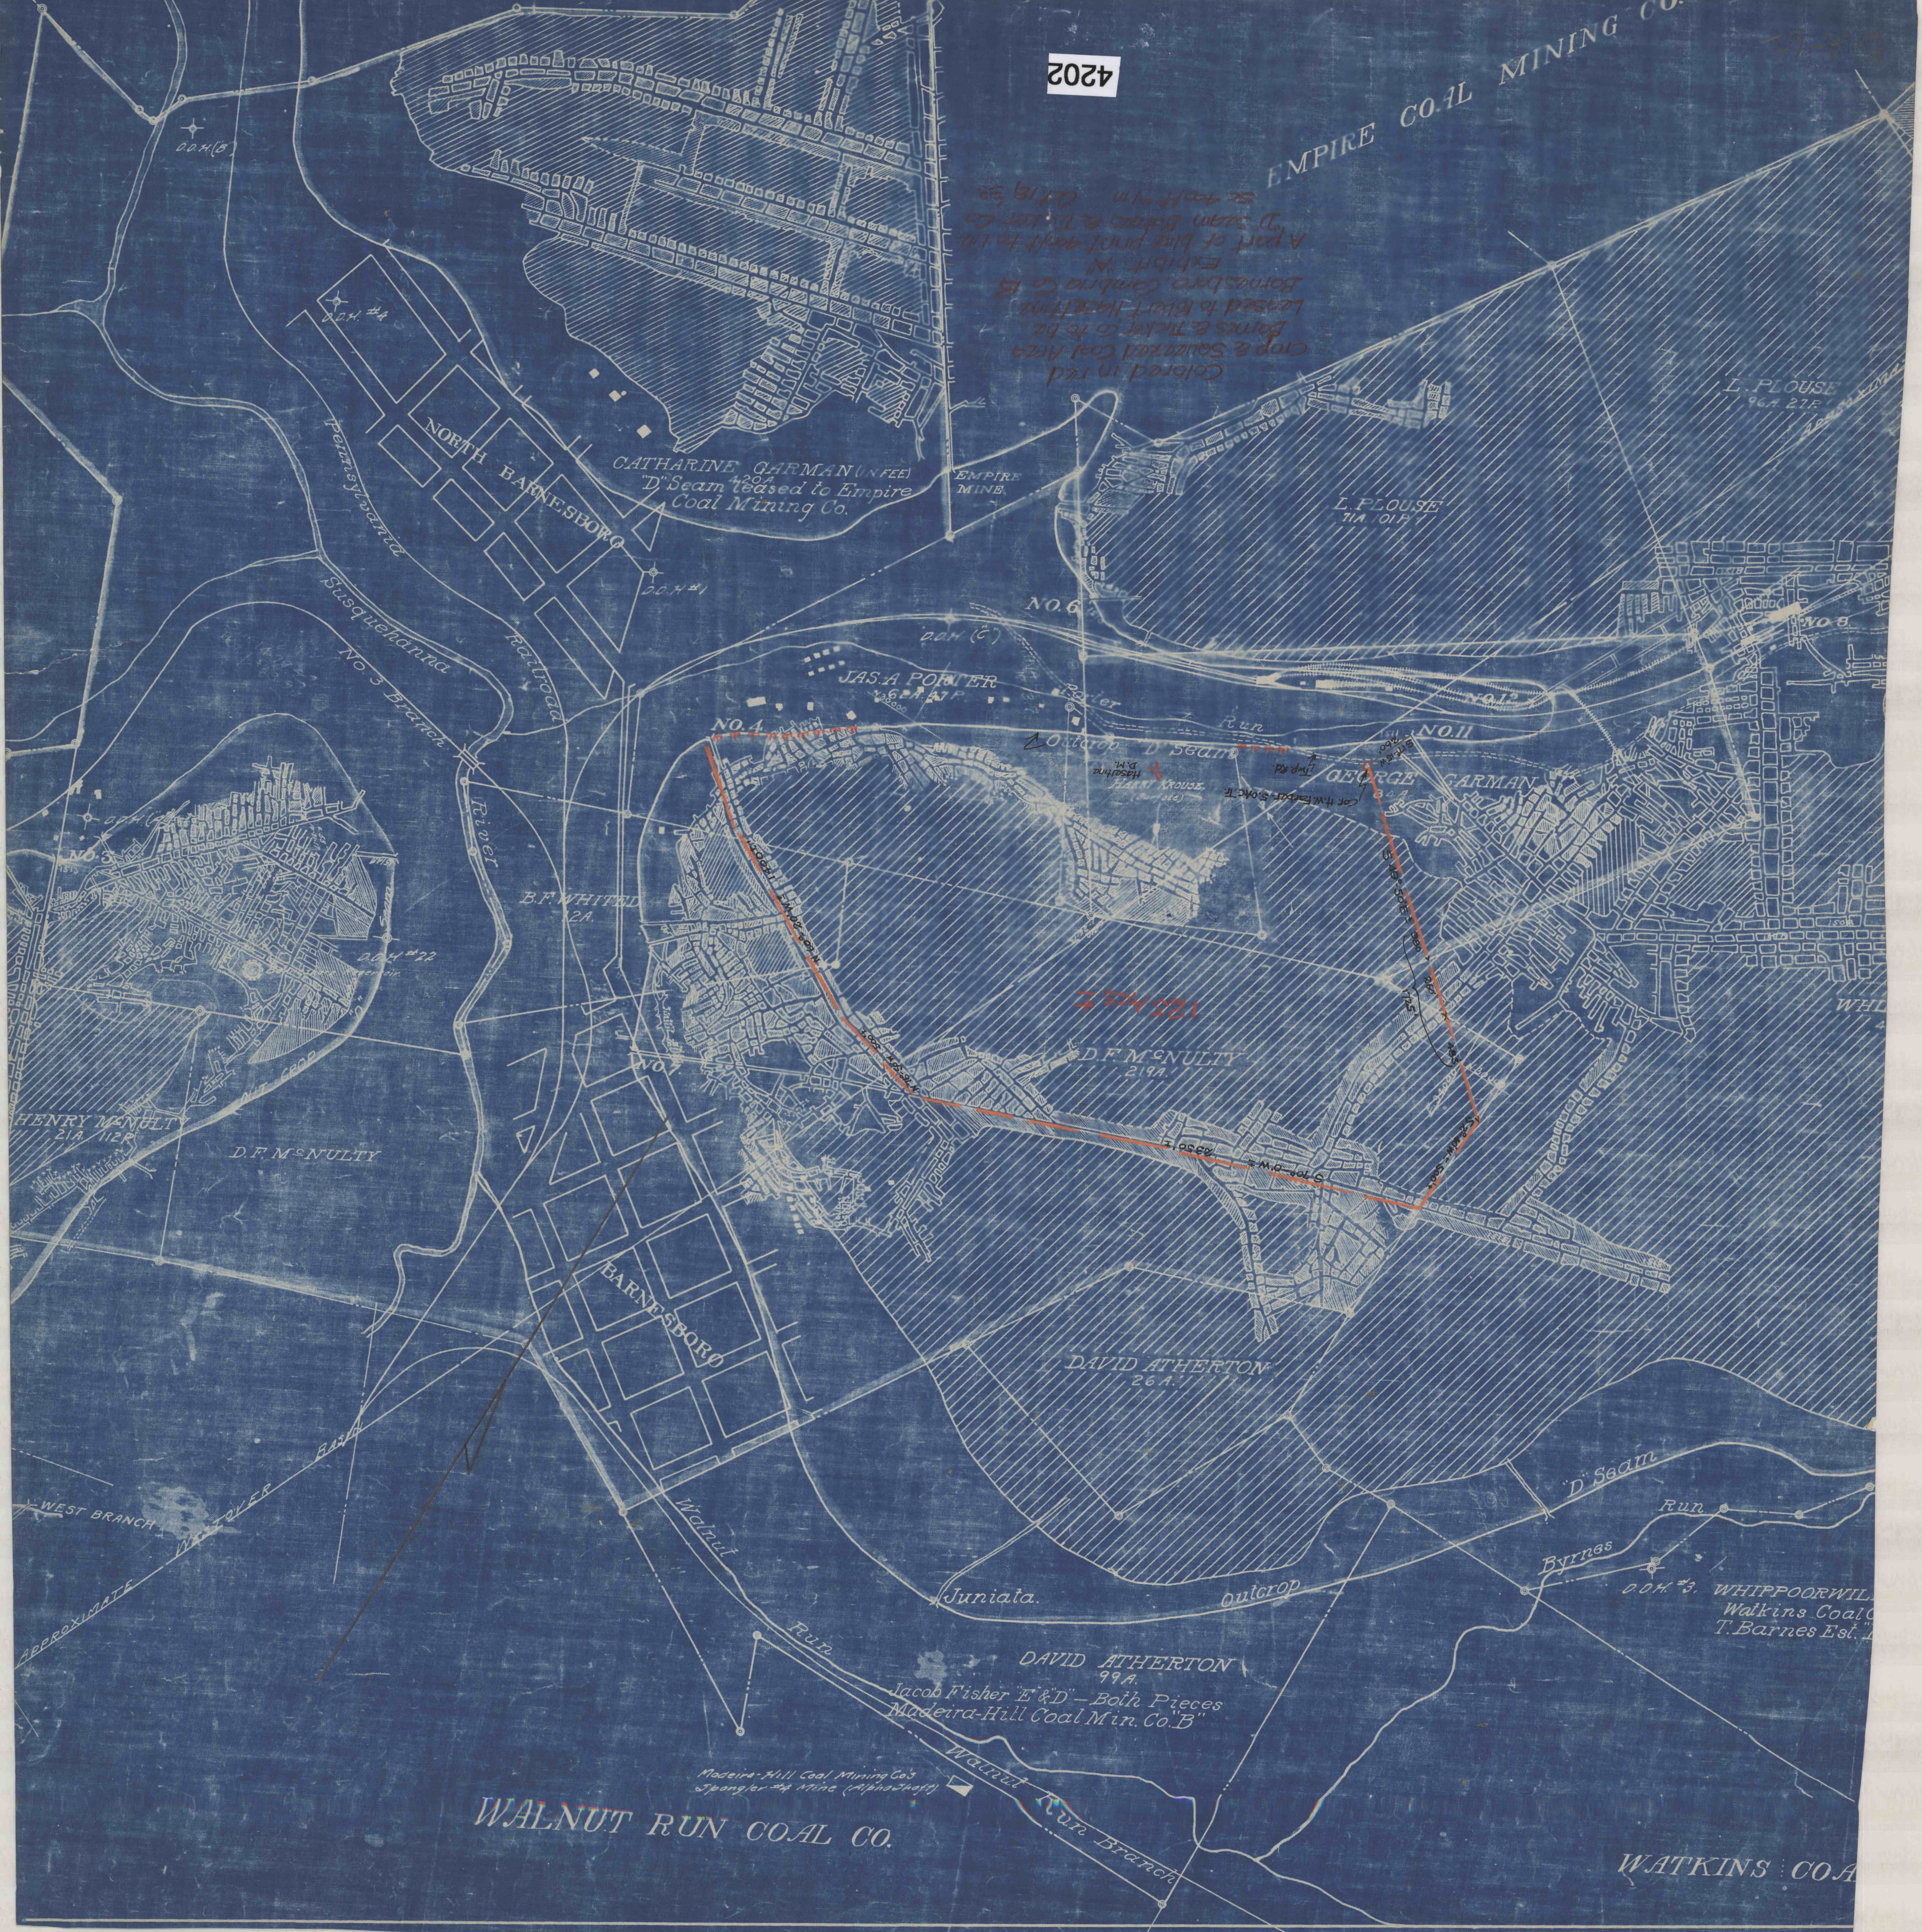

NORTH BARNESBORO
Susquehanna River
Perryville
Harpers

NO. 3
HENRY McNULTY
21A 112R
D.F. McNULTY

B.F. WHITE
2A
NO. 4
JAS. A. POMER
6A 41P
NO. 6
EMPIRE MINE

BARNESBORO
Walnut Run
Juniata

DAVID ATHERTON
26A
DAVID ATHERTON
99A
Jacob Fisher "E & D" - Both Pieces
Madeira-Hill Coal Min. Co. B
Madeira-Hill Coal Mining Co's
Spangler #4 Mine (Alpha shaft)

WALNUT RUN COAL CO.

L. PLOUSE
96A 27E
L. PLOUSE
71A 01P 1

NO. 11
GEORGE GARMAN
NO. 12
D.F. McNULTY
219A

DAVID ATHERTON
26A

Byrness Run
D Seam

WATKINS CO.

WATKINS CO.