


(E)

(E)

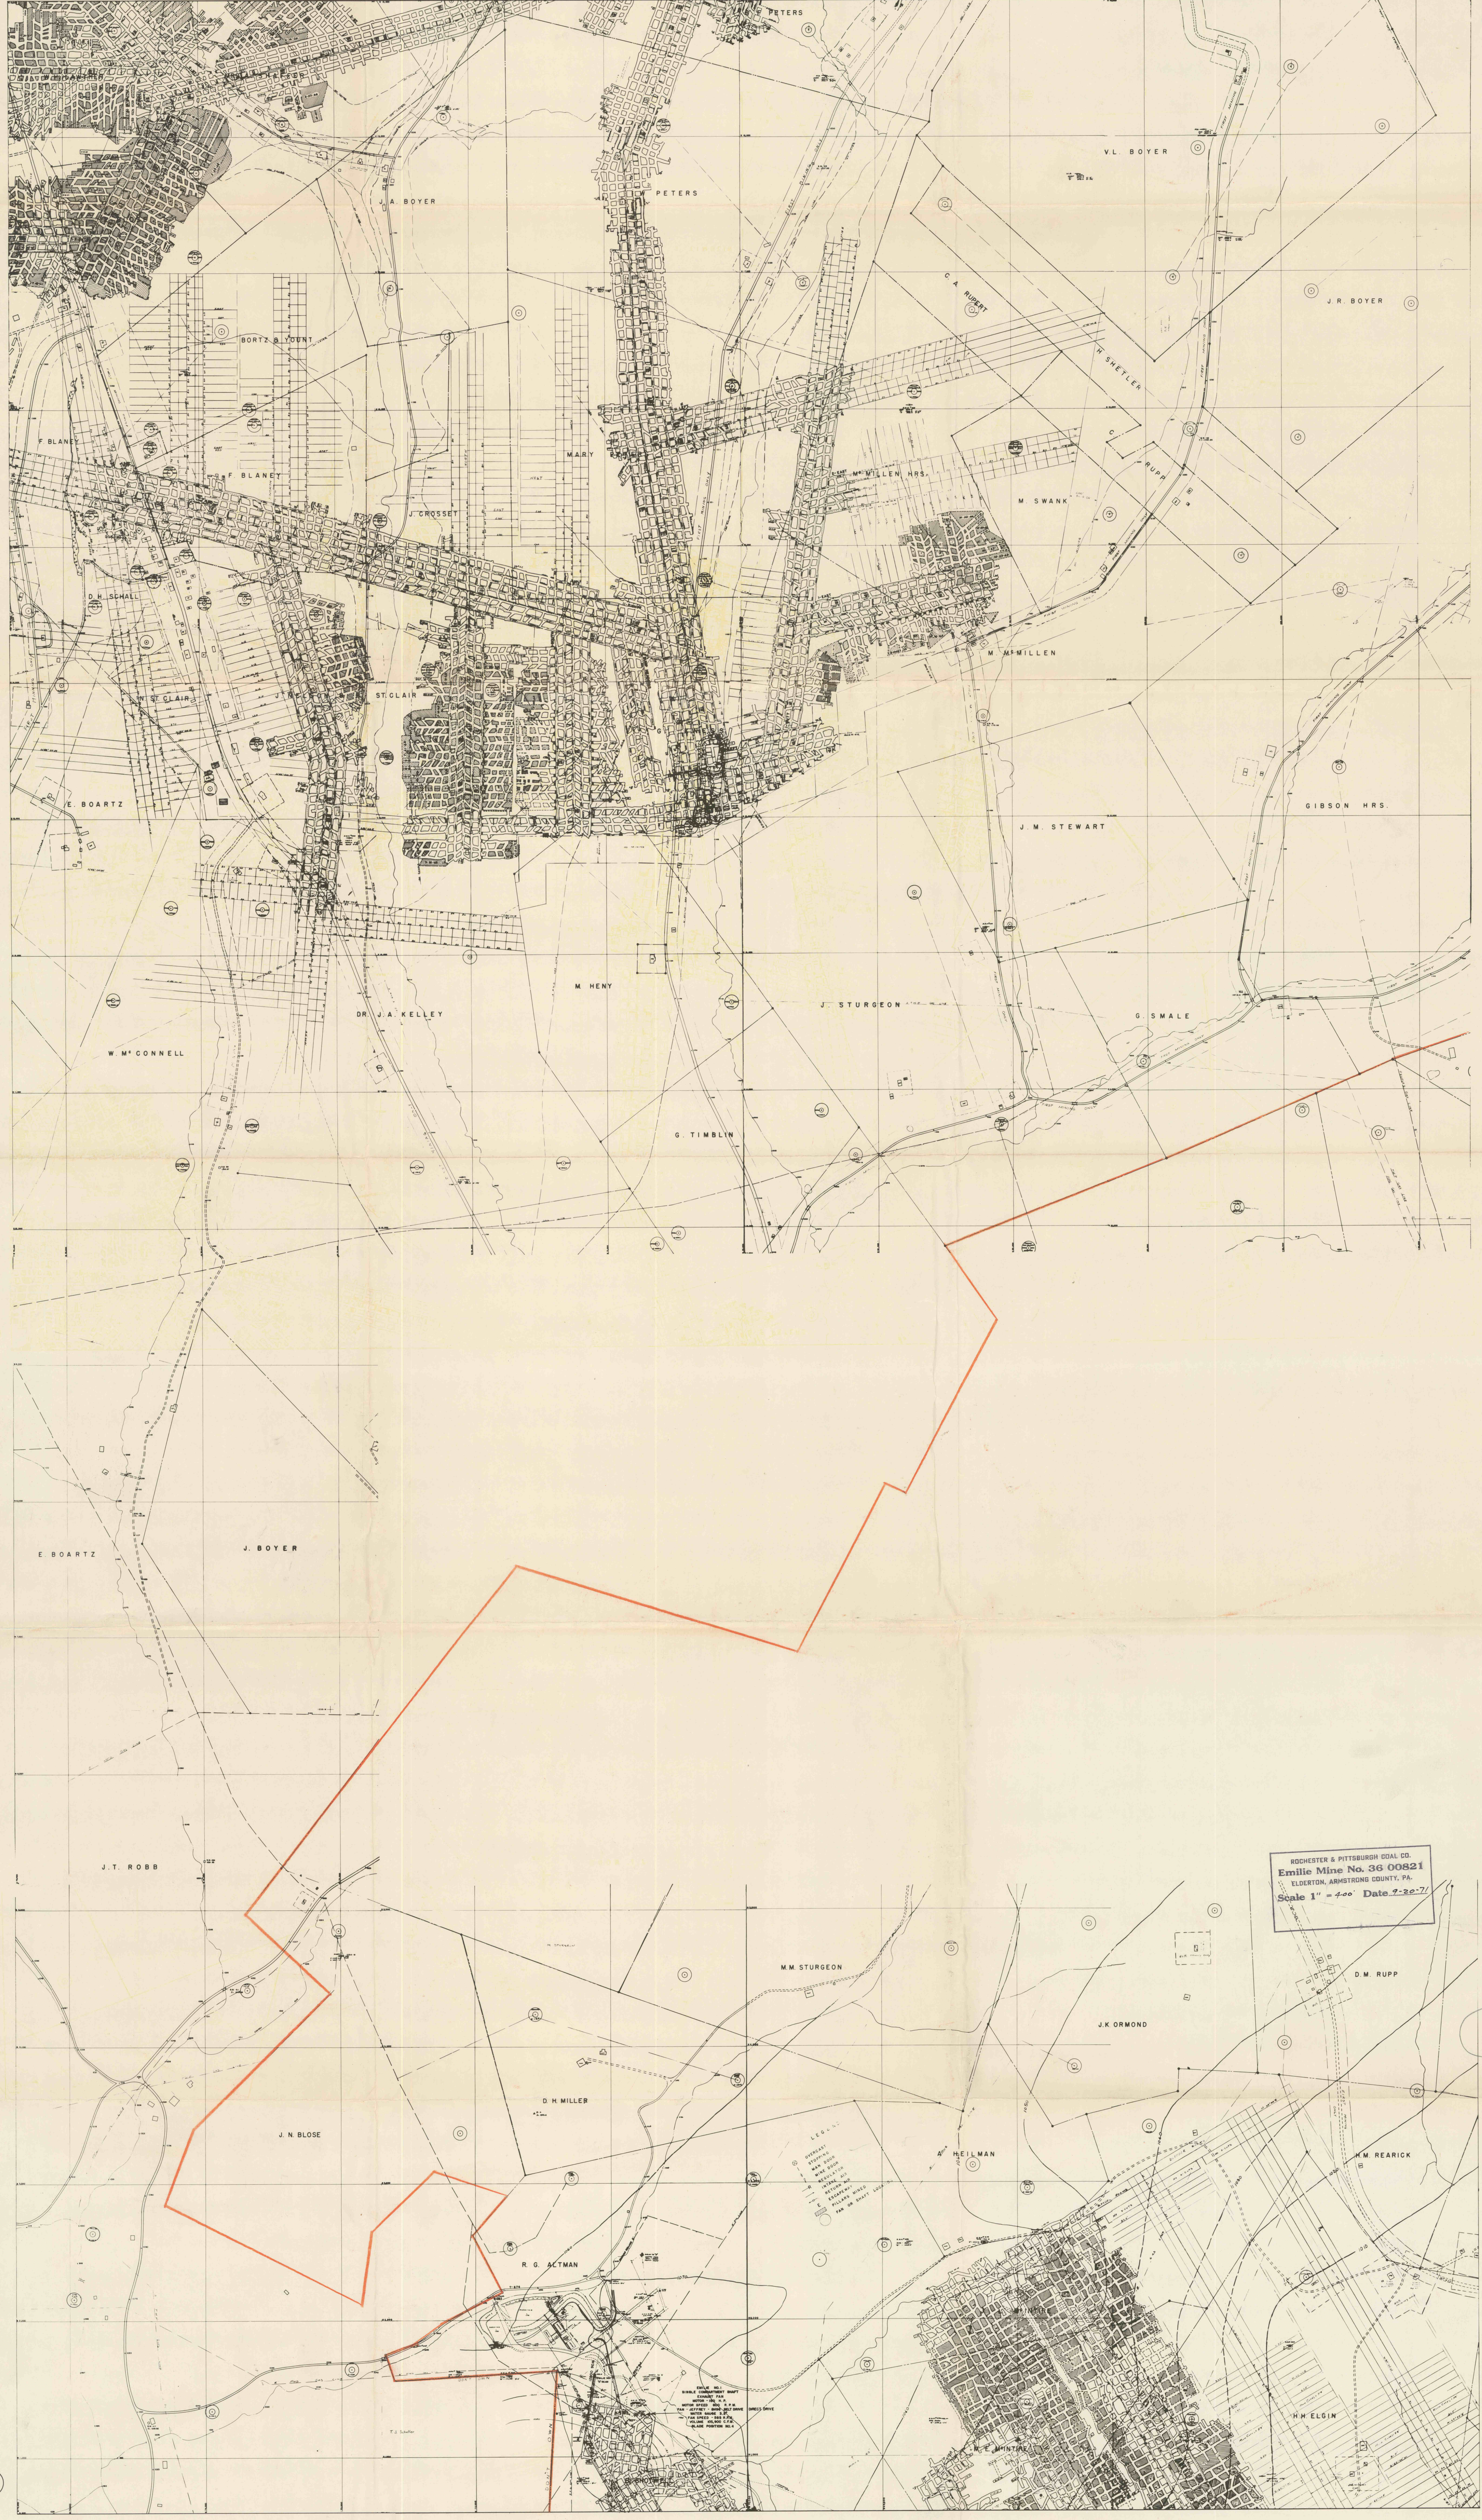

ROCHESTER & PITTSBURGH COAL CO.

(E-1)

(E)

(E)

1" = 400'
1:400