


KEY TO PREVIOUSLY MINED AREAS

MAP KEY	TYPE	STATUS	OPERATOR	PERMIT NO.	COAL SEAM
A	SURFACE	INACTIVE	DOVERSPRINGS BROS. COAL CO.	33820105	L.F.
B	SURFACE	INACTIVE	CLUE MINING CO., INC.	33820118	L.F., U.K., M.K.
C	SURFACE	INACTIVE	M.B. ENERGY, INC.	33820134	U.K., M.K.
D	SURFACE	INACTIVE	P&N COAL CO., INC.	33800114	L.K., M.K., U.K.
E	SURFACE	INACTIVE	P&N COAL CO., INC.	38705812	U.K.
F	SURFACE	INACTIVE	P&N COAL CO., INC.	38705813	L.K., M.K.
G	SURFACE	INACTIVE	CHARLES BERTAMINI	19579	M.K., L.K.
H	SURFACE	NOT ISSUED	VALLEY MINING	NOT ISSUED	L.F.
I	SURFACE	ABANDONED	HAMILTON MINING CO.	3630011	L.F.
J	SURFACE	ABANDONED	JOHN PHILLIPS	ABANDONED	L.F.
K	SURFACE	ABANDONED	GLEN IRVIN CORP.	39745M40	L.F.
U	UNDERGROUND	ACTIVE	DOVERSPRINGS BROS. COAL CO.	33841303	L.K.
Y	UNDERGROUND	ABANDONED	W.P.A. 5-7-6	W.P.A.	L.F.
W	UNDERGROUND	ABANDONED	LINDSEY COAL MINING CO.	9011	L.F.
X	UNDERGROUND	ABANDONED	PERRY HILLS COAL CO.	W.P.A. 5-7-6	L.F.
Y	UNDERGROUND	ABANDONED	VALLEY MINING CO., INC.	3646031	L.F.
Z	UNDERGROUND	ABANDONED	PANSY COAL CO.	W.P.A. 5-7-6	L.F.

DORA 8 MINE

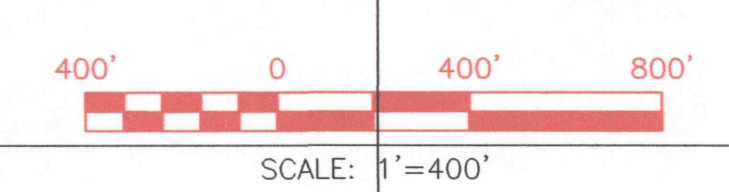

IP #1
N 580481.57
E 1597475.19
Elev. 1447.20
A