


I:\Engineering\BURRELL\Burrell1 Mine\Current.dwg\Main Base.dwg Fri Aug 09 12:26:41 2002

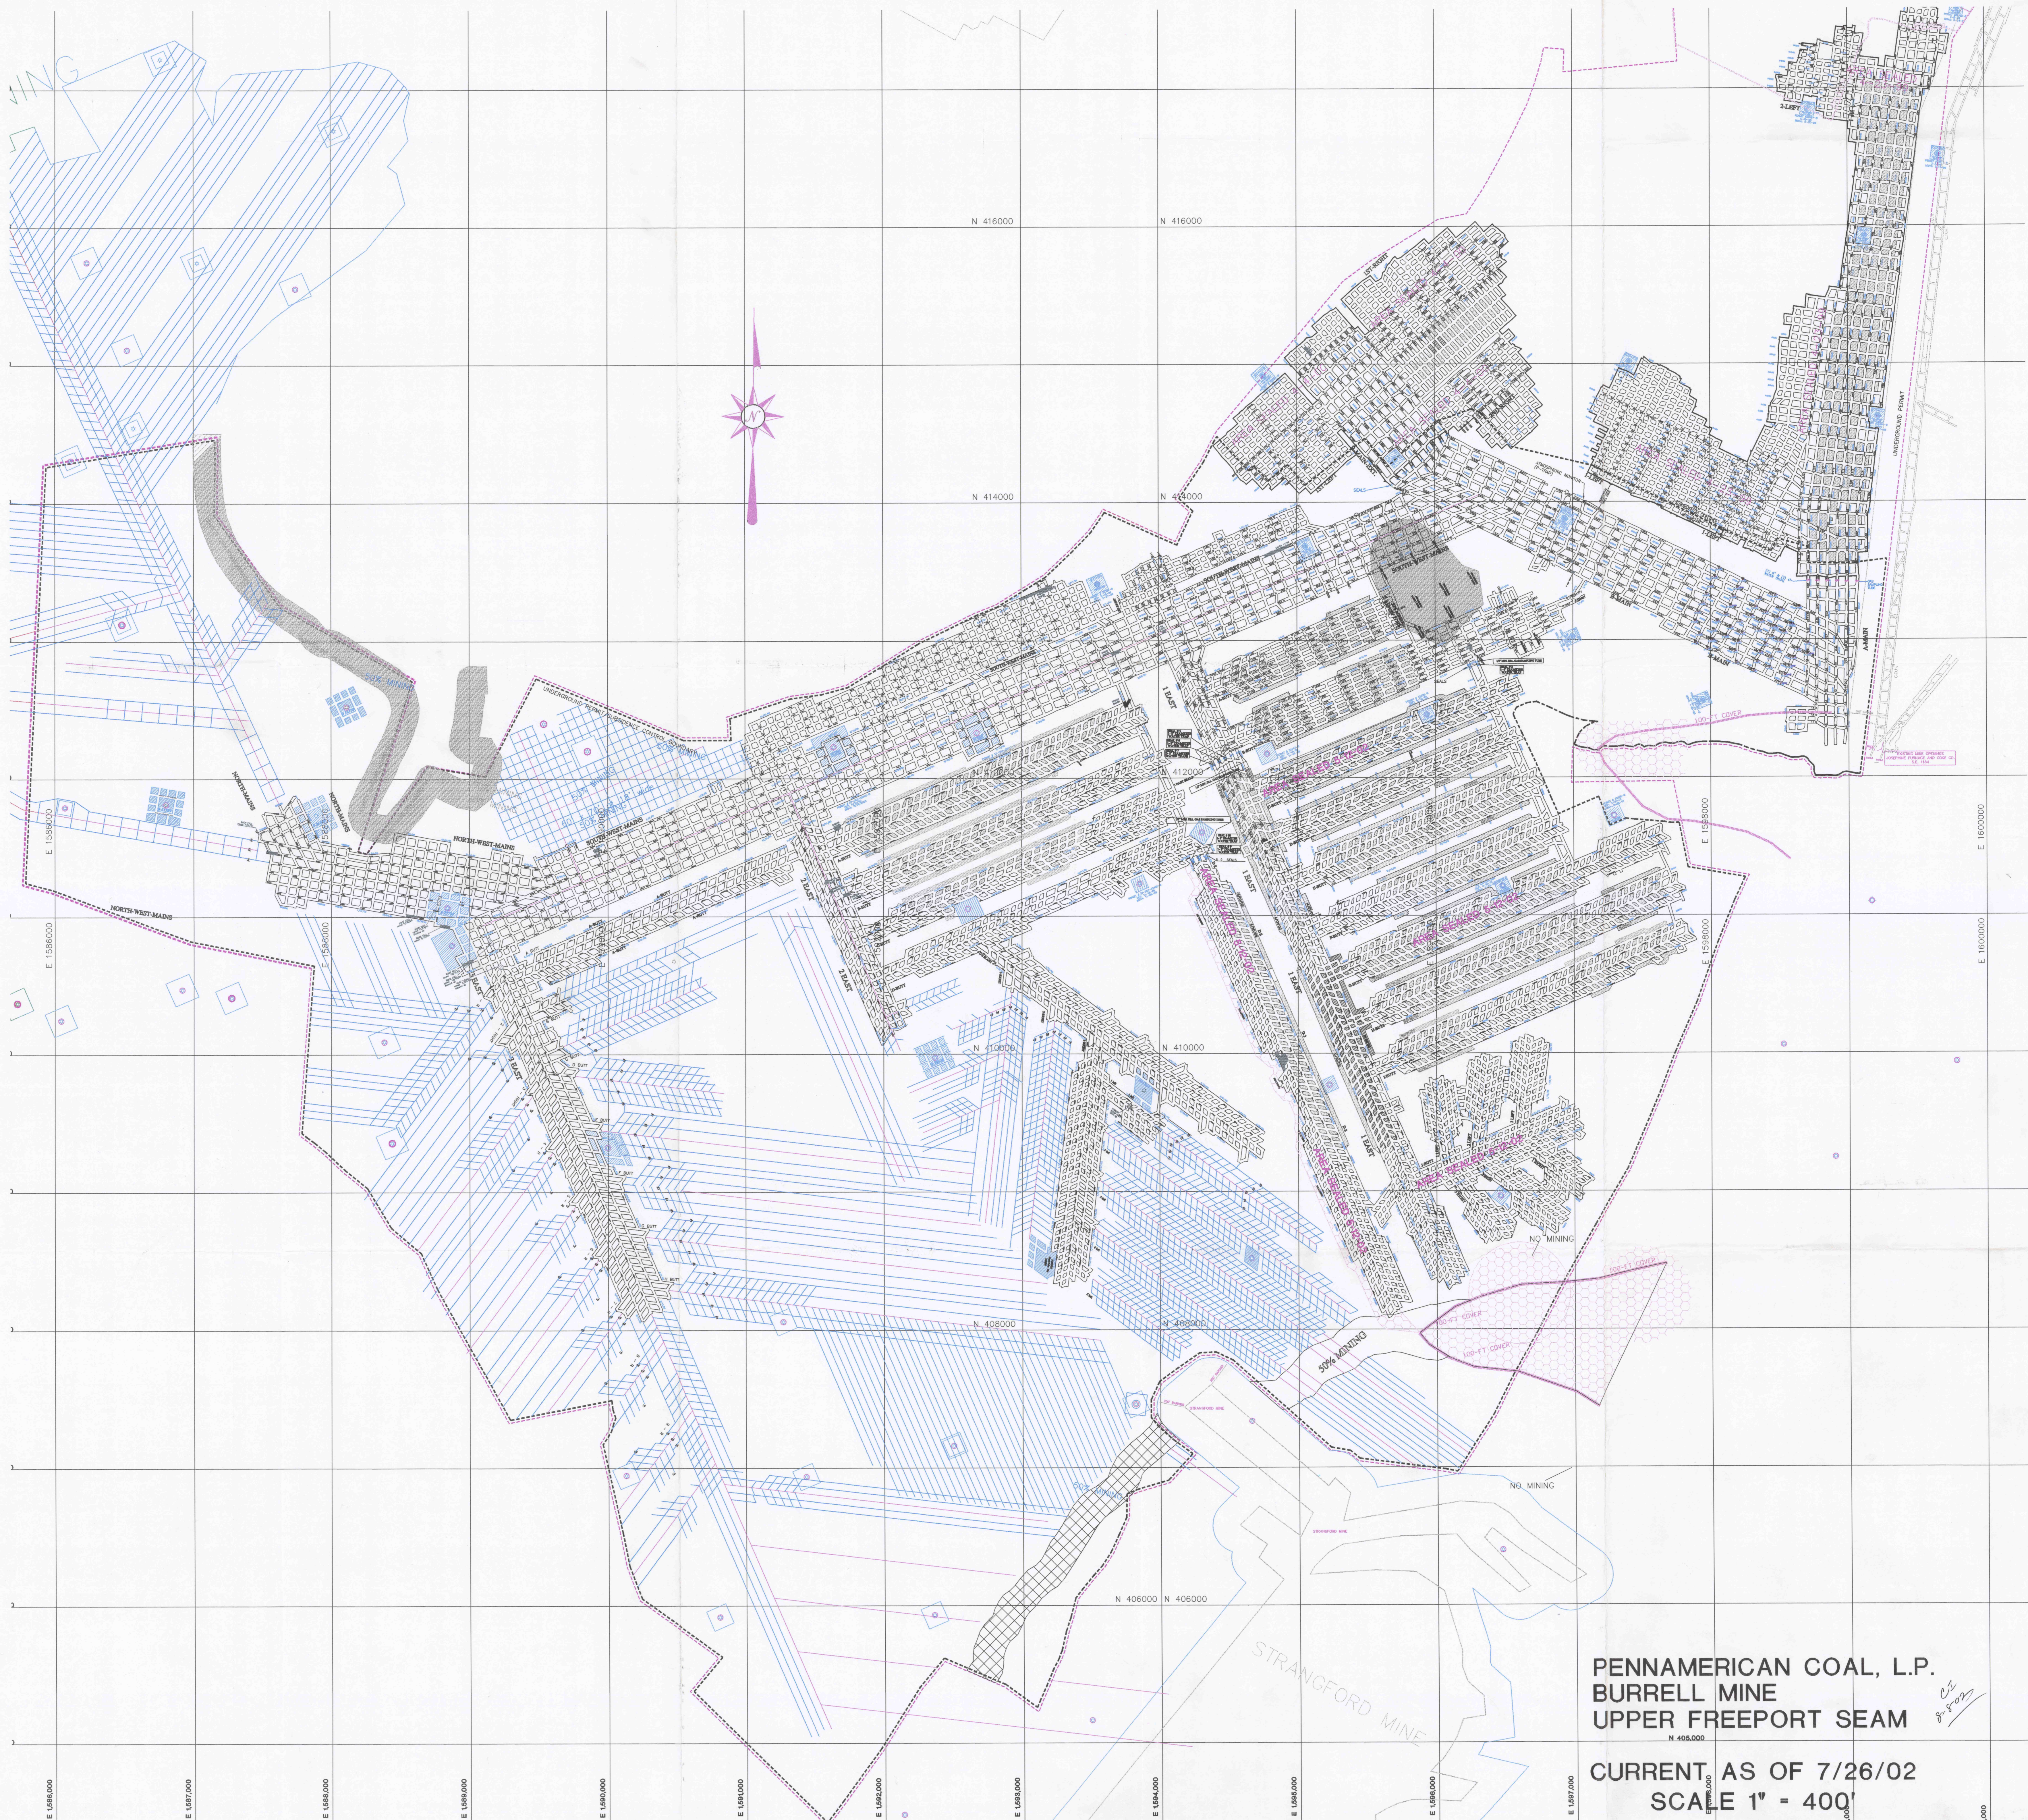

PENNAMERICAN COAL, L.P.
BURRELL MINE
UPPER FREEPORT SEAM

CURRENT AS OF 7/26/02
SCALE 1" = 400'

CS
8/2/02

E 1586000 E 1587000 E 1588000 E 1589000 E 1590000 E 1591000 E 1592000 E 1593000 E 1594000 E 1595000 E 1596000 E 1597000 E 1598000 E 1599000 E 1600000

N 408000 N 409000 N 410000 N 411000 N 412000 N 413000 N 414000 N 415000 N 416000