

SCALE 1" = 400'


MATCH LINE TO SHEET 4

**LEGEND**

18 ACRE AMENDMENT  
 PERMIT AREA 3257.4 ACRES  
 SUBSIDENCE CONTROL PLAN BOUNDARY - - - - - 3133.5 ACRES  
 25' ANGLE OF DRAIN LINE  
 COAL OUTCROP ON UPPER KITTANNING SEAM  
 STRUCTURE CONTOUR ON UPPER KITTANNING SEAM 1710  
 STREAMS, LAKES, SPRINGS  
 TELEPHONE LINES  
 POWER LINES  
 TREE LINES  
 DRILL HOLES

PONDS  
 RAILROADS  
 WELLS  
 BACKGROUND SAMPLE POINTS  
 PUBLIC ROADS  
 PRIVATE ACCESS ROADS  
 SURFACE PROPERTY LINES  
 SURFACE OWNER: James D. Stahl SUBSURFACE OWNER: D15 DAY D E. MAXWELL  
 50% MINING AREAS

RESERVATION AREAS  
 BUILDINGS (CURRENT USE OF BUILDINGS IS LISTED IN THE APPLICATION.)  
 (POST #1966# STRUCTURES ARE DENOTED WITH "AA" AFTER THE NUMBER OF THE STRUCTURE.)

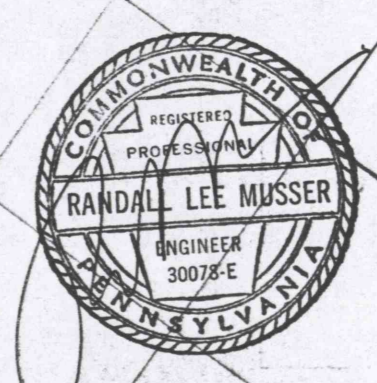

Last Mining 3-15-99 FINAL MAP  
 19/3 Subsidence Control Plan Map

SOLAR FUEL COMPANY  
 SOLAR NO. 10 MINE  
 QUEMAHONING TWP., SOMERSET CO., PA

SCALE: 1" = 400' DATE: FEB 04 2001  
 Original by: Earthtech  
 Revised by: Musser Engineering

RECEIVED  
 FEB 05 2001

REVISION 2 SHEET 3 OF 4