


MATCH TO 5

MATCH TO 20




POSTED
NOV 30 1999

FINAL MINE MAP

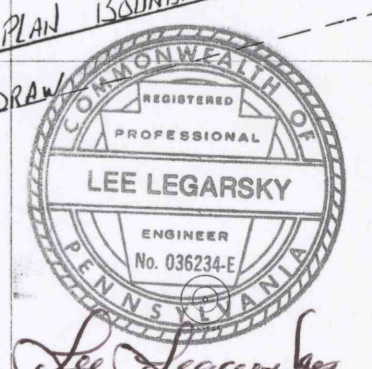

400 0 400 800
scale feet

Urging No. 1 Mine Lower Freeport D'Seam
Keystone Coal Mining Corp.
Indiana Co., Indiana

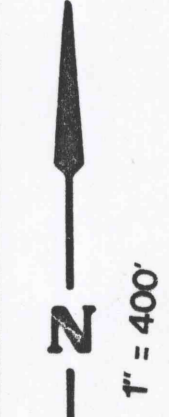

MATCH TO 9